



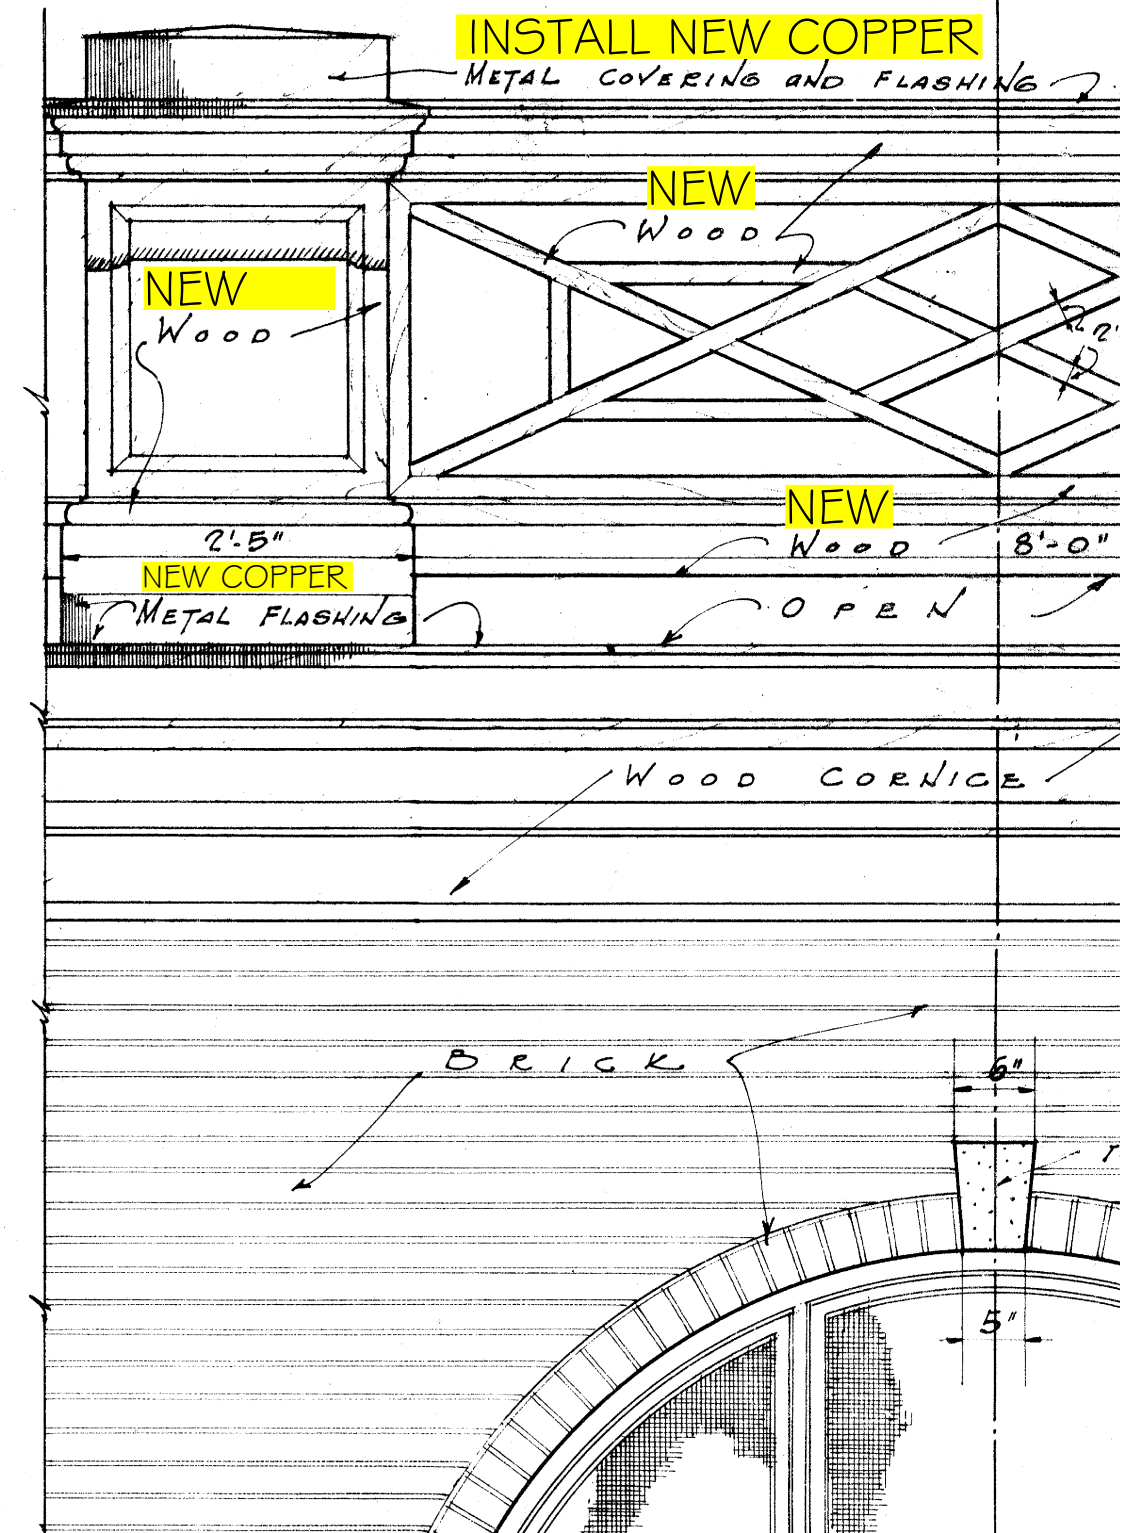

“A”

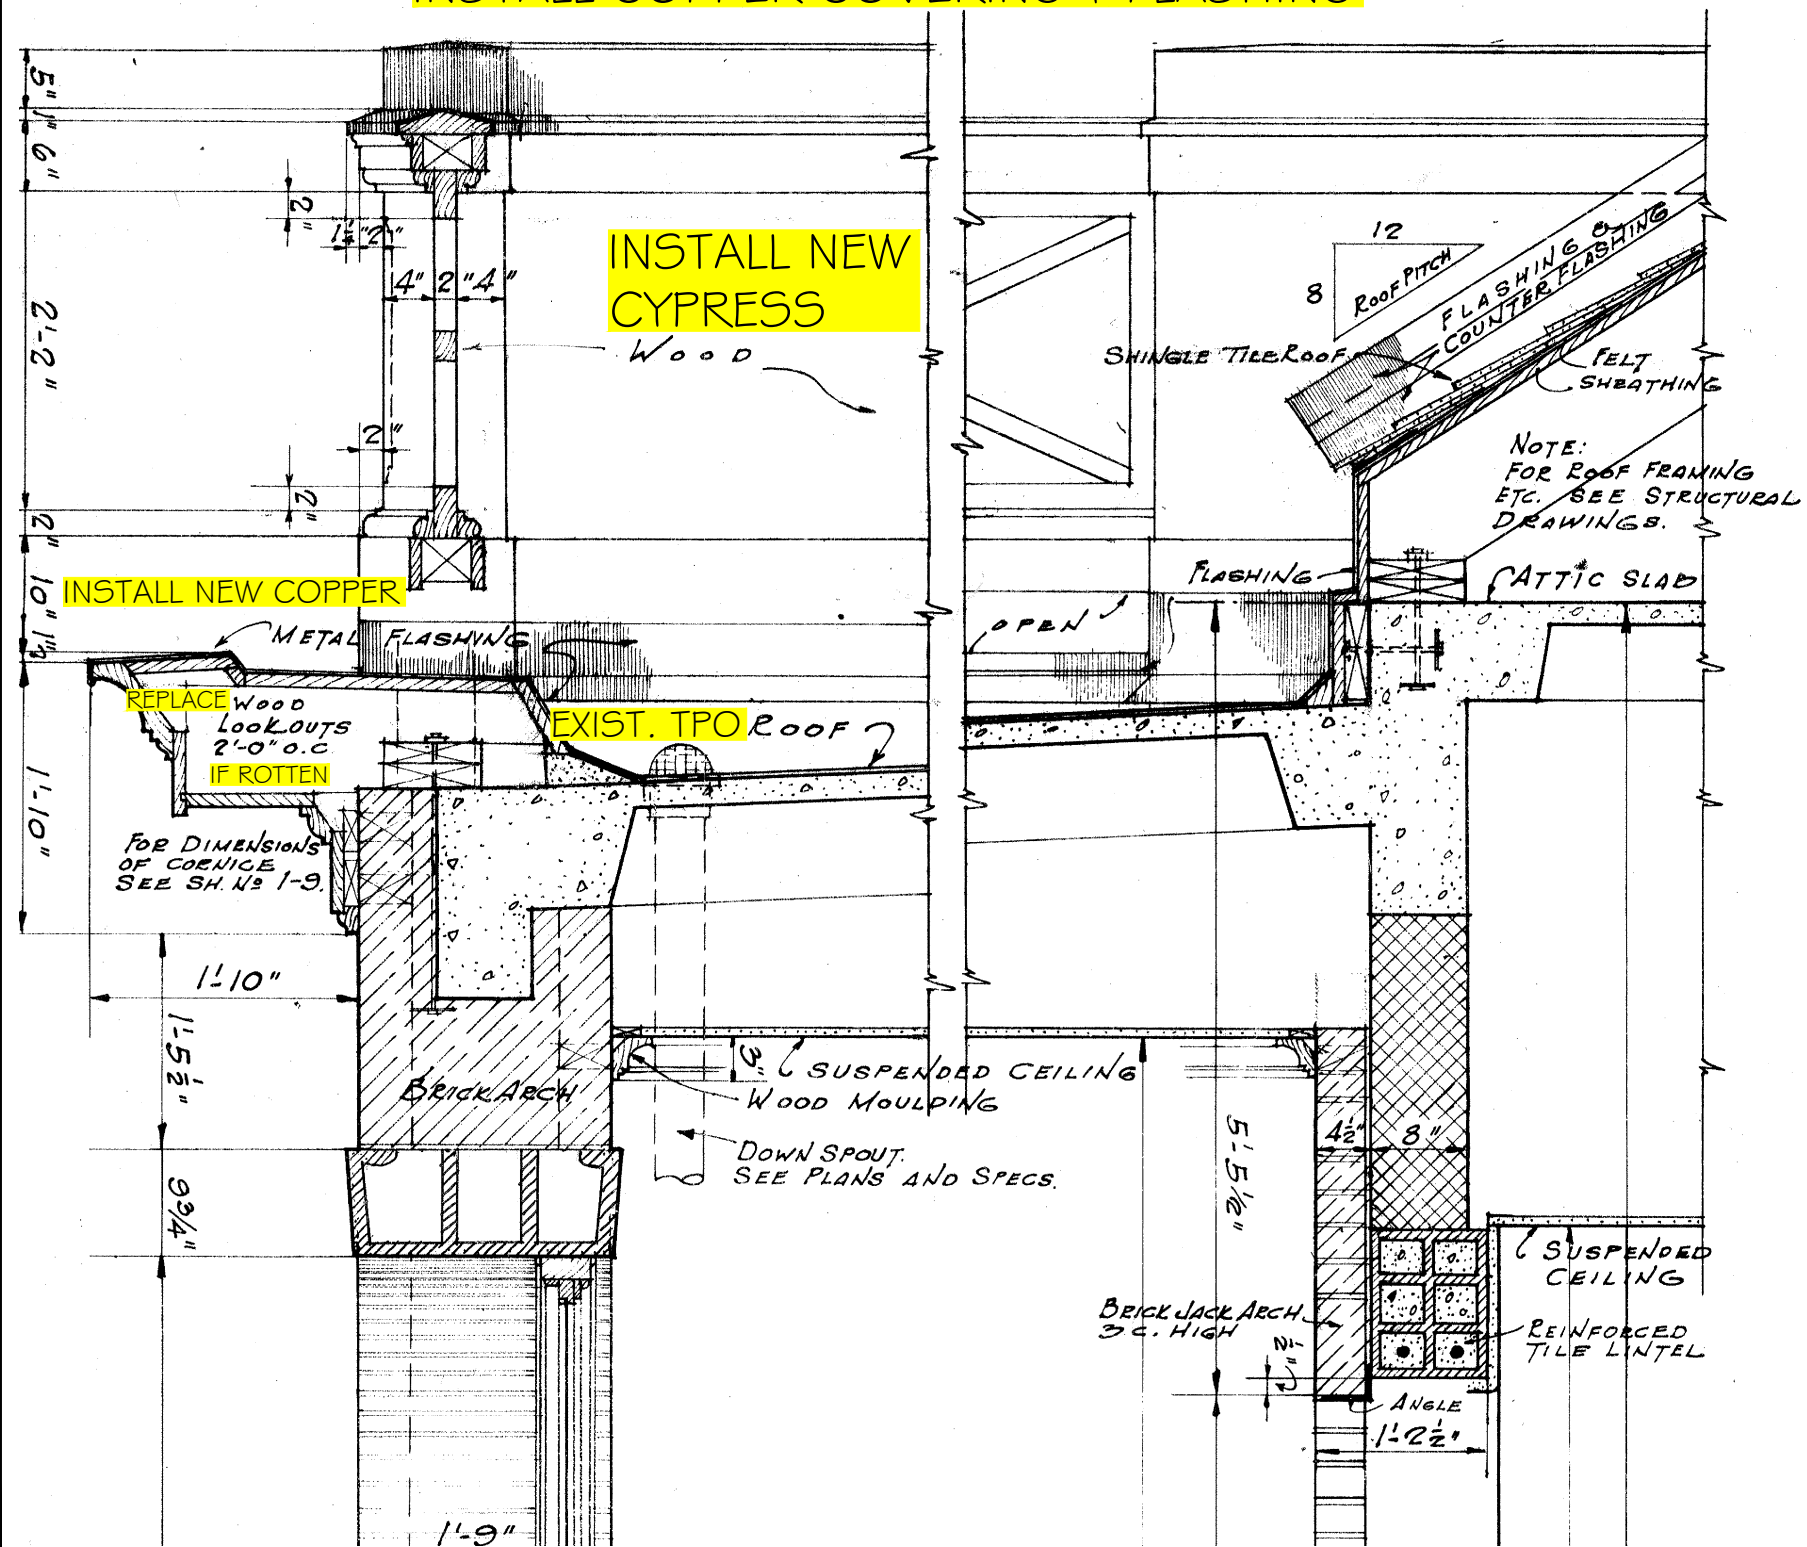

		Approved: VHSO Associate Director	Project Title Replace Balustrades and Railings Building One		Drawing Title ROOF SECTION "D" ELEVATION			Project Number 564-12-115D		Engineering Service  VETERANS HEALTH CARE SYSTEM OF THE OZARKS
							Building Number 01 (ONE)			
		Approved: Engineering Service Chief	One inch or not to scale!	Scale:	Location Fayetteville, Arkansas		Drawing Number AE501			
				3/4" = 1'-0"	Checked JCH	Drawn ENG	Date 20120704	Sheet 2 of 2		
Notes and/or Revisions:		Date								

CUSTOM VA FORM 08-6231B, MAY 2012