




B95  
PATIO  
REVISION

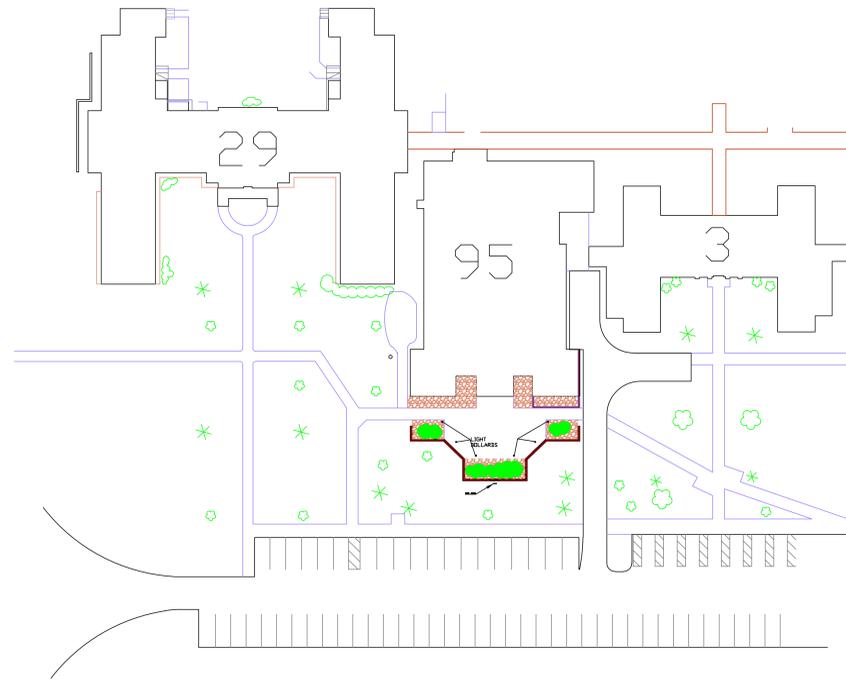

EXISTING

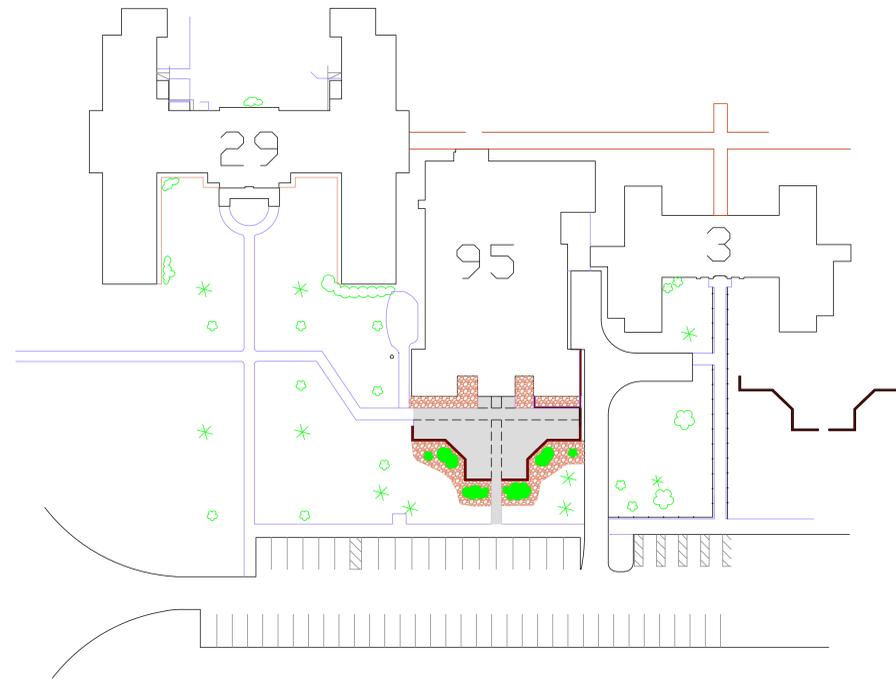

PROPOSED

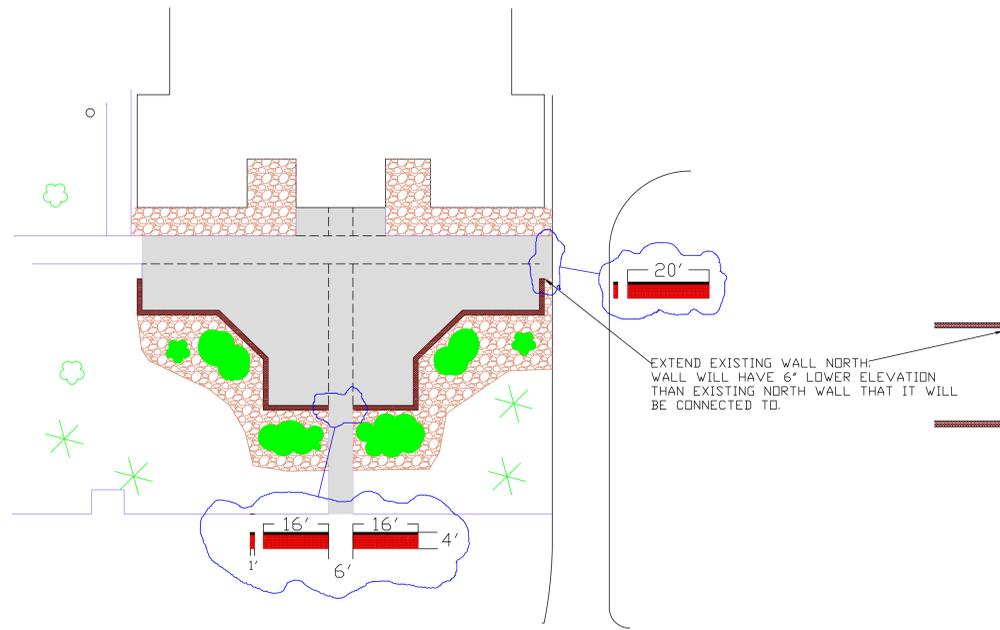

No.	REVISION	DATE

APPROVED SERVICE LINE DIRECTOR	DATE	APPROVED INFECTION CONTROL NURSE	DATE	DRAWING TITLE	PROJECT TITLE	DATE
APPROVED GEAR COORDINATOR	DATE	APPROVED PATIENT SAFETY	DATE	Building 95 Patio	Replace Deteriorated Sidewalk	PROJECT SCALE NOT SCALED
APPROVED PROJECTS SECTION MANAGER	DATE	APPROVED CHIEF OF POLICE	DATE	APPROVED CHIEF OF STAFF	BUILDING NO.	CHECKED BY
APPROVED DIRECTOR FMO	DATE	APPROVED SAFETY MANAGER	DATE	APPROVED MEDICAL CENTER DIRECTOR	SITE	MAN RLC
					VA-MEDICAL CENTER	DATE FILED
					ST. CLOUD, VA 22683	VA-SITE
						DWG. NO. 1039
						DWG. 12 of 15

