


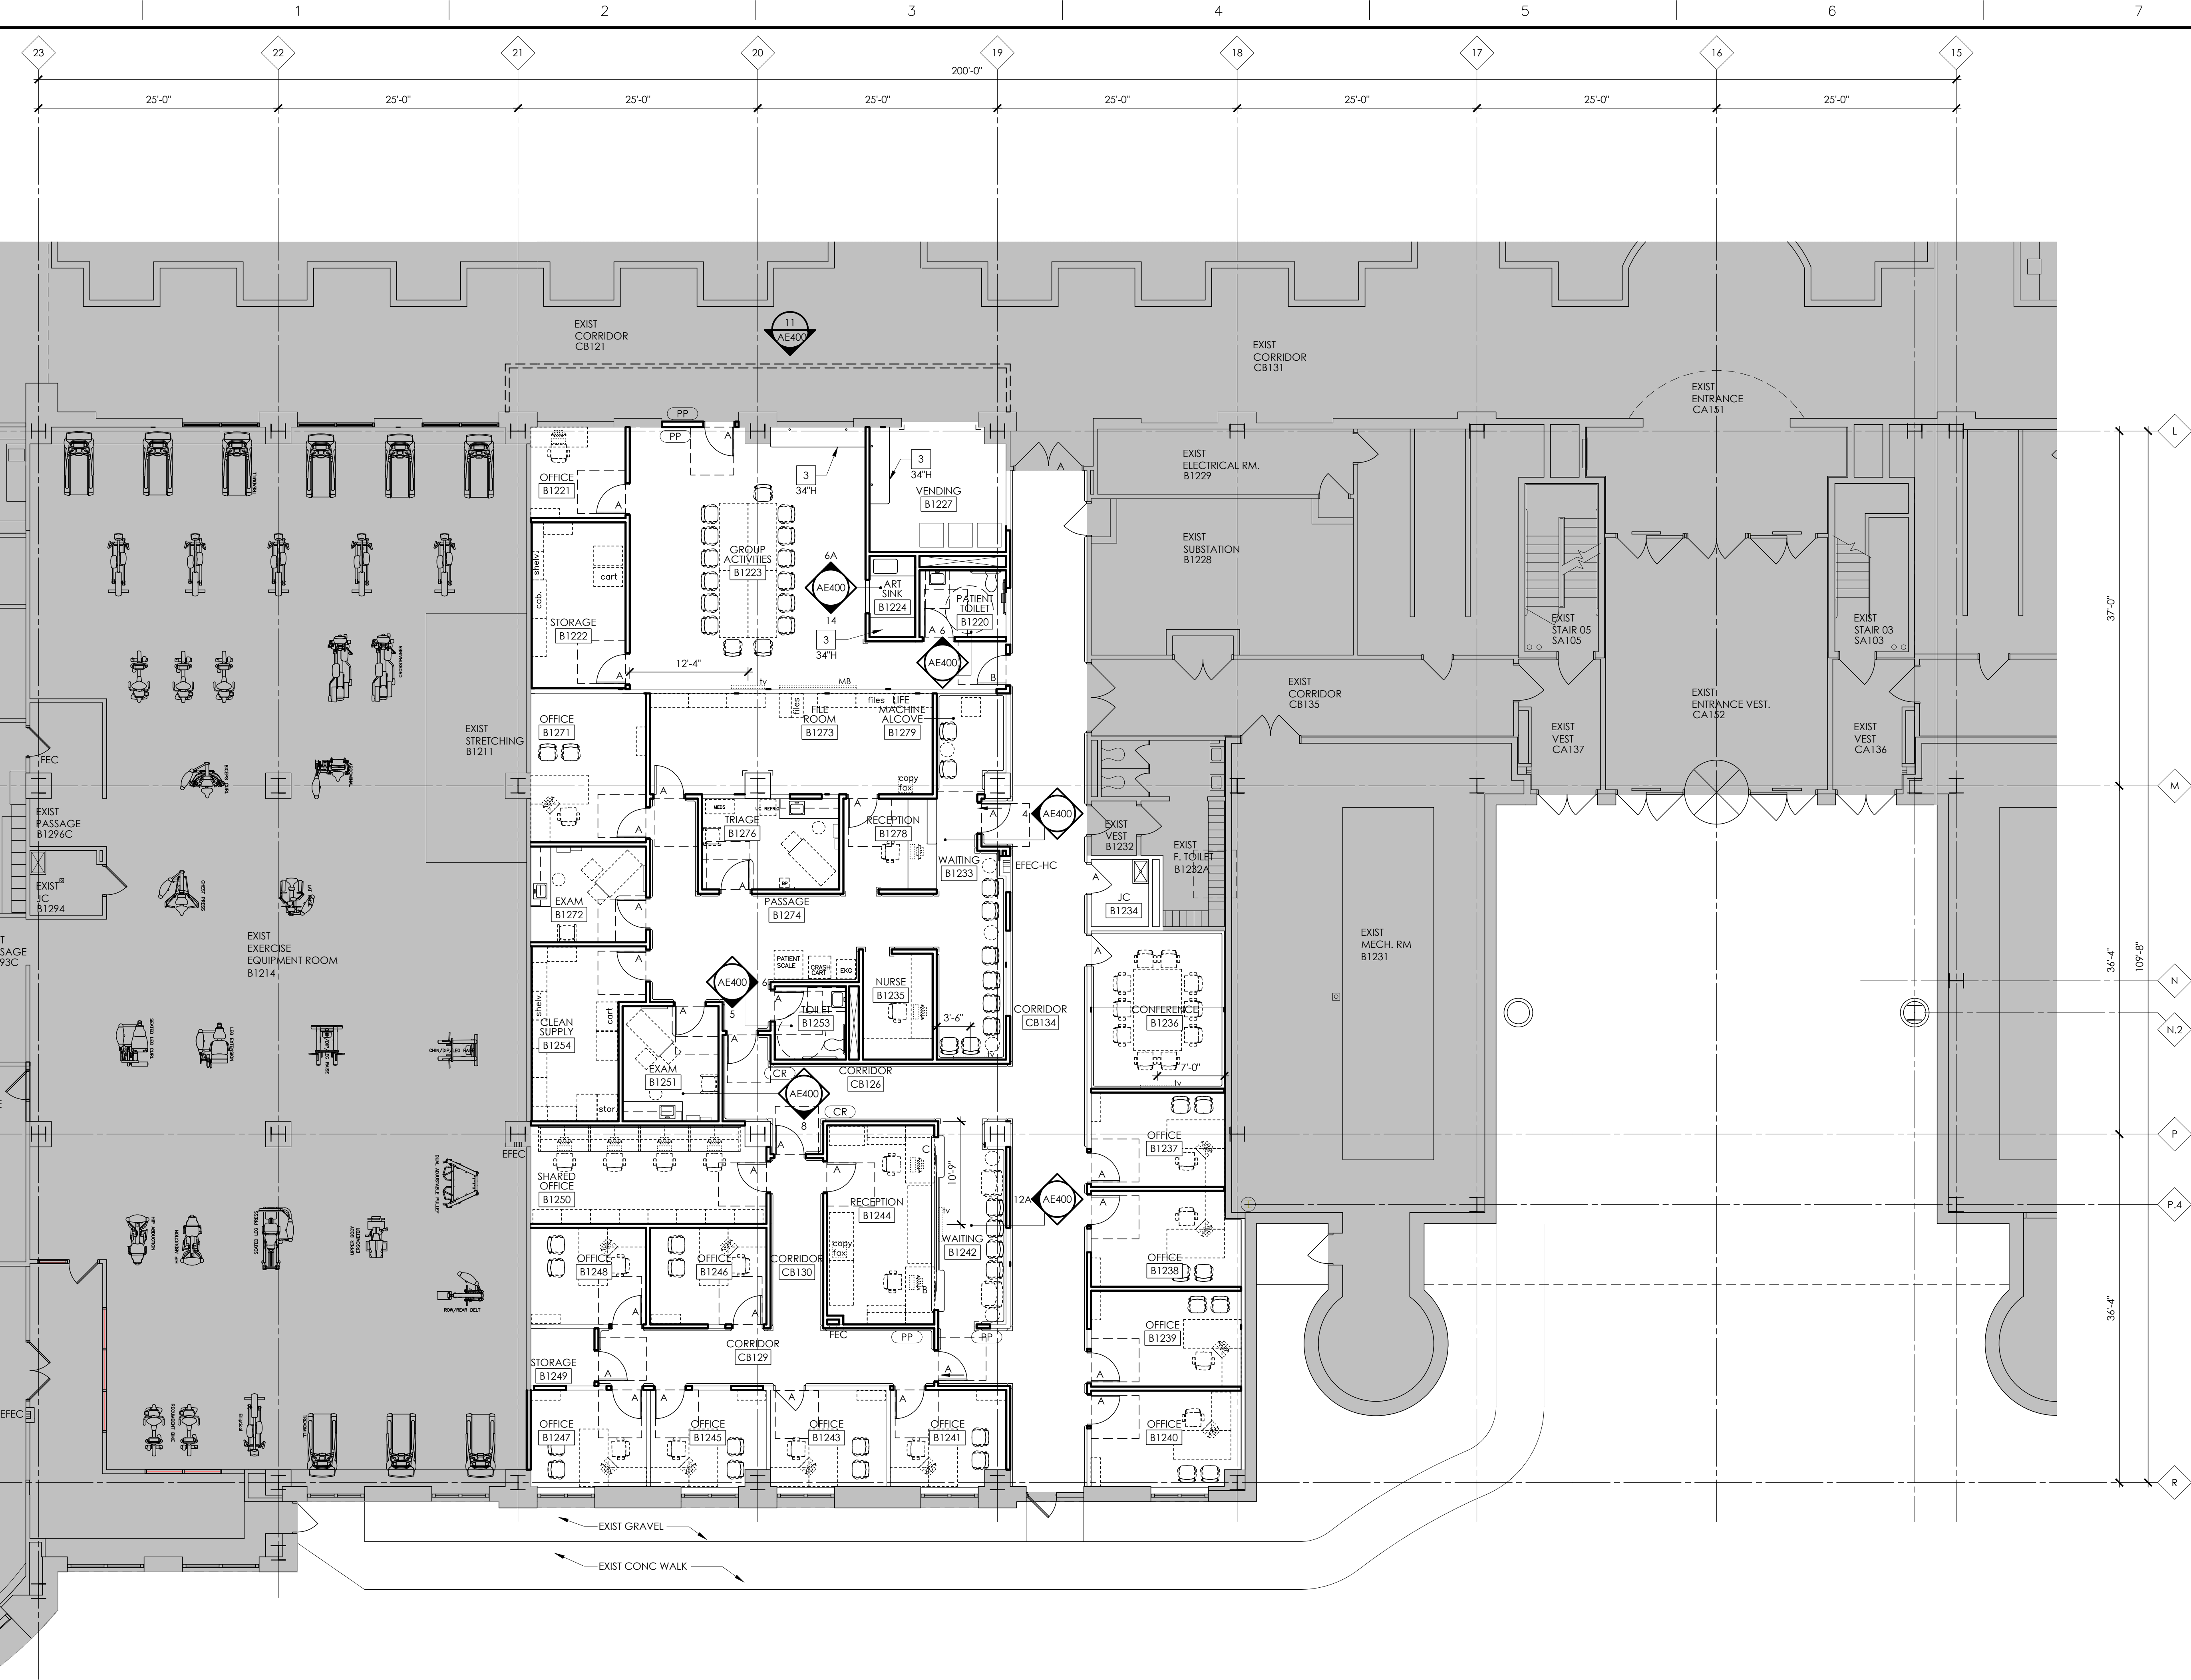

- CONSTRUCTION GENERAL NOTES:**
1. REFER TO SHEET AE001 FOR GENERAL NOTES AND ARCHITECTURAL SYMBOLS
  2. PATCH AND REPAIR WALL AND FLOOR OPENINGS TO MATCH ADJACENT EXISTING CONSTRUCTION, INCLUDING FINISH MATERIALS AFTER REMOVAL OF EXISTING MECHANICAL AND ELECTRICAL EQUIPMENT.
  3. PROVIDE REDUCER STRIPS AT TRANSITION OF FLOOR MATERIALS.  
- MAXIMUM CHANGE IN LEVEL=1/4"  
- BEVEL WITH 1:2 SLOPE FOR CHANGE IN LEVEL 1/4" TO 1/2"
  4. REFER TO DEMOLITION SHEETS FOR TEMPORARY WALL LOCATIONS AND DETAIL
  5. REFER TO SHEET AE110 FOR PARTITION DIMENSIONS AND DESIGNATIONS
  6. REFER TO DETAIL 18/ SHEET AE500 FOR CONCRETE SLAB/ DECK REPAIRS
  7. MARKER & TACK BOARDS FURNISHED & INSTALLED BY THE VA (GG)

**FLOOR PLAN LEGEND**

- CR CARD READER  
PP PUSH PLATE  
EPEC EXIST FIRE EXTINGUISHER CABINET  
EPEC-HC EXIST FIRE EXTINGUISHER AND HOSE CABINET  
TEMP PTN SEE AD101  
INDICATES EXISTING CONSTRUCTION TO REMAIN, UNO

**FLOOR PLAN NOTES**

- 1 ADJUSTABLE SHELVING (20" DEEP), CC  
2 ROD & SHELF, REFER TO DETAIL 12/ SHEET AE500, CC  
3 SOLID SURFACE COUNTERTOP & BACKSPASH, REFER TO DETAIL 8/ SHEET AE500, CC

0" 4'-0" 8'-0" 16'-0"  
1/8" = 1'-0"

**FULLY SPRINKLERED - CONSTRUCTION DOCUMENTS**

Drawing Title  
**FIRST FLOOR PLAN AND NOTES - ZONE 3**

Approved  
**J. HROVAT**

Project Title  
**JOHN D. DINGELL  
VA MEDICAL CENTER DETROIT  
RENOVATE 1ST FLOOR CLINICS**

Location  
**DETROIT, MICHIGAN**  
Date  
**08-12-15**

Project Number  
**553-13-122**  
Building Number  
**B-100**

Drawing Number  
**AE100**  
Dwg. 7 of 78

Office of  
Construction  
and Facilities  
Management


Department of  
Veterans Affairs

**ARCHITECT/ENGINEERS:**



**Albert Kahn Associates, Inc.**  
Albert Kahn Building  
7430 Second Ave.  
Detroit, Michigan 48202-2798  
Albert Kahn Associates, Inc. is a member of  
the Albert Kahn Family of Companies. © 2007  
**ALBERT KAHN JOB # 0398-0000**

**KEY PLAN**

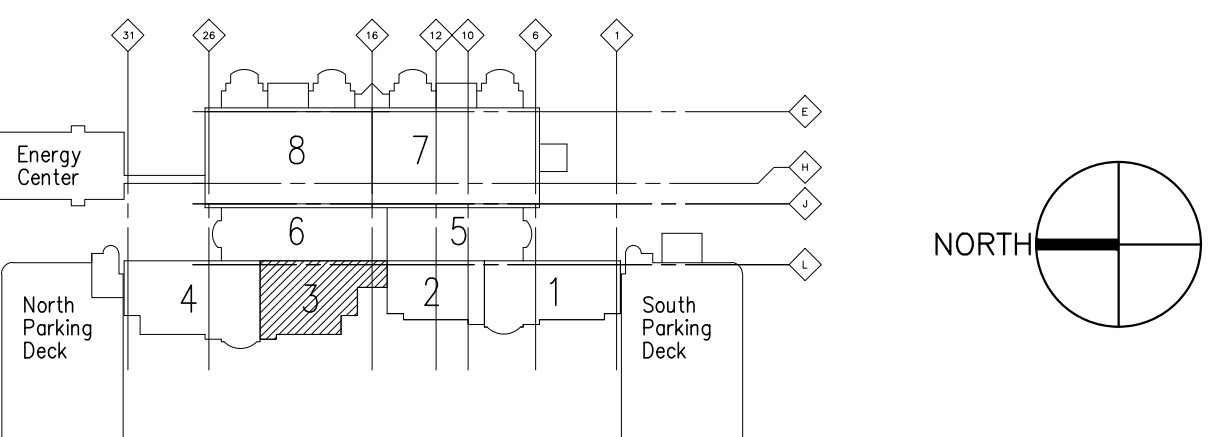

ISSUE 005 - RECORD	02-23-18
ISSUE 003 - BID	08-12-15
ISSUE 002 - CD OWNER REVIEW	05-29-15
Revisions:	Date