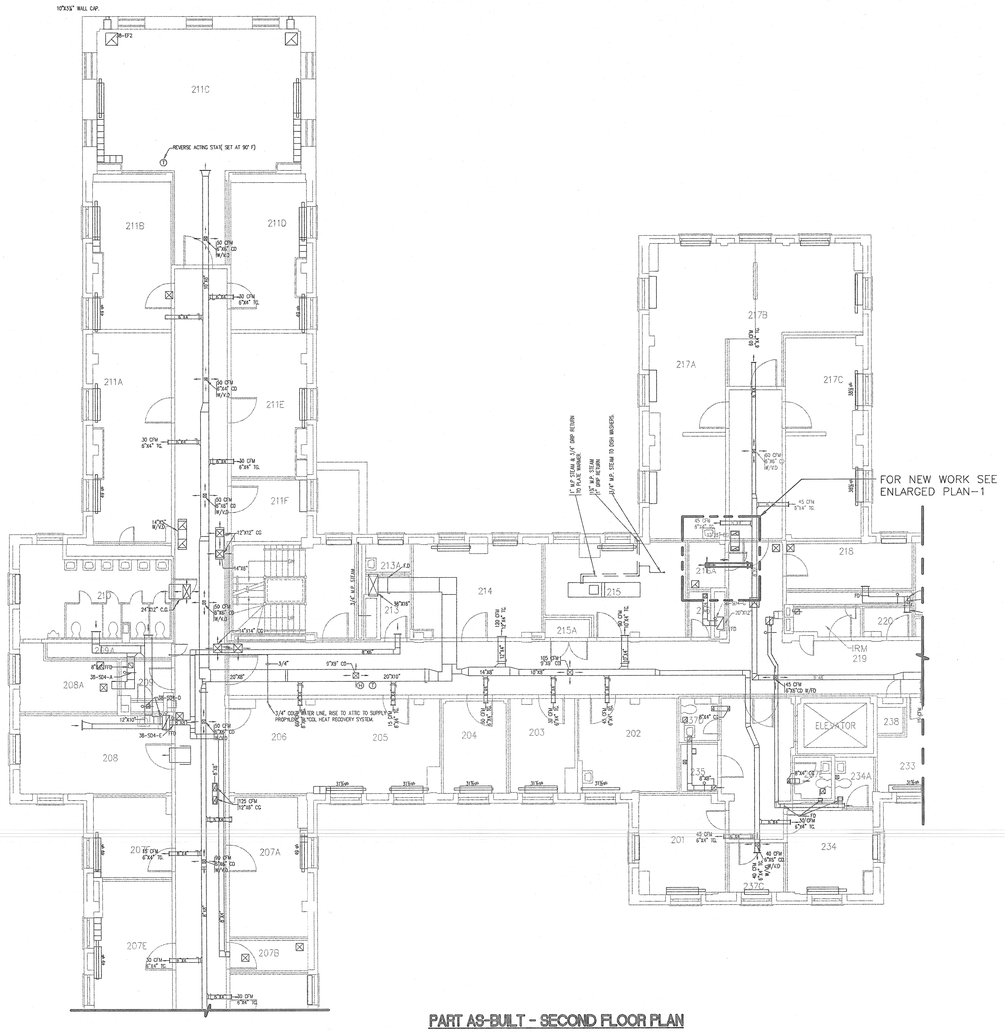

PART AS-BUILT - SECOND FLOOR PLAN
SCALE: 1/8"=1'-0"

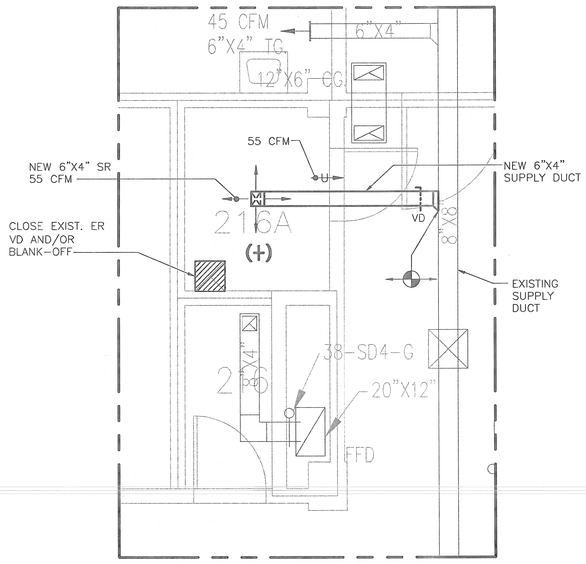

1 MH101 **NEW WORK - ROOM 216A ENLARGED PLAN - 1**
SCALE: 1/2"=1'-0"

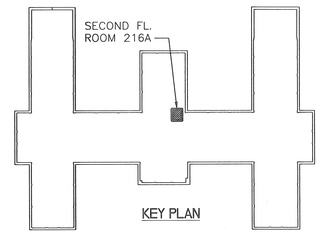

KEY PLAN

FINAL CONSTRUCTION DOCUMENTS

Revisions	Date

A/E SEAL

A/E ADDRESS

CHU AND GASSMAN, INC
1528 WALNUT ST., SUITE 625, PHILADELPHIA, PA 19102
T. (215) 355-0912 F. (732) 563-4549
559 UNION AVENUE, MIDDLESEX, NJ 08846
T. (732) 563-4550 F. (732) 563-4549

Drawing Title: MECHANICAL NEW WORK PART SECOND FLOOR PLAN

Approved: Chief Engineering Service — Michael Carcanague
Drawn: T. CHU
Approved: Medical Center Director — Gary W. Devansky
Checked: D. GABRIEL

Project Title: VAMC ENVIRONMENTAL CONTROLS
Date: 2/15/2012
Project No.: 542-08-114
Building Number: 38
Location: COATESVILLE, PENNSYLVANIA
DRAWING No.: 38MH101
Dwg. 11 Of 17

VA