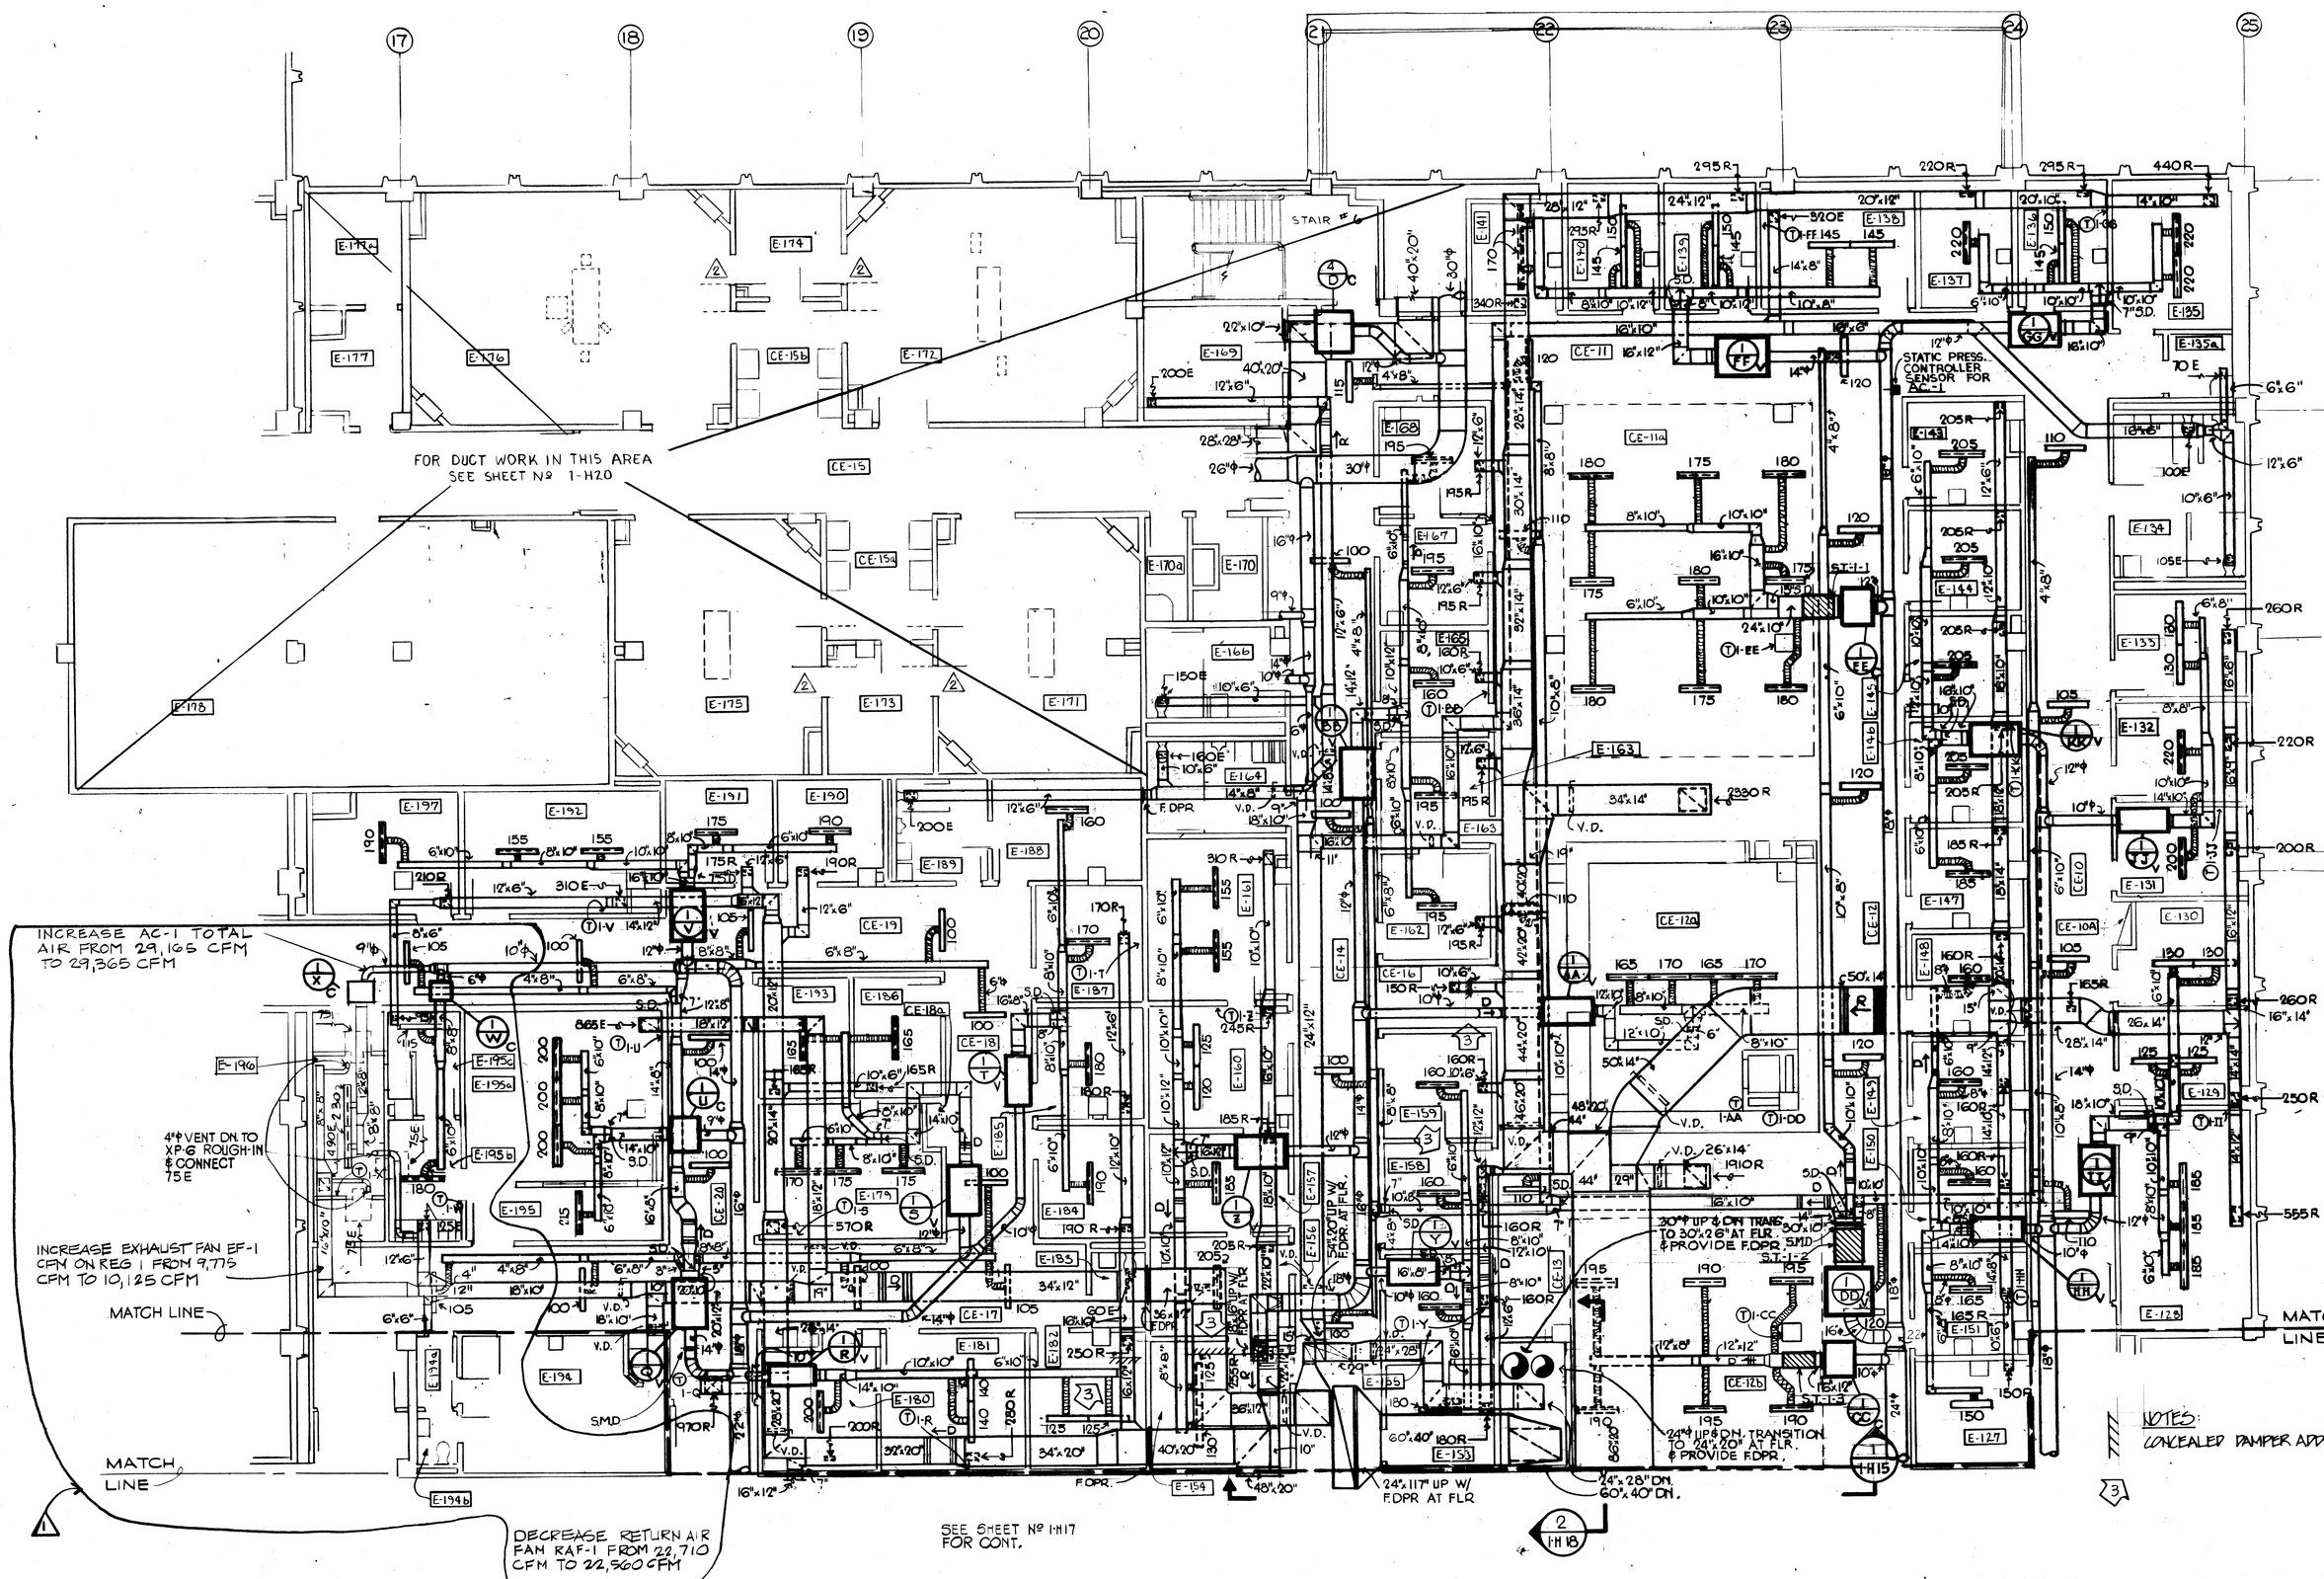

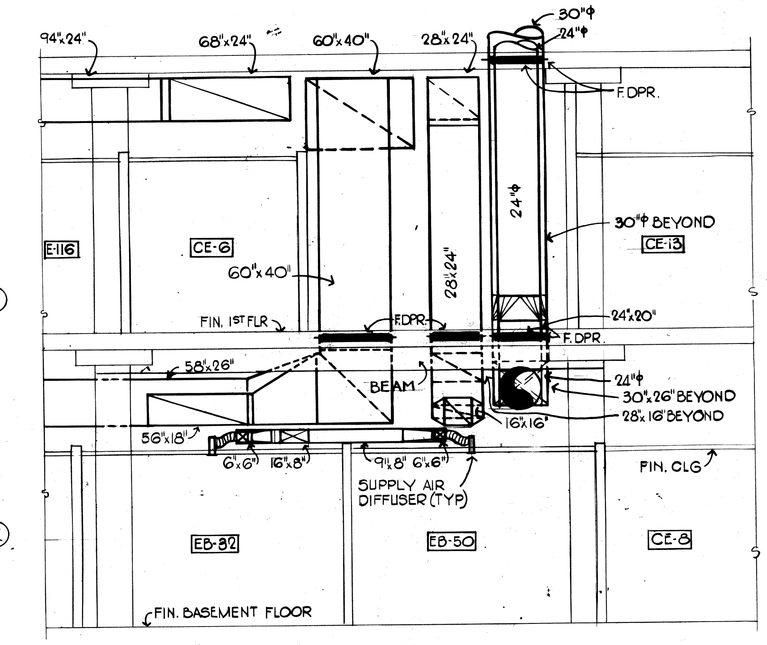

SECTION 2/1H-18
SCALE: 1/4"=0

RM. NO.	NAME	SUP	EXH	EXFIL	RET
E-127	DECED. APT.	150	–	–	150
E-128	UNIT SUPERVISOR	555	–	–	555
E-129	SEC. CHIEF	250	–	–	250
E-130	SOCIAL WORKER	260	–	–	260
E-131	SOCIAL WORKER	200	–	–	200
E-132	SOCIAL WORKER	220	–	–	220
E-133	DIET OFFICE	260	–	–	260
E-134	M. TOILET	–	205	–	–
E-135	CONSULTATION	440	–	–	440
E-135a	H.A.C.	–	70	–	–
E-136	EXAM	295	–	–	295
E-137	EXAM	220	–	–	220
E-138	ENDOS.	290	320	–	–
E-139	EXAM	295	–	–	295
E-140	EXAM	295	–	–	295
E-141	EXAM	340	–	–	340
E-142	–	–	–	–	–
E-143	EXAM	205	–	–	205
E-144	EXAM	205	–	–	205
E-145	EXAM	205	–	–	205
E-146	EXAM	205	–	–	205
E-147	EXAM	185	–	–	185
E-148	EXAM	160	–	–	160
E-149	EXAM	160	–	–	160
E-150	EXAM	160	–	–	160
E-151	EXAM	165	–	–	165
E-152	EXAM	180	–	–	180
E-153	CLERK TYPIST	255	–	–	255
E-155	EXAM	160	–	–	160
E-156	ASST. CHIEF	205	–	–	205
E-157	SECRETARY	185	–	–	185
E-158	EXAM	160	–	–	160
E-159	EXAM	160	–	–	160
E-160	CHIEF O.P.	245	–	–	245
E-161	CONSULTATION	310	–	–	310
E-162	EXAM	195	–	–	195
E-163	EXAM	195	–	–	195
E-164	M. TOILET	–	160	–	–
E-165	EXAM	160	–	–	160
E-166	F. TOILET	–	150	–	–
E-167	EXAM	195	–	–	195
E-168	EXAM	195	–	–	195
E-169	ELECTRICAL	–	200	–	–
E-170	STORAGE	–	95	–	–
E-170a	H.A.C.	–	65	–	–
E-171	OPERATING RM.	1255	1005	–	–
E-172	OPERATING RM.	1435	1150	–	–
E-173	SUB STERILE	490	440	–	–
E-174	SUB STERILE V.	500	450	–	–
E-175	OPERATING ROOM	1140	910	–	–
E-176	OPERATING ROOM	1650	1320	–	–
E-177	EQUIP. STORAGE	–	110	–	–

RM NO.	NAME	SUP	EXH	EXFIL	RET
E-177a	GAS STORAGE	–	–	–	–
E-178	RECOVERY ROOM	3125	2500	–	–
E-179	CONFERENCE	520	–	–	570
E-180	SECRETARY	200	–	–	200
E-181	CHIEF OFF.	280	–	–	280
E-182	OFFICE	250	–	–	250
E-183	TOILET	–	60	–	–
E-184	OFFICE	190	–	–	190
E-185	OFFICE	180	–	–	180
E-186	OFFICE	165	–	–	165
E-187	OFFICE	170	–	–	170
E-188	TECHN. DRESS.	160	–	–	–
E-189	M. TOILET	–	200	–	–
E-190	OFFICE	190	–	–	190
E-191	OFFICE	175	–	–	175
E-192	VIEW AREA	310	–	–	310
E-193	OFFICE	165	–	–	165
E-194	X-RAY, GENERAL	495	545	–	–
E-194a	DRESSING	55	–	–	–
E-194b	TOILET	–	55	–	–
E-195	CONTROL	–	–	–	–
E-195a	ANGIO, RADIO, SPEC, PROC.	815	865	–	–
E-195b	SCRUB-UP	180	200	–	–
E-195c	VIEW AREA	115	–	–	95
E-196	DARK ROOM	260	290	–	–
E-197	STORAGE	190	–	–	210
CE-10	CORRIDOR	430	–	–	230
CE-10a	TEL. CLOSET	–	–	–	–
CE-11	CORRIDOR	240	–	–	140
CE-11a	WAITING	1600	–	–	1600
CE-12	CORRIDOR	480	–	–	375
CE-12a	CLERICAL	670	–	–	670
CE-12b	WAITING	1155	–	–	1155
CE-13	CORRIDOR	335	–	–	235
CE-14	CORRIDOR	515	–	–	205
CE-14a	TEL. CLOSET	–	–	–	–
CE-15	CORRIDOR	790	2230	80	–
CE-15a	SCRUB-UP	130	145	–	–
CE-15b	SCRUB-UP	130	145	–	–
CE-16	CORRIDOR	–	–	–	–
CE-17	CORRIDOR	470	–	–	370
CE-18	CORRIDOR	160	–	–	100
CE-18a	TEL. CLOSET	–	–	–	–
CE-19	CORRIDOR	429	–	–	335
CE-20	CORRIDOR	165	–	–	115

KEY PLAN

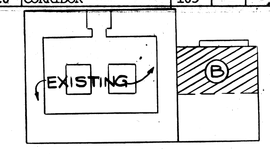

NOTES:
CONCEALED DAMPER ADDED BY REQUIMT OF TEST & BALANCE

3 DRAWING NO. 1-H18 — ADD SOUND ABSORBING DUCT LINES IN HIGH VELOCITY MEDIUM PRESSURE 24, 30 INCH DUCTS AND FITTINGS. SEE SECTION 2/1H-18 FOR CLARIFICATION.

2-8-2-0534

ALABAMA REGISTERED ARCHITECTS & ENGINEERS — SHERLOCK, SMITH & ADAMS, INC. — ARCH. 426 — Montgomery, Ala.

ALABAMA REGISTERED — No. 5167 — ENGINEER — JOSEPH E. HENRY

NO.	DATE	REVISIONS DESCRIPTION
3	6-30-78	'AS BUILT' DRAWINGS
2	1-31-77	ADD DOORS OPERATING SUITE
1	9-29-76	MODIFICATION OF X-RAY DUCTWORK

SHEET TITLE: HV&AC FIRST FLOOR PLAN - BLOCK "B" AIR DISTRIBUTION

BLDG. NO. 1 — PROJECT TITLE: CLINICAL IMPROVEMENTS PHASE I

DRAWN: BH — CHECKED: JEH — DATE: SEP'T. 8, 1975

STEVENS & WALTON ARCHITECTS, INC. ORLANDO, FLORIDA 32805 AND SHERLOCK, SMITH & ADAMS, INC. ARCHITECTS & ENGINEERS MONTGOMERY, ALABAMA 36111

DRAWING NUMBER: 1-H18 — DWG. 136 OF 148 — PROJECT NUMBER: 573-008

APPROVED: SERVICE DIRECTOR

VETERANS ADMINISTRATION

LOCATION: VAH, GAINESVILLE, FLORIDA

FIRST FLOOR PLAN ~ BLOCK 'B'
SCALE: 1/8" = 1'-0"

THREE INCHES EQUALS ONE FOOT | ONE AND ONE HALF INCHES EQUALS ONE FOOT | ONE INCH EQUALS ONE FOOT | THREE QUARTER INCH EQUALS ONE FOOT | ONE HALF INCH EQUALS ONE FOOT | THREE EIGHTH INCH EQUALS ONE FOOT | ONE QUARTER INCH EQUALS ONE FOOT | ONE EIGHTH INCH EQUALS ONE FOOT

RETURN TO PLAN LIBRARY
FILE FOLDER NO. 2C
54
VA FORM 08-6231, FEB 1973
* U. S. GOVERNMENT PRINTING OFFICE : 1973 O - 497-166