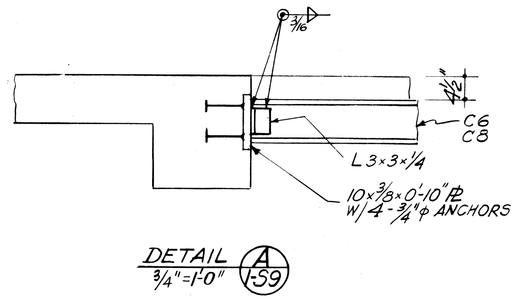

DETAIL (A) 1-59
3/4"=1'-0"

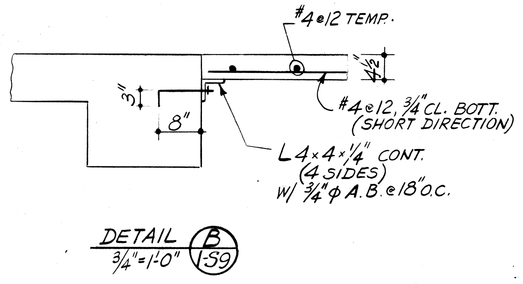

DETAIL (B) 1-59
3/4"=1'-0"

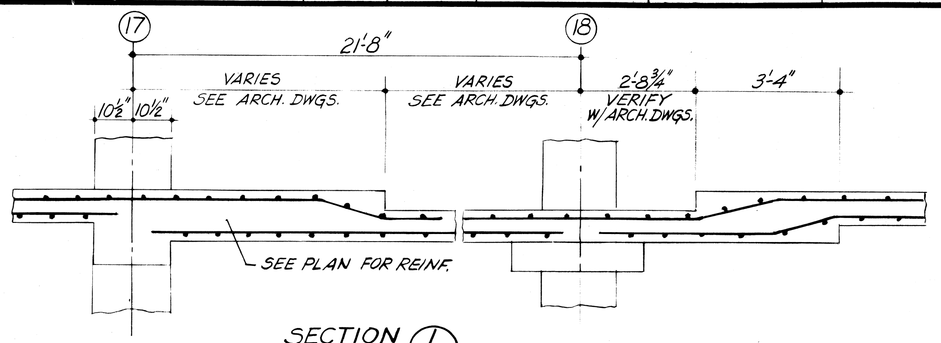

SECTION (1) 1-59
1/2"=1'-0"

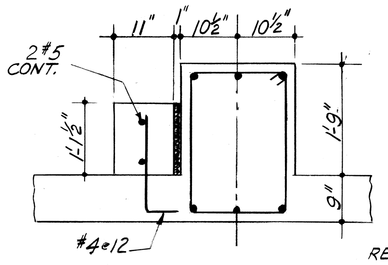

SECTION (2) 1-59
3/4"=1'-0"

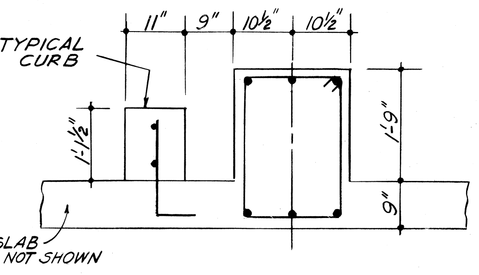

SECTION (3) 1-59
3/4"=1'-0"

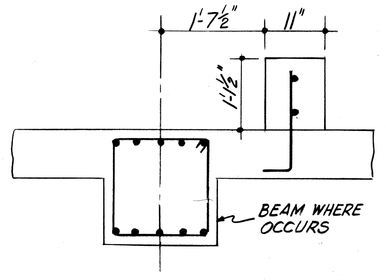

SECTION (4) 1-59
3/4"=1'-0"

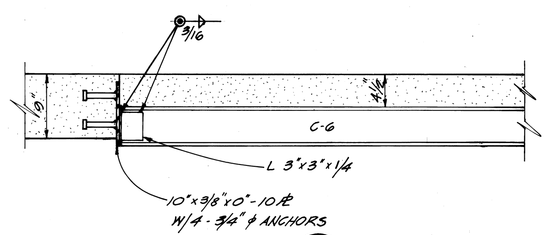

SECTION (C) 1-59
1"=1'-0"

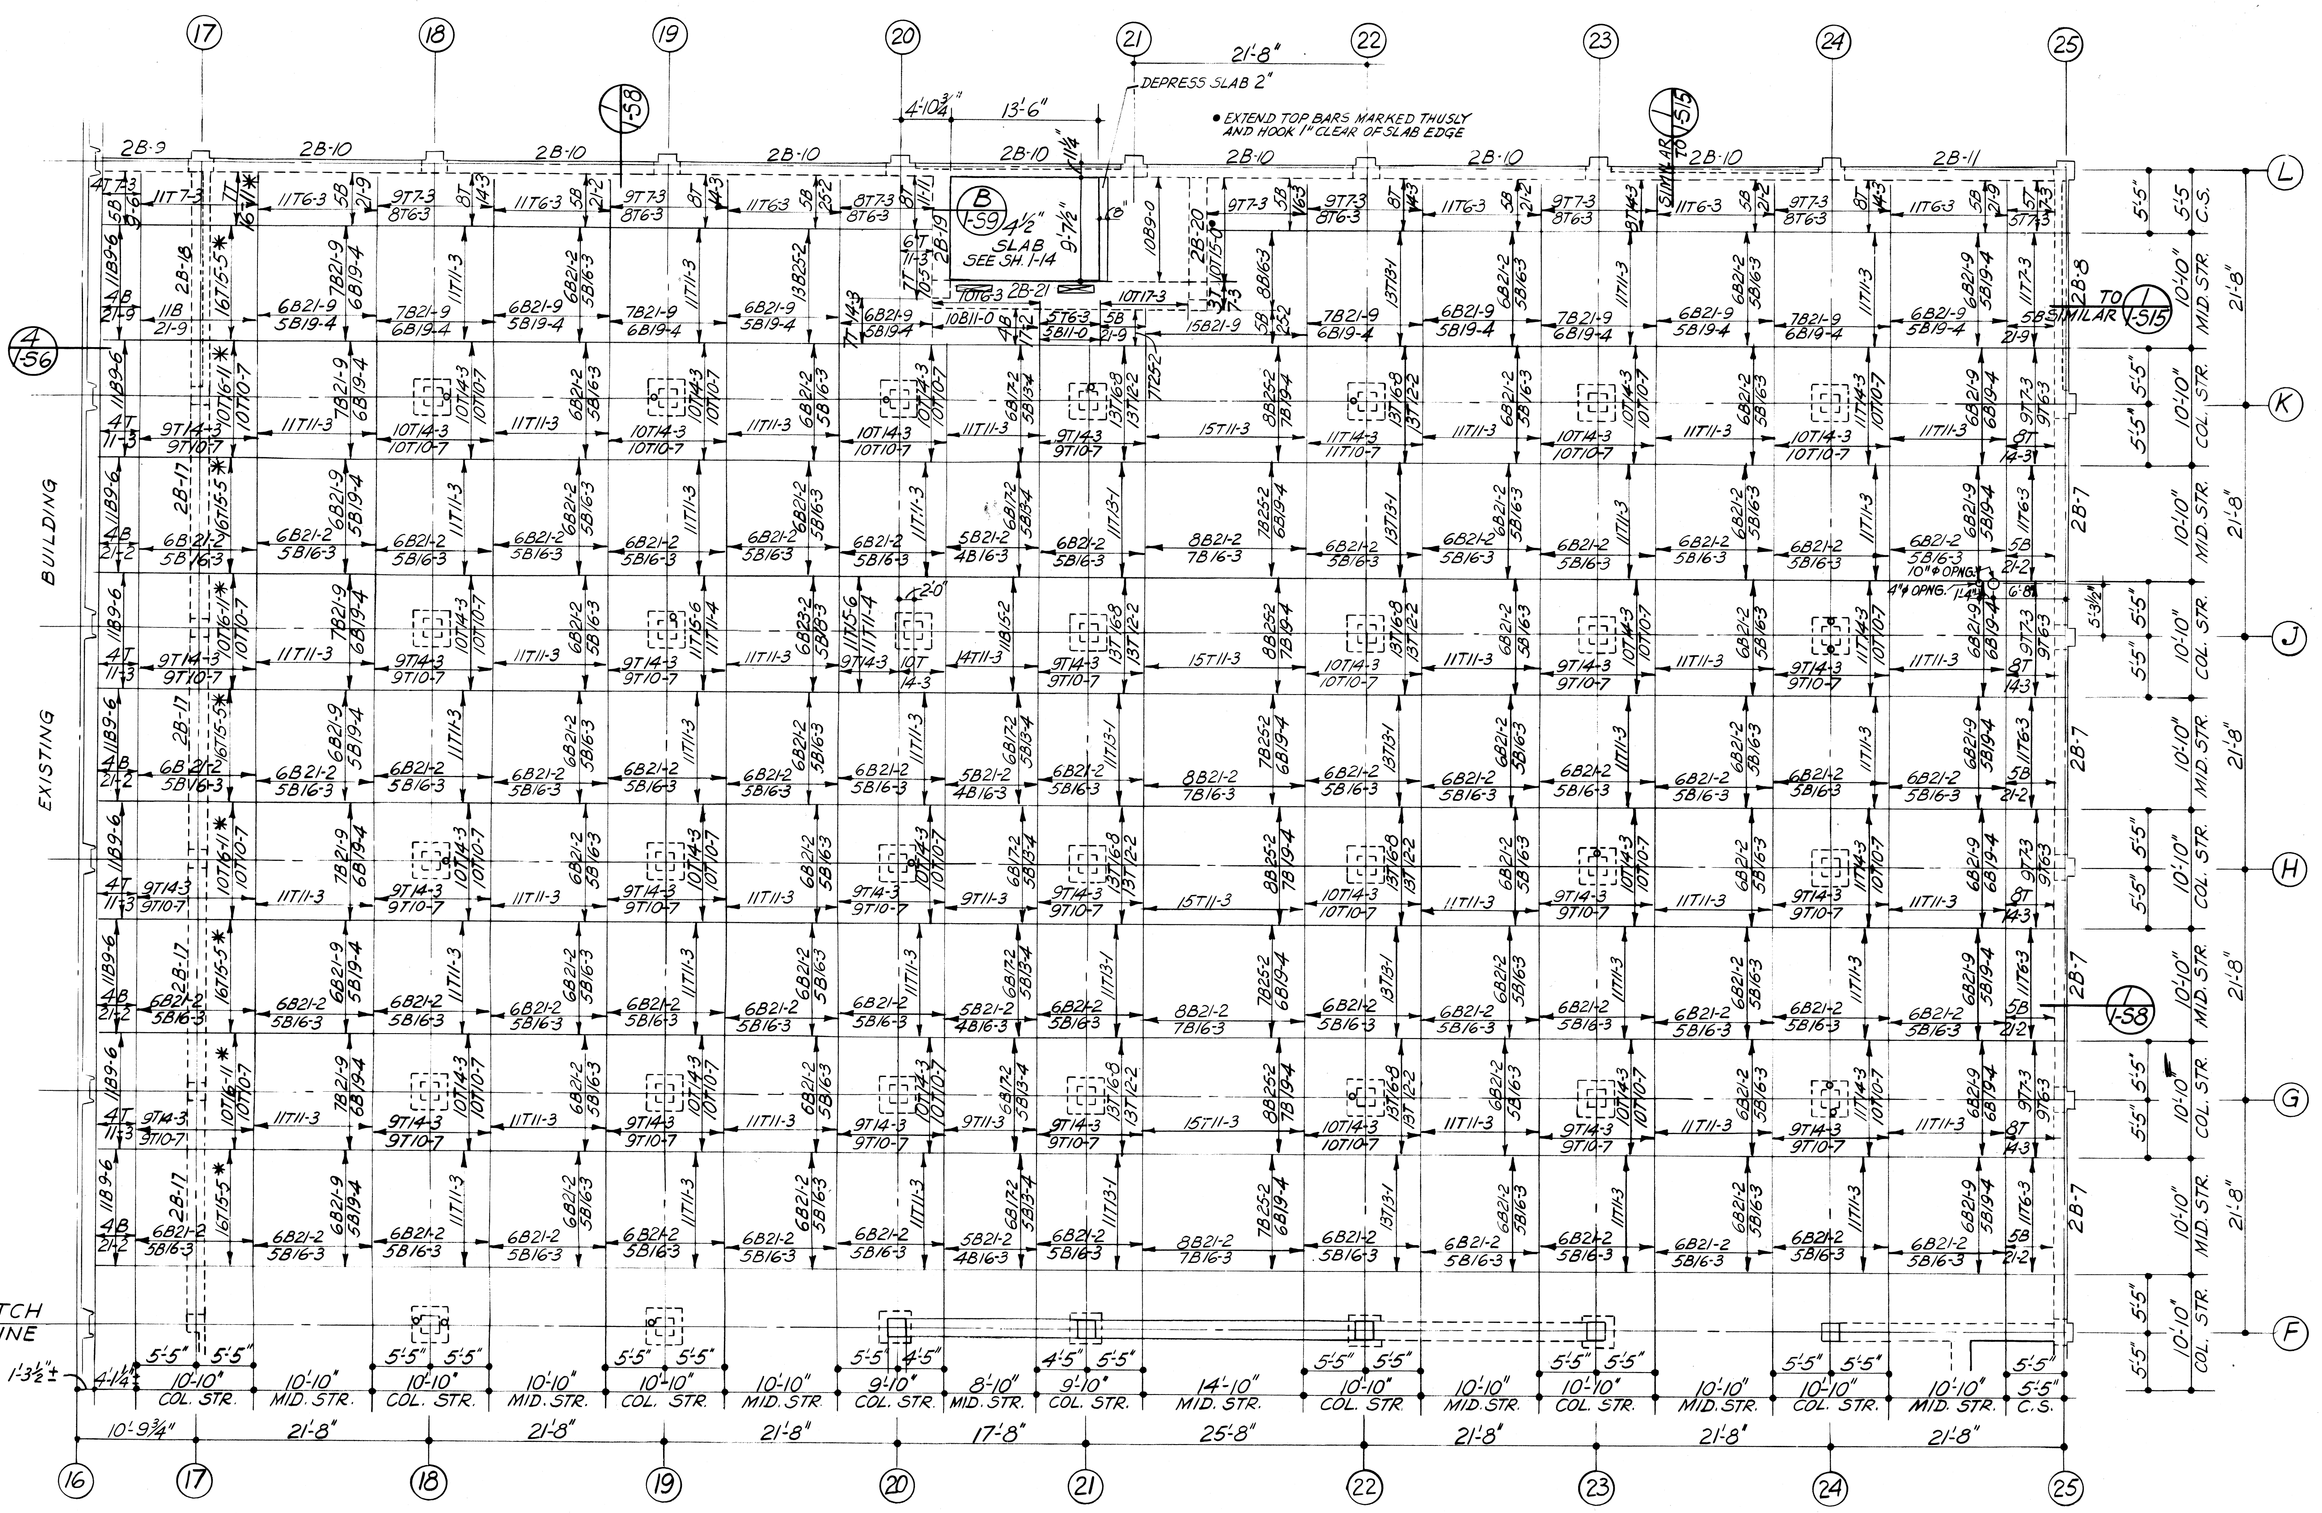

* EXTEND TOP BARS MARKED THUSLY AND HOOK 1" CLEAR OF SLAB EDGE AT EXP. JOINT

PARTIAL ROOF (2-ND FLOOR) FRAMING PLAN - BLOCK "B"
1/8"=1'-0"

NOTES
1- FINISHED FLOOR ELEVATION 117'-10" EXCEPT AS NOTED.
2- TOP OF SLAB (±0") AND ALL SLABS 9" THICK EXCEPT AS SHOWN OTHERWISE.
3- ALL SLAB BARS #5 EXCEPT AS SHOWN OTHERWISE.

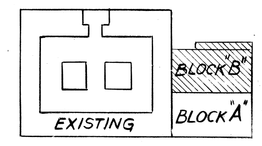

KEY PLAN

2-8-2-0425

THREE INCHES EQUALS ONE FOOT
ONE AND ONE HALF INCHES EQUALS ONE FOOT
ONE INCH EQUALS ONE FOOT
THREE QUARTER INCH EQUALS ONE FOOT
ONE HALF INCH EQUALS ONE FOOT
THREE EIGHTH INCH EQUALS ONE FOOT
ONE QUARTER INCH EQUALS ONE FOOT
ONE EIGHTH INCH EQUALS ONE FOOT

ALABAMA — STEVENS, SMITH & ADAMS, INC. — ARCH. 426 — Montgomery, Ala. — REGISTERED ARCHITECTS & ENGINEERS

1/2 AUG 71 "AS-BUILT" DWG

NO.	DATE	DESCRIPTION

REVISIONS

SHEET TITLE: PARTIAL ROOF (2nd FLOOR) FRAMING PLAN BLOCK "B"

BLDG. NO.	PROJECT TITLE
1	CLINICAL IMPROVEMENTS PHASE I

DRAWN | CHECKED | DATE: SEP'T. 8, 1975

STEVENS & WALTON ARCHITECTS, INC.
ORLANDO, FLORIDA 32805
AND
SHERLOCK, SMITH & ADAMS, INC.
ARCHITECTS & ENGINEERS
MONTGOMERY, ALABAMA 36111

DRAWING NUMBER: 1-S9
DWG. 54 OF 148
PROJECT NUMBER: 573-008

APPROVED: SERVICE DIRECTOR

VETERANS ADMINISTRATION

LOCATION: VAH, GAINESVILLE, FLORIDA

RETURN TO PLAN LIBRARY
FILE FOLDER NO. 2A

VA FORM 08-6231, FEB 1973

• U. S. GOVERNMENT PRINTING OFFICE : 1973 O - 497-165