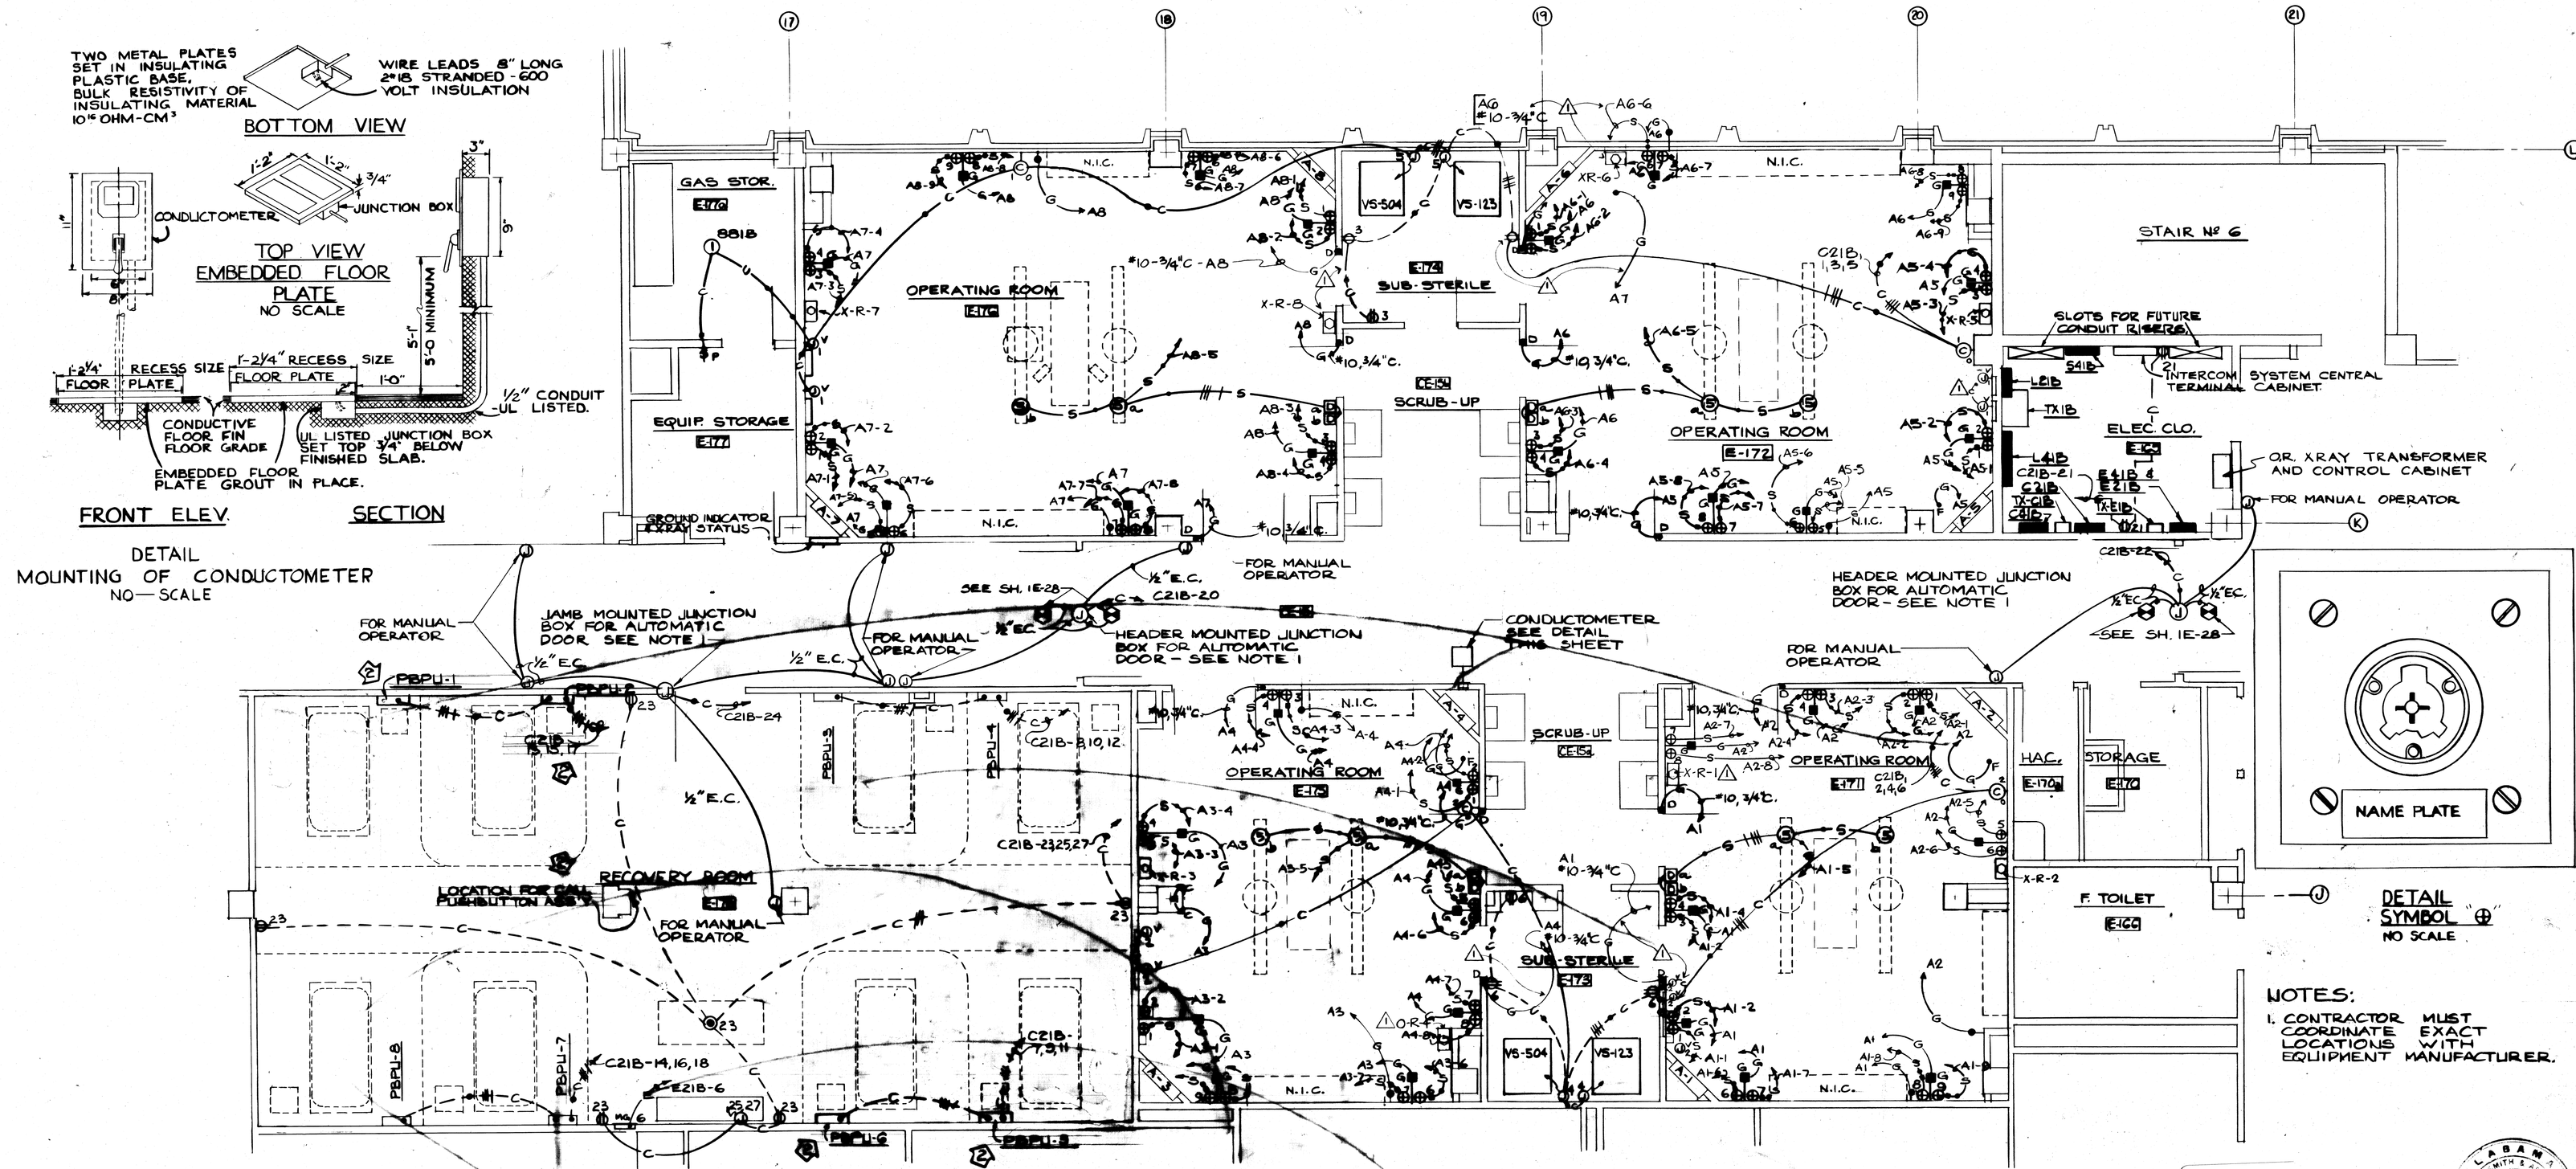

NOTES:
1. CONTRACTOR MUST COORDINATE EXACT LOCATIONS WITH EQUIPMENT MANUFACTURER.

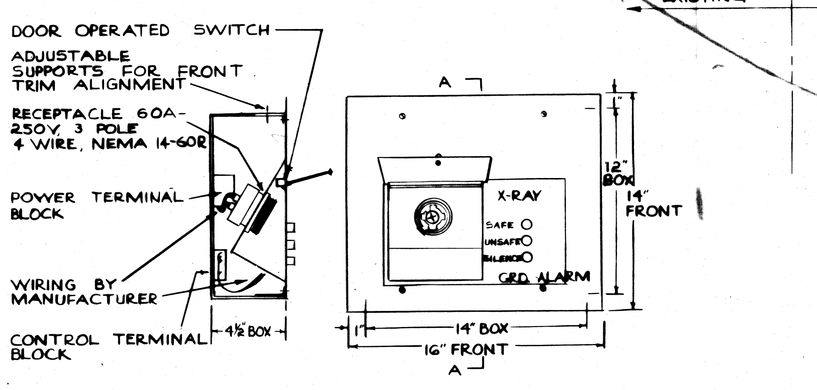

SECTION A-A FRONT VIEW
O.R X-RAY RECEPTACLE & REMOTE GROUND INDICATOR
NO ——— SCALE
SYMBOL ⊡

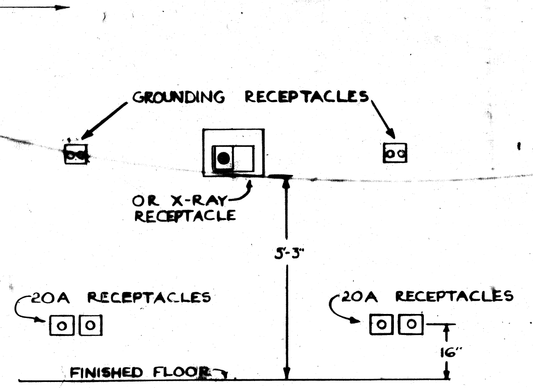

TYPICAL INSTALLATION OF O.R. RECEPTACLES WITH GROUNDING JACKS ABOVE.
NO ——— SCALE

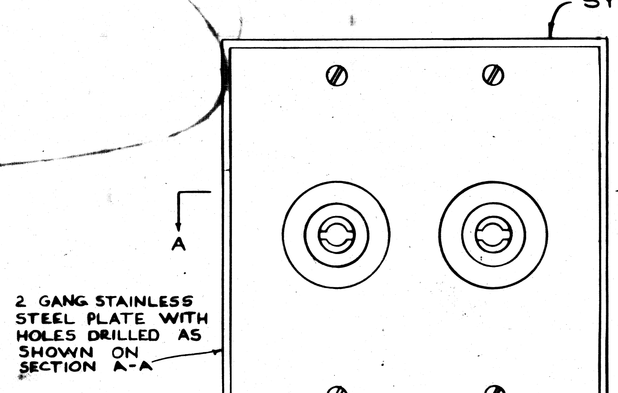

FACE PLATE DETAIL

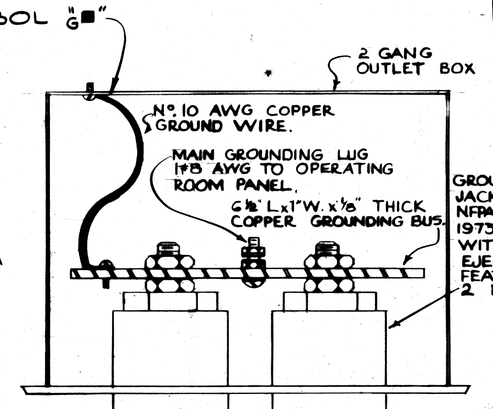

SECTION A-A

PATIENT GROUND TERMINAL ASSEMBLY
NO ——— SCALE

2-8-2-0624

NO.	DATE	DESCRIPTION
2	6-14-78	'AS BUILT' DRAWINGS
1	1-31-77	ADD. DOORS OPERATING SUITE

REVISIONS

SHEET TITLE: PARTIAL FIRST FLOOR PLAN-BLOCK 'B' ELECTRICAL - POWER

BLDG. NO. 1 — PROJECT TITLE: CLINICAL IMPROVEMENTS

DRAWN: J.W.E. — CHECKED: R. LOEB — DATE: SEPT. 6, 1975

STEVENS & WALTON ARCHITECTS, INC. ORLANDO, FLORIDA 32805
AND
SHERLOCK, SMITH & ADAMS, INC. ARCHITECTS & ENGINEERS MONTGOMERY, ALABAMA 36111

DRAWING NUMBER: 1-E21
DRG. 22 OF 148
PROJECT NUMBER: 573-008

APPROVED: SERVICE DIRECTOR

VETERANS ADMINISTRATION

LOCATION: VAH, GAINESVILLE, FLORIDA

THREE INCHES EQUALS ONE FOOT | ONE AND ONE HALF INCHES EQUALS ONE FOOT | ONE INCH EQUALS ONE FOOT | THREE QUARTER INCH EQUALS ONE FOOT | ONE HALF INCH EQUALS ONE FOOT | THREE EIGHTH INCH EQUALS ONE FOOT | ONE QUARTER INCH EQUALS ONE FOOT | ONE EIGHTH INCH EQUALS ONE FOOT

RETURN TO PLAN LIBRARY
FILE FOLDER NO. 29
VA FORM 08-6231, FEB 1973
U.S. GOVERNMENT PRINTING OFFICE: 1975 O - 617-111