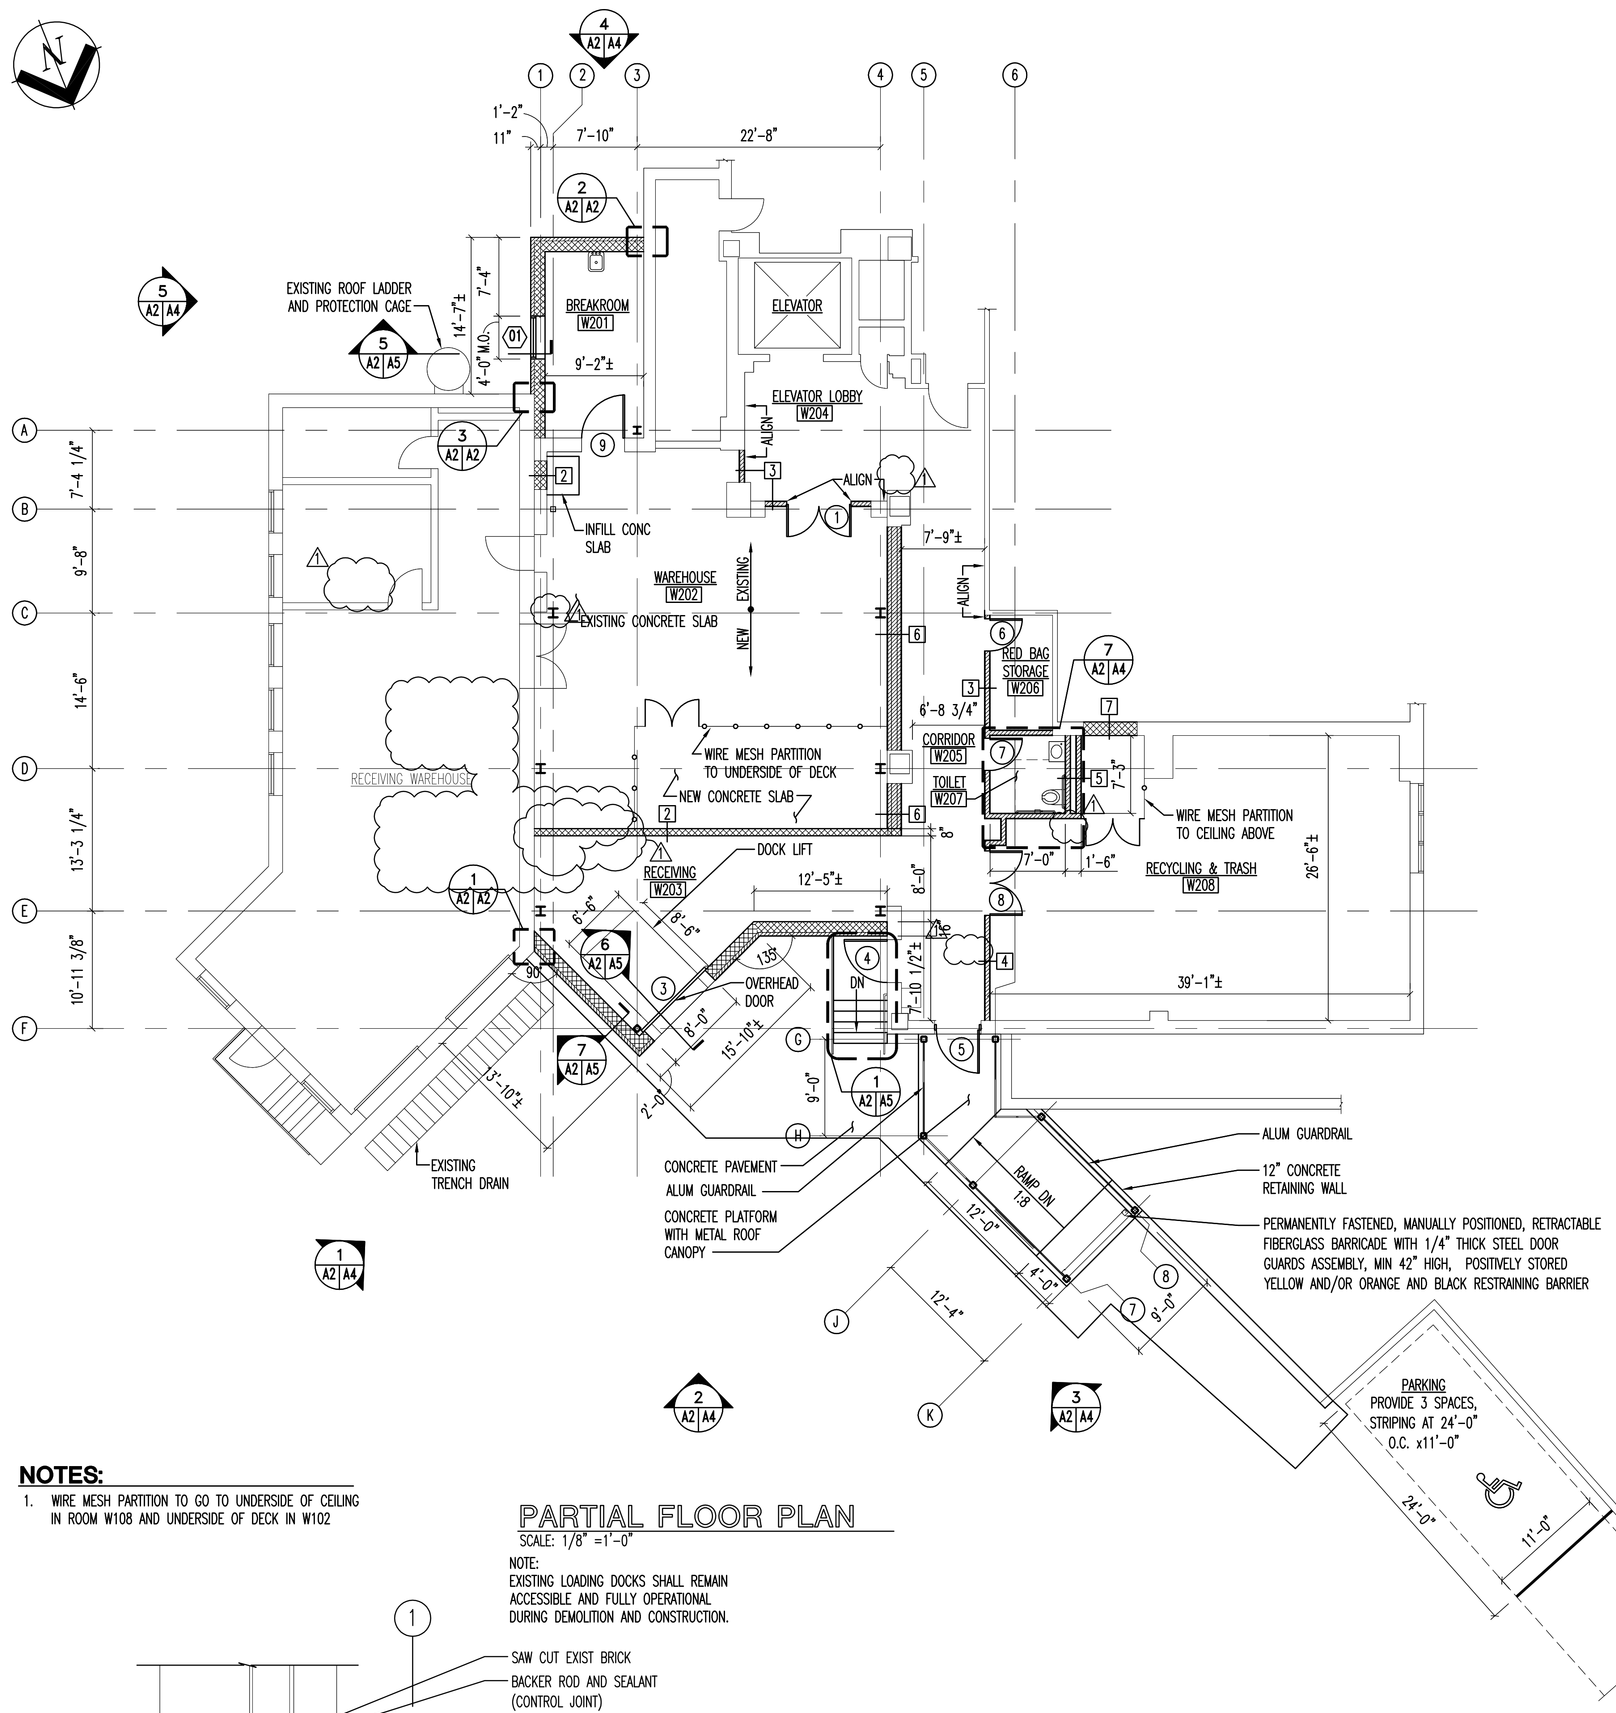


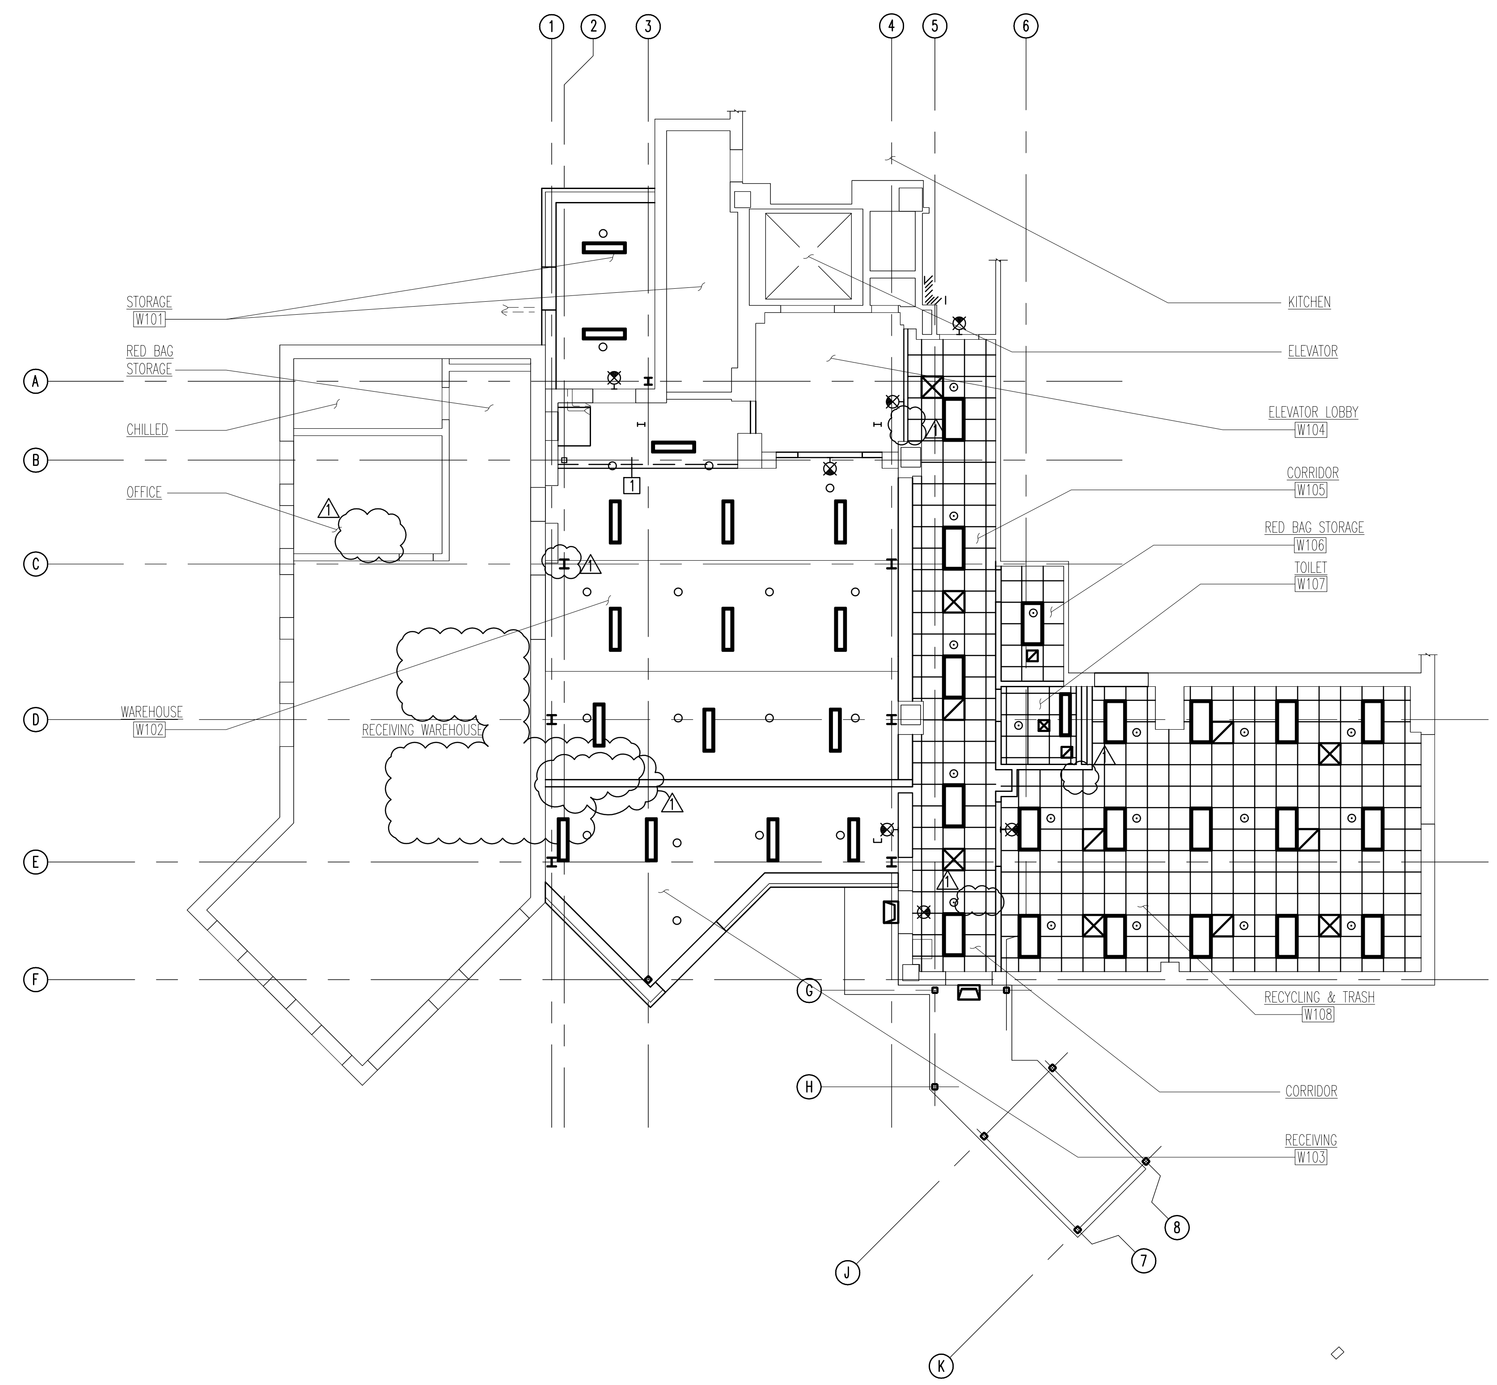


## NOTES:

1. WIRE MESH PARTITION TO GO TO UNDERSIDE OF CEILING IN ROOM W108 AND UNDERSIDE OF DECK IN W102

## PARTIAL FLOOR PLAN

SCALE: 1/8" =1'-0"

NOTE:
EXISTING LOADING DOCKS SHALL REMAIN ACCESSIBLE AND FULLY OPERATIONAL DURING DEMOLITION AND CONSTRUCTION.

## PARTIAL REFLECTED CEILING PLAN

SCALE: 1/8" =1'-0"

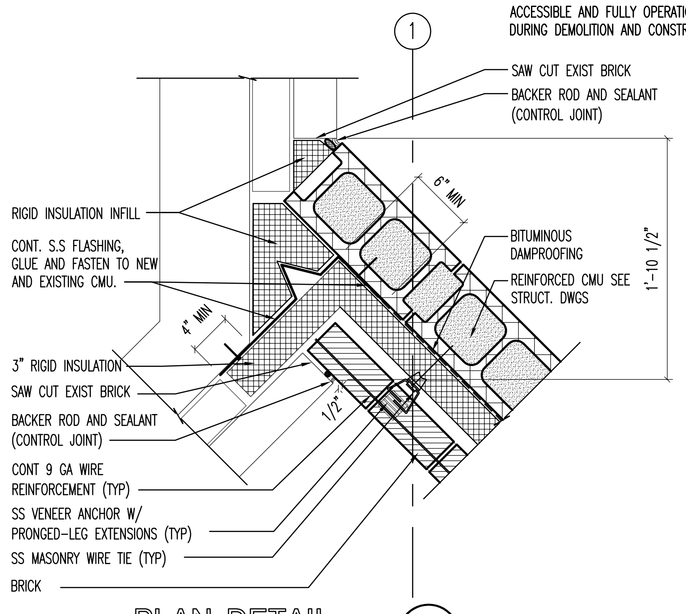


PLAN DETAIL 1 (A2 | A2)
SCALE: N.T.S.

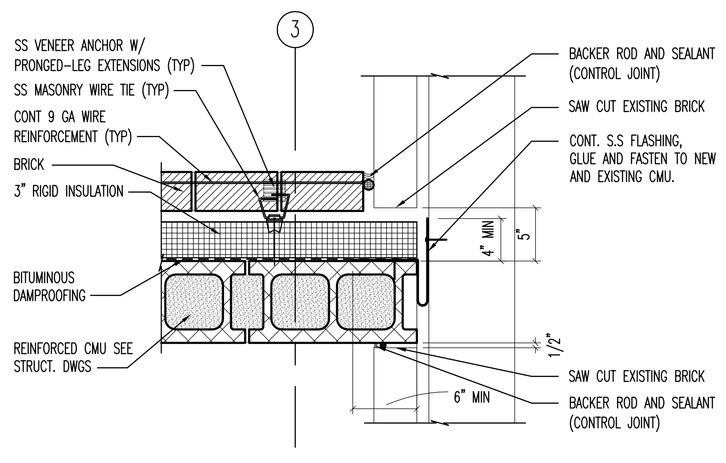


PLAN DETAIL 2 (A2 | A2)
SCALE: N.T.S.

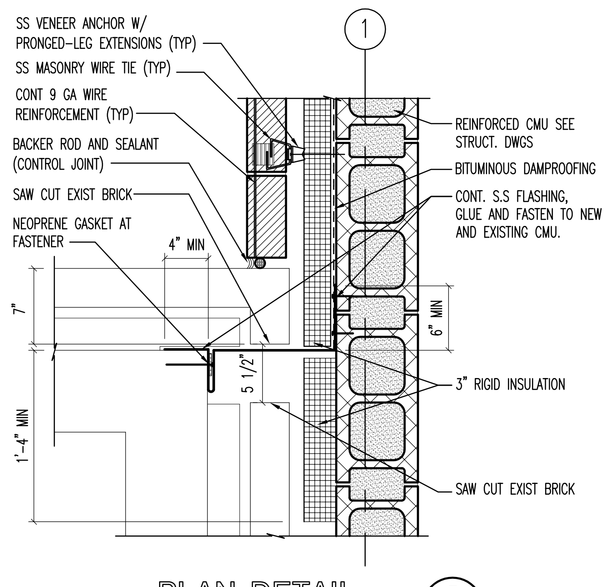


PLAN DETAIL 3 (A2 | A2)
SCALE: N.T.S.

## LEGEND

- PARTITION KEY
- DOOR KEY
- WINDOW KEY
- POINT ELEVATION
- SUPPLY DIFFUSER
- RETURN REGISTER
- SPRINKLER HEAD
- EXISTING SPRINKLER HEAD
- ROOM NUMBER KEY
- SECTION KEY
- ELEVATION KEY
- DETAIL KEY
- 2'X4' LIGHTING FIXTURE
- 1'X4' LIGHTING FIXTURE
- LED EXIT LIGHTING FIXTURE
- EXIT SIGN

8' 4' 0' 8' 16'
SCALE 1/8" = 1'-0"

BID SUBMISSION

| Revisions | Date |
|---|---|
| DELETE DOOR #2 PER VA | JULY 18, 2012 |

Professional Seal

DCS INFRASTRUCTURE, LLC
MOUNT LAUREL, NEW JERSEY
Hatch Mott MacDonald

| | |
|---|---|
| Drawing Title | PARTIAL FLOOR PLAN, PARTIAL REFLECTED CEILING PLAN AND DETAILS |
| Approved : Division Chief | |
| Approved : Service Director | |
| Project Title | FCA RECONFIGURE LOADING DOCK |
| Building Number | 1 |
| Checked | RSD |
| Drawn | JAS/JCR |
| Location | ALTOONA, PENNSYLVANIA |
| Date | MAY 30, 2012 |
| Project No. | 503-11-107 |
| Drawing No. | A2 |
| Sht. | 5 Of 27 |

Office of Facilities
Department of Veterans Affairs

P:\298501\DRAWINGS\298501-CURRENT DRAWINGS\298501-A2.DWG 7/18/2012 2:58 PM CIF50603
P:\298501\Drawings\298501-Current Drawings\298501-A2.dwg, 7/18/2012 2:58:17 PM