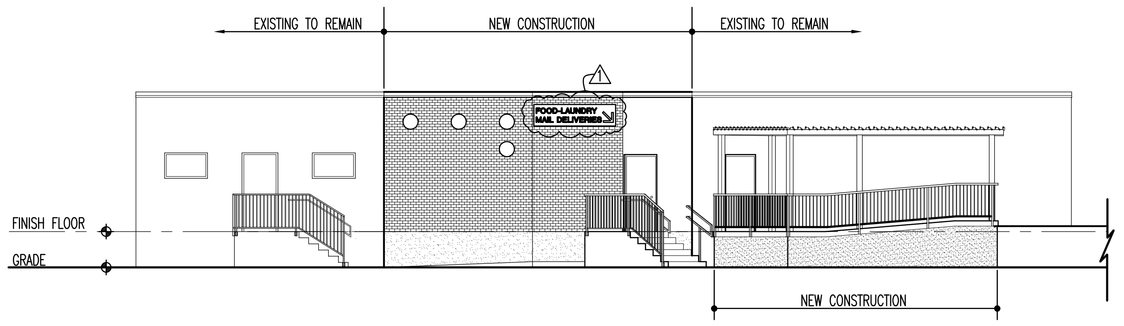

LOADING DOCK ELEVATION (1 / A2 | A4)
SCALE: 1/8" =1'-0"

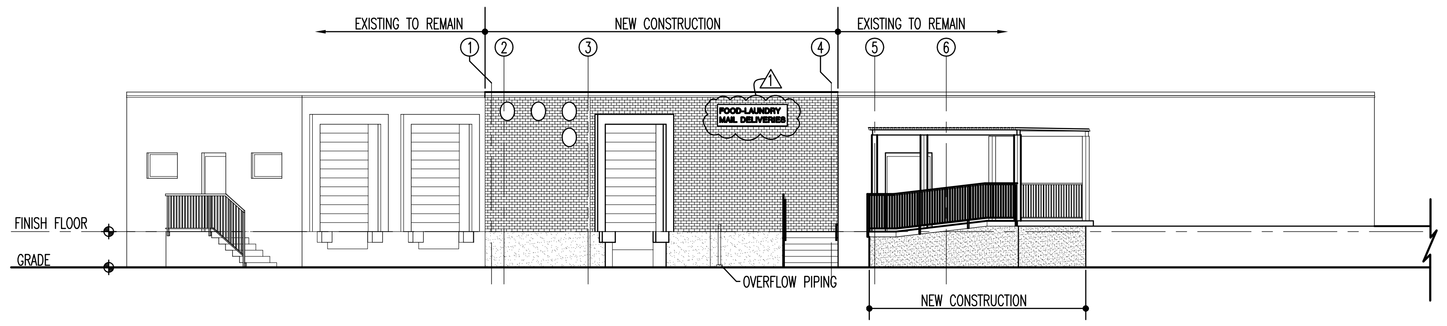

LOADING DOCK ELEVATION (2 / A2 | A4)
SCALE: 1/8" =1'-0"

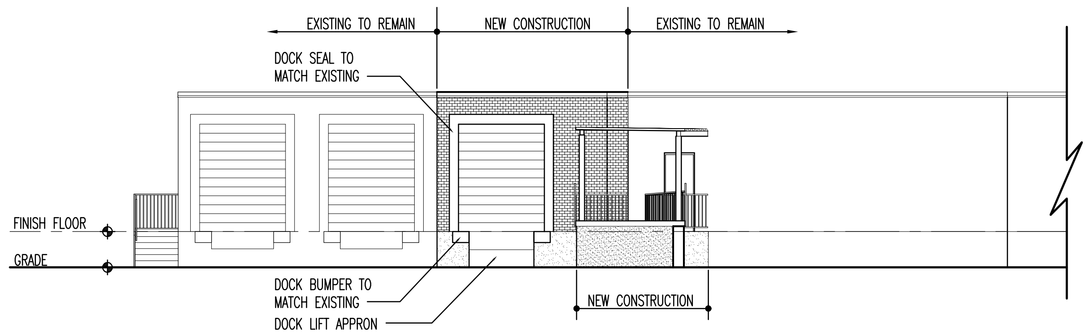

LOADING DOCK ELEVATION (3 / A2 | A4)
SCALE: 1/8" =1'-0"

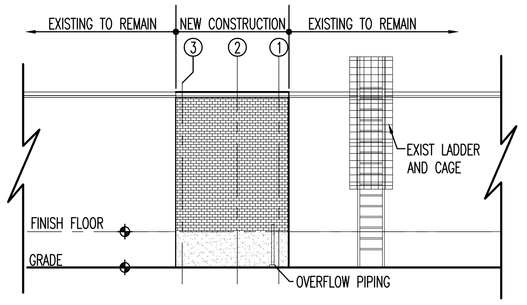

LOADING DOCK ELEVATION (4 / A2 | A4)
SCALE: 1/8" =1'-0"

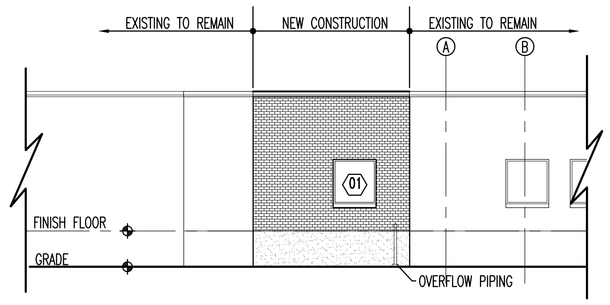

LOADING DOCK ELEVATION (5 / A2 | A4)
SCALE: 1/8" =1'-0"

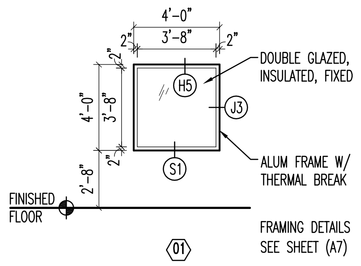

WINDOW ELEVATION (6 / A2 | A4)

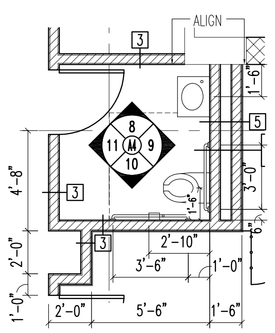

ENLARGED PLAN (7 / A2 | A4)
SCALE: 1/4" =1'-0"

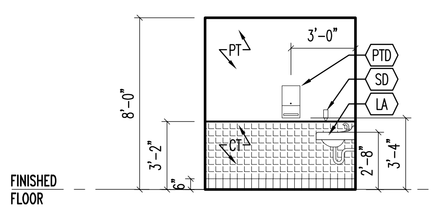

INT. ELEVATION (8 / A4 | A4)
SCALE: 1/4" =1'-0"

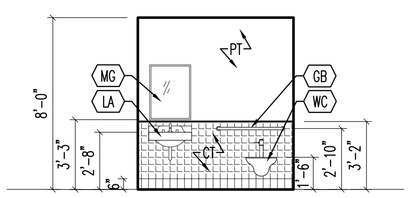

INT. ELEVATION (9 / A4 | A4)
SCALE: 1/4" =1'-0"

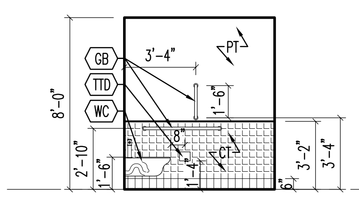

INT. ELEVATION (10 / A4 | A4)
SCALE: 1/4" =1'-0"

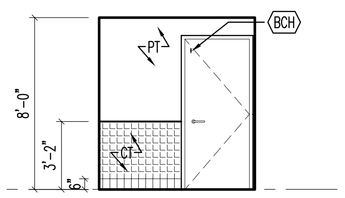

INT. ELEVATION (11 / A4 | A4)
SCALE: 1/4" =1'-0"

LEGEND

BCH	BUMPER COAT HOOK	SNPD	SANITARY NAPKIN DISPOSAL
GB	GRAB BAR	TSCD	(METAL) TOILET SEAT COVER DISPENSER
LA	LAVATORY	TTD	TOILET TISSUE DISPENSER
MG	MIRRORED GLASS	US	URINAL SCREEN
PTD	PAPER TOWEL DISPENSER	WC	WATER CLOSET
SD	SOAP DISPENSER (DECK MNTD)		
X	PARTITION KEY	XHH	ROOM NUMBER KEY
	NEW/INFILL CONSTRUCTION	XX/XXX	SECTION KEY
XX	DOOR KEY	XX/XXX	ELEVATION KEY
XX	WINDOW KEY	XX/XXX	DETAIL KEY
	POINT ELEVATION		

4' 2' 0' 4' 8'
SCALE 1/4" = 1'-0"

8' 4' 0' 8' 16'
SCALE 1/8" = 1'-0"

BID SUBMISSION

Revisions	Date
DOCK SIGNAGE PER VA	JULY 18, 2012

Professional Seal

DCS INFRASTRUCTURE, LLC
MOUNT LAUREL, NEW JERSEY

Hatch Mott MacDonald

Drawing Title: EXTERIOR ELEVATIONS AND INTERIOR ELEVATIONS

Approved : Division Chief

Approved : Service Director

Project Title: FCA RECONFIGURE LOADING DOCK

Building Number: 1 | Checked: RSD | Drawn: JAS

Location: ALTOONA, PENNSYLVANIA

Date: MAY 30, 2012

Project No. 503-11-107

Drawing No. A4

Sht. 7 Of 27

Office of Facilities

Department of Veterans Affairs

P:\298501\DRAWINGS\298501-CURRENT DRAWINGS\298501-A4.DWG 7/18/2012 2:57 PM OIFS0603

P:\298501\Drawings\298501-Current Drawings\298501-A4.dwg, 7/18/2012 2:57:36 PM