DOOR AND FRAME SCHEDULE

DOOR NO.	LOCATION	DOOR SIZE WIDTH	DOOR SIZE HEIGHT	DOOR SIZE THK	DOOR MATERIAL	DOOR TYPE	DOOR FINISH	DOOR FIRE RATING	FRAME SIZE WIDTH	FRAME SIZE HEIGHT	FRAME TYPE	FRAME MATERIAL	FRAME JAMB	FRAME HEAD	FRAME FINISH	FRAME FIRE RATING	THRESHOLD MATERIAL	THRESHOLD DETAIL	HARDWARE SET	REMARKS	DOOR NO.
1	WAREHOUSE	6'-0"	7'-0"	1-3/4"	HM	B	PAINT	1 HR EMCH CONNECTED TO FIRE ALARM	6'-4"	7'-2"	2	HM	J1	H1	PAINT	1 HR	MARBLE	T1	HW-12	PROVIDE PACS	1
OMIT-2	RECEIVING	6'-0"	7'-0"	1-3/4"	HM	B	PAINT	1 HR EMCH CONNECTED TO FIRE ALARM	6'-4"	7'-4"	4	HM	J2	H2	PAINT	1 HR	–	–	HW-12	STL ANG. LINTEL	2 OMIT
3	RECEIVING	8'-0"	10'-0"	–	METAL	C	PAINT	NR	–	–	–	–	–	H4	PAINT	NR	–	–	HW-7	EOD	3
4	CORRIDOR	4'-0"	7'-0"	1-3/4"	HM	A	PAINT	NR	4'-4"	7'-4"	3	HM	J2	H2	PAINT	NR	ALUM	T3	HW-E1	STL ANG. LINTEL	4
5	TRASH COMPACTOR	4'-0"	7'-0"	1-3/4"	HM	A	PAINT	HOLD OPEN CONNECTED TO SECURITY ALARM	4'-4"	7'-4"	3	HM	J2	H2	PAINT	NR	ALUM	T3	HW-E1	STL ANG. LINTEL	5
6	RED BAG STORAGE	3'-0"	7'-0"	1-3/4"	HM	A	PAINT	1 HOUR	3'-4"	7'-2"	1	HM	J1	H1	PAINT	1 HR	–	–	HW-2	–	6
7	TOILET	3'-0"	7'-0"	1-3/4"	HM	A	PAINT	1 HOUR	3'-4"	7'-2"	1	HM	J1	H1	PAINT	1 HR	MARBLE	T2	HW-2	–	7
8	RECYCLING & TRASH	6'-0"	7'-0"	1-3/4"	HM	B	PAINT	1 HR EMCH CONNECTED TO FIRE ALARM	6'-4"	7'-2"	2	HM	J1	H1	PAINT	1 HR	–	–	HW-12	NO PANIC HW.	8
9	BREAKROOM	4'-0"	7'-0"	1-3/4"	HM	A	PAINT	NR	4'-4"	7'-2"	3	HM	J2	H3	PAINT	NR	VINYL	T4	HW-2	EXISTING M.O.	9

GENERAL NOTES:

1. REFER TO SPECIFICATION SECTION #081400 FOR FURTHER INFORMATION

DOOR AND FRAME SCHEDULE REMARKS

EOD – ELECTRIC OPERATED DOOR IS FACTORY FABRICATED COMPLETE UNIT WITH INTEGRAL FRAME, MOTOR, GUIDES, LOCK & ACCESSORIES.

LEGEND

CA	CLEAR ANODIZED	HM	HOLLOW METAL	NR	NOT REQUIRED	VTS	VINYL TRANSITION STRIP
EMCH	ELECTRO-MECHANICAL CLOSER-HOLDER	HW	HARDWARE SET	THK	THICK	WD	WOOD
EX	EXISTING	M	MARBLE	V	VINYL		

ROOM FINISH SCHEDULE

ROOM NUMBER	SPACE	FLOOR	BASE	WALL	CEILING MATERIAL	CEILING HEIGHT	SIGNAGE	REMARKS
W201	BREAKROOM	VCT	VINYL	CONC (P)	PAINT	8'-10"	MATCH EXISTING	
W202	WAREHOUSE	EPOXY	–	PAINT	PAINT	12'-3"	MATCH EXISTING	
W203	RECEIVING	EPOXY	–	PAINT	PAINT	12'-3"	MATCH EXISTING	
W204	ELEVATOR LOBBY	EX	EX	GWB (P)	PAINT	8'-10"	–	
W205	CORRIDOR	QT	QB	GWB (P)	ACT	8'-10"	–	
W206	RED BAG STORAGE	QT	QB	GWB (P)	ACT	8'-10"	MATCH EXISTING	
W207	TOILET	CT	CT	CT/P	ACT	8'-0"	MATCH EXISTING	CT WAINSCOT 3'-2" A.F.F.
W208	RECYCLING & TRASH	QT	QB	GWB (P)	ACT	8'-10"	MATCH EXISTING	

LEGEND

ACT	ACOUSTIC CEILING TILE	EX	EXISTING	QB	QUARRY BASE
CONC	CONCRETE	GWB	GYPSUM WALL BOARD	QT	QUARRY TILE
CT	CERAMIC TILE	(P)	PAINTED	VCT	VINYL COMPOSITION TILE

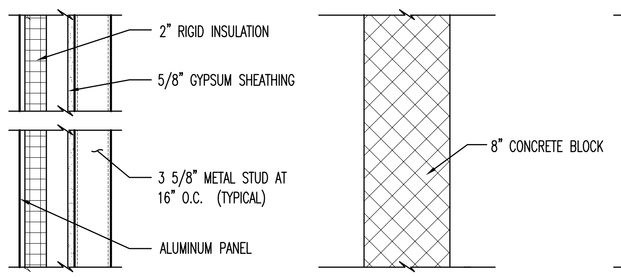

WALL TYPE 1

WALL TYPE 2

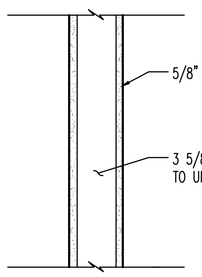

WALL TYPE 3

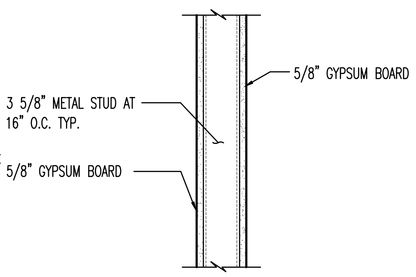

WALL TYPE 4

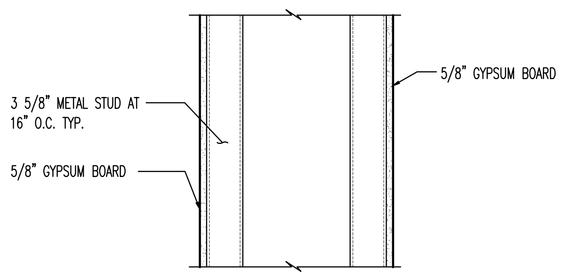

WALL TYPE 5

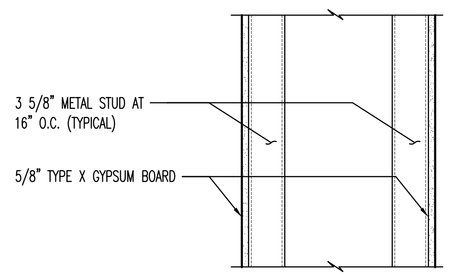

WALL TYPE 6

PROVIDE "J" TRIM AROUND GLAZED BLOCK M.O.

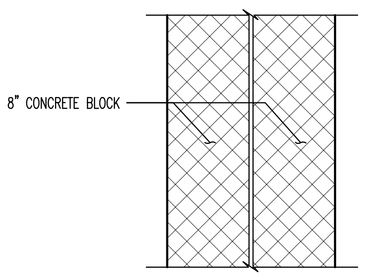

WALL TYPE 7

WALL TYPES
SCALE: 1-1/2" = 1'-0"

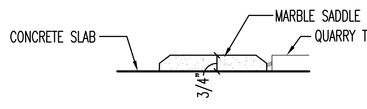

"T1"

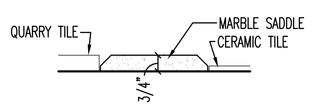

"T2"

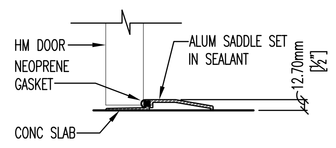

"T3"

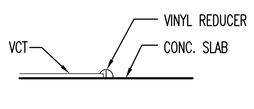

"T4"

DOOR TYPES
SCALE: 1/4" = 1'-0"

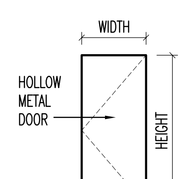

(A)

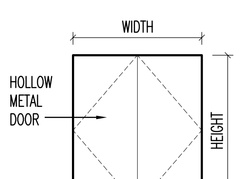

(B)

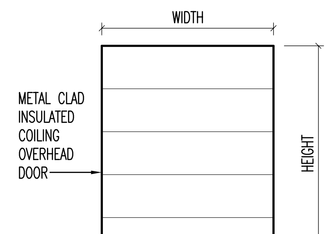

(C)

THRESHOLD/SILL
SCALE: 3" = 1'-0"

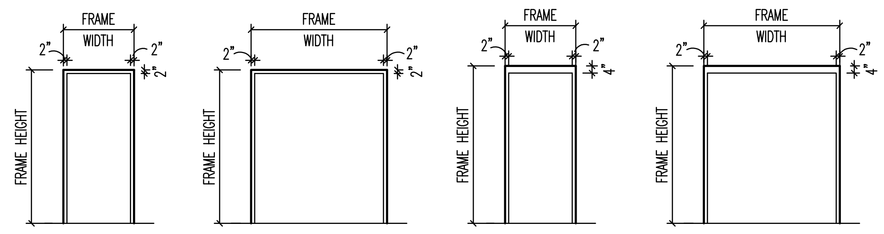

1 2 3 4

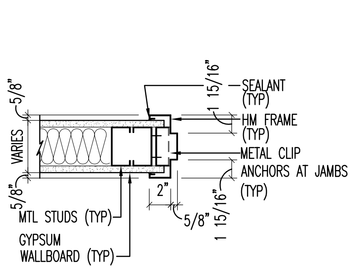

"J1" - "H1"

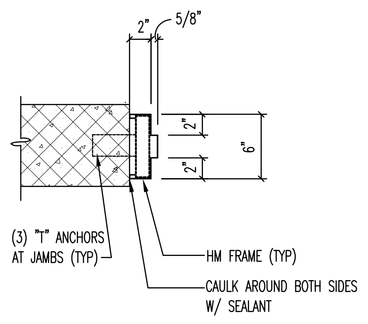

"J2"

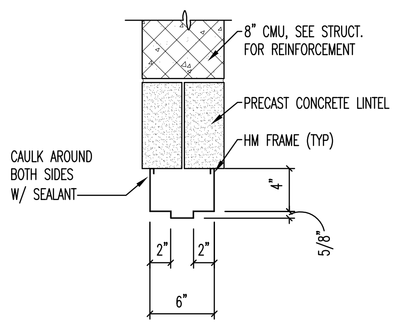

"H2"

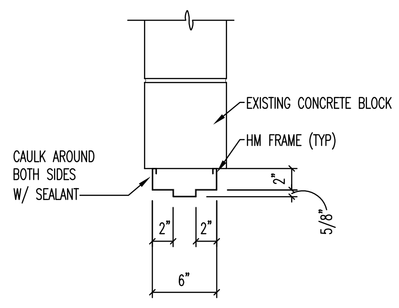

"H3"

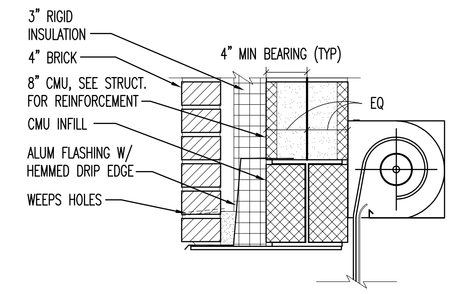

"H4"

FRAME TYPES
SCALE: 1/4" = 1'-0"

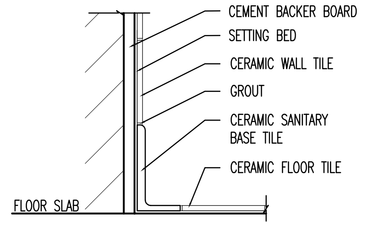

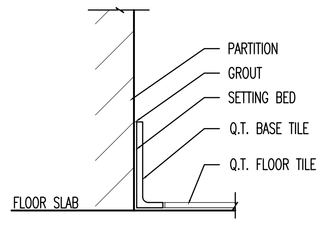

BASE TYPES
SCALE: 3" = 1'-0"

FRAME SECTIONS
SCALE: 1-1/2" = 1'-0"

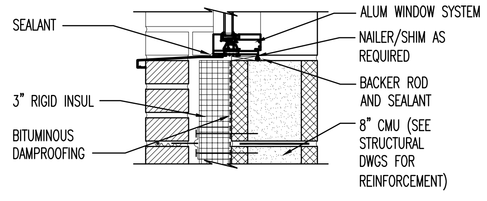

"S1"

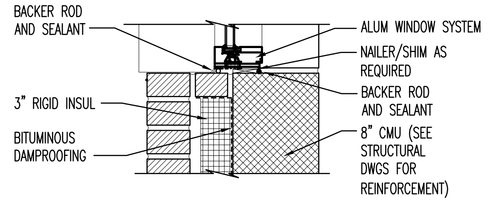

"J3"

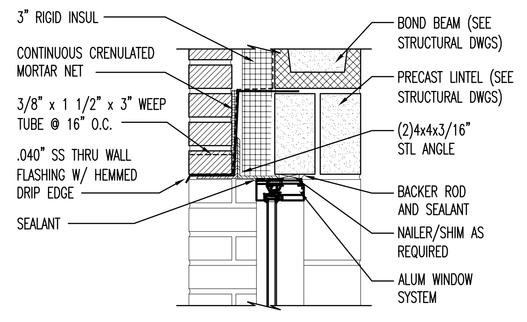

"H5"

2" 0" 2" 4" 6" 1'
SCALE 3" = 1'-0"

1' 0' 1'
SCALE 1 1/2" = 1'-0"

4' 2' 0' 4' 8'
SCALE 1/4" = 1'-0"

BID SUBMISSION

Revisions	Date
DELETE DOOR #2 PER VA	JULY 18, 2012

Professional Seal

DCS INFRASTRUCTURE, LLC
MOUNT LAUREL, NEW JERSEY

Hatch Mott MacDonald

Drawing Title: SCHEDULES AND DETAILS

Approved : Division Chief

Approved : Service Director

Project Title: FCA RECONFIGURE LOADING DOCK

Building Number: 1 | Checked: RSD | Drawn: JAS/ASM

Location: ALTOONA, PENNSYLVANIA

Date: MAY 30, 2012

Project No.: 503-11-107

Drawing No.: A7

Sht. 10 of 27

Office of Facilities

Department of Veterans Affairs

P:\286501\Drawings\286501-Current Drawings\286501-A7.dwg, 7/18/2012 2:57:14 PM

P:\286501\DRAWINGS\286501-CURRENT DRAWINGS\286501-A7.DWG 7/18/2012 2:57 PM CIF50603

