



GENERAL HVAC NOTES

1. THESE DRAWINGS ARE DIAGRAMMATIC & INDICATE THE GENERAL EXTENT OF THE WORK. PROVIDE SHEET METAL SYSTEMS COMPLETE PER SPECIFICATION, SMACNA STANDARDS, AND PER APPLICABLE CODES INCLUDING ALL NECESSARY OFFSETS, FITTINGS, SPECIAL RADIUS OR MITERED ELBOWS WHICH ARE REQUIRED DUE TO SPACE CONSTRAINTS OR OTHER CONDITIONS.
2. CONTRACTOR SHALL COORDINATE HIS WORK WITH THE WORK OF ALL OTHER TRADES. VERIFY ALL CLEARANCES PRIOR TO THE FABRICATION OF ANY WORK.
3. DUCTWORK SHALL NOT BE LOCATED OVER ELECTRICAL EQUIPMENT/PANELS. PROVIDE REQUIRED CLEARANCE IN FRONT OF ELECTRICAL EQUIPMENT. DUCTWORK SHALL NOT INTERFERE WITH ELECTRICAL EQUIPMENT CLEARANCE.
4. THE CONTRACTOR SHALL PROVIDE ALL MISCELLANEOUS SUPPORTING STEEL, ETC. FOR THE PROPER INSTALLATION OF ALL MECHANICAL SYSTEMS.
5. COORDINATE FLOOR, WALL, ROOF PENETRATIONS, LOUVER SIZES, PAD LOCATIONS ETC. WITH ARCHITECTURAL TRADES.
6. BRANCH DUCTWORK TO GRILLES, REGISTERS AND DIFFUSERS SHALL BE THE SAME SIZE AS THE GRILLE, REGISTER OR DIFFUSER NECK SIZE WHERE NO DUCT SIZE IS INDICATED ON PLAN.
7. MAXIMUM LENGTH OF FLEXIBLE DUCT SHALL BE 5'-0".

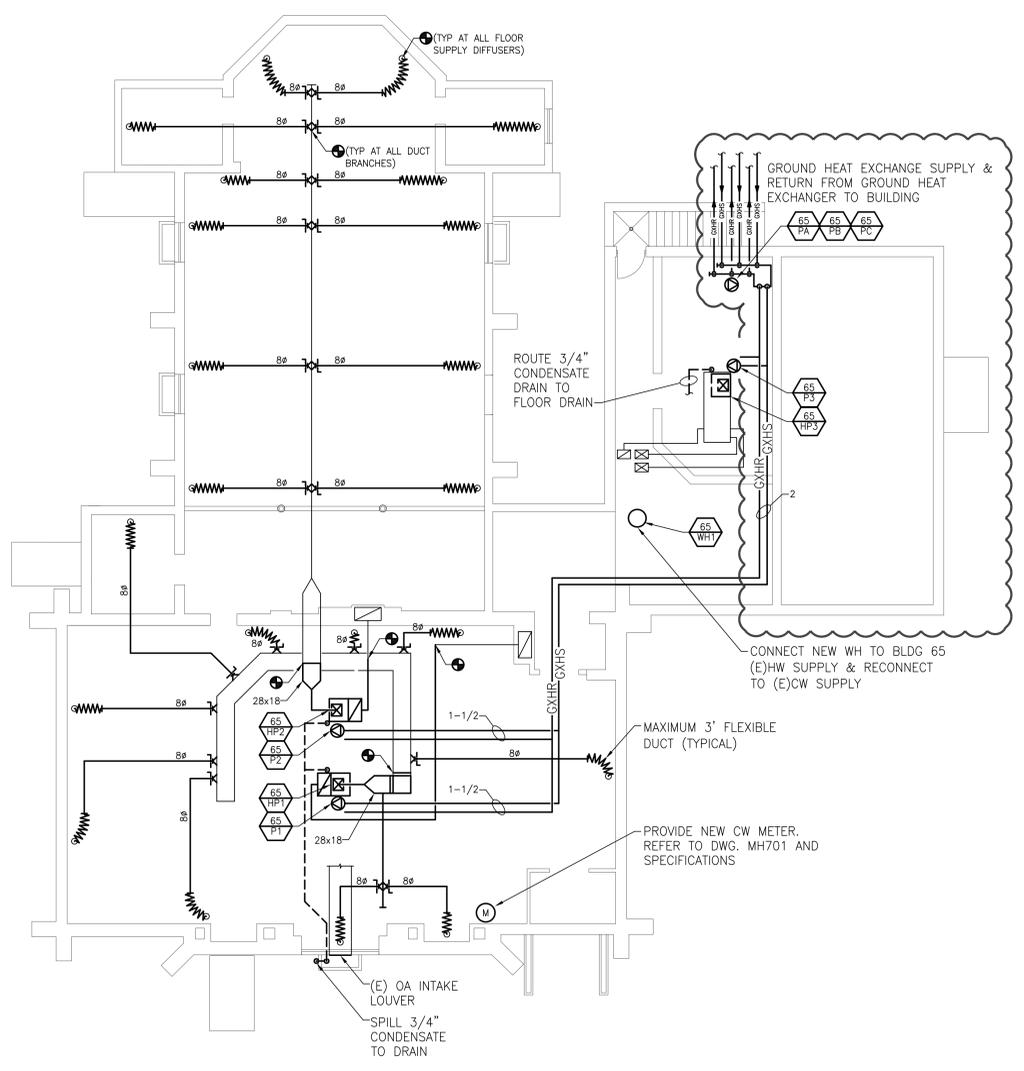

BUILDING 65 BASEMENT MECHANICAL PLAN
SCALE 1/8" = 1'-0"

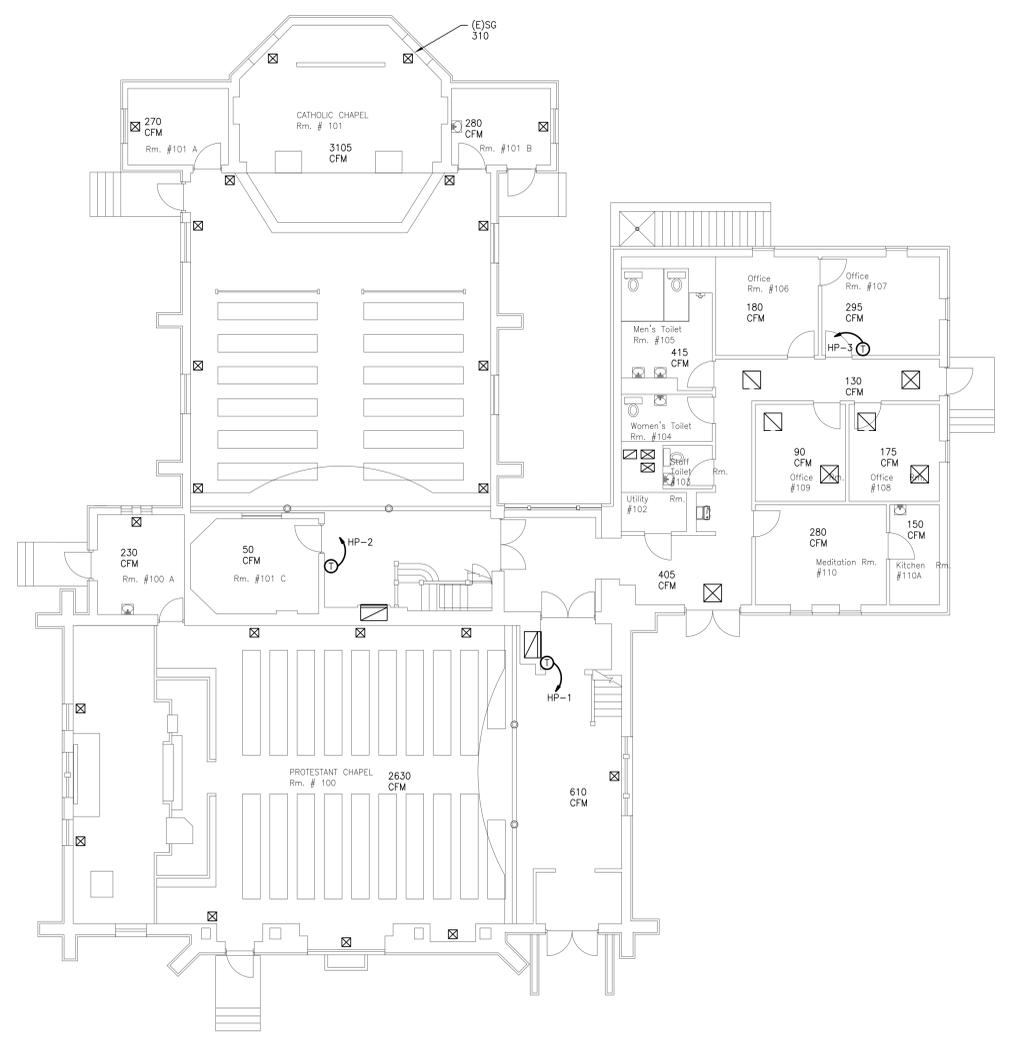

BUILDING 65 FIRST FLOOR MECHANICAL PLAN
SCALE 1/8" = 1'-0"

BID DOCUMENTS	08-14-11
100% CONSTRUCTION DRAWINGS	07-14-11
90% CONSTRUCTION DRAWINGS	06-08-11
50% DD	02-22-11
35% DD	01-12-11
Revisions	Date

CONSULTANTS: MONUMENT ENGINEERING GROUP ASSOCIATES



P.O. BOX 1039
SOUTH GRAND AVE.
FOWLERVILLE,
MICHIGAN 48836
(OFFICE) 517-223-3512
(FAX) 517-223-9987
Copyright © MEGA, L.L.C.

ARCHITECT/ENGINEERS:

Drawing Title:
BUILDING 65 MECHANICAL PLAN

Approved: Project Director

Project Title:
**GROUND SOURCE HEAT PUMP PHASE II
VA HEALTH CARE SYSTEM**

Location:
VA - MARION, INDIANA

Date: 02-22-11

Checked: SDS

Drawn: KTB

Project Number:
2010 536 02

Building Number:
65

Drawing Number:
MH103

Dwg. 20 of 34

**Office of
Construction
and Facilities
Management**



Department of
Veterans Affairs