


THIS LAYOUT IS REFLECTIVE OF THE LATEST SALES CONFIGURATION. ANY CHANGES TO THIS SALES CONFIGURATION MAY REQUIRE A REVISION TO THIS PROJECT PLAN.

VISUAL RADIATION INDICATOR IS INCLUDED WITH THE SYMBIA AND LOCATED ON THE PATIENT BOOM ARM ACCORDING TO IEC 60601-2-44 AND 21 CFR.

SIEMENS HIGHLY RECOMMENDS THE CUSTOMER'S ARCHITECT DESIGNATES SPACE FOR A HOT LAB, PATIENT WAITING AREA, AND UPTAKE ROOM.

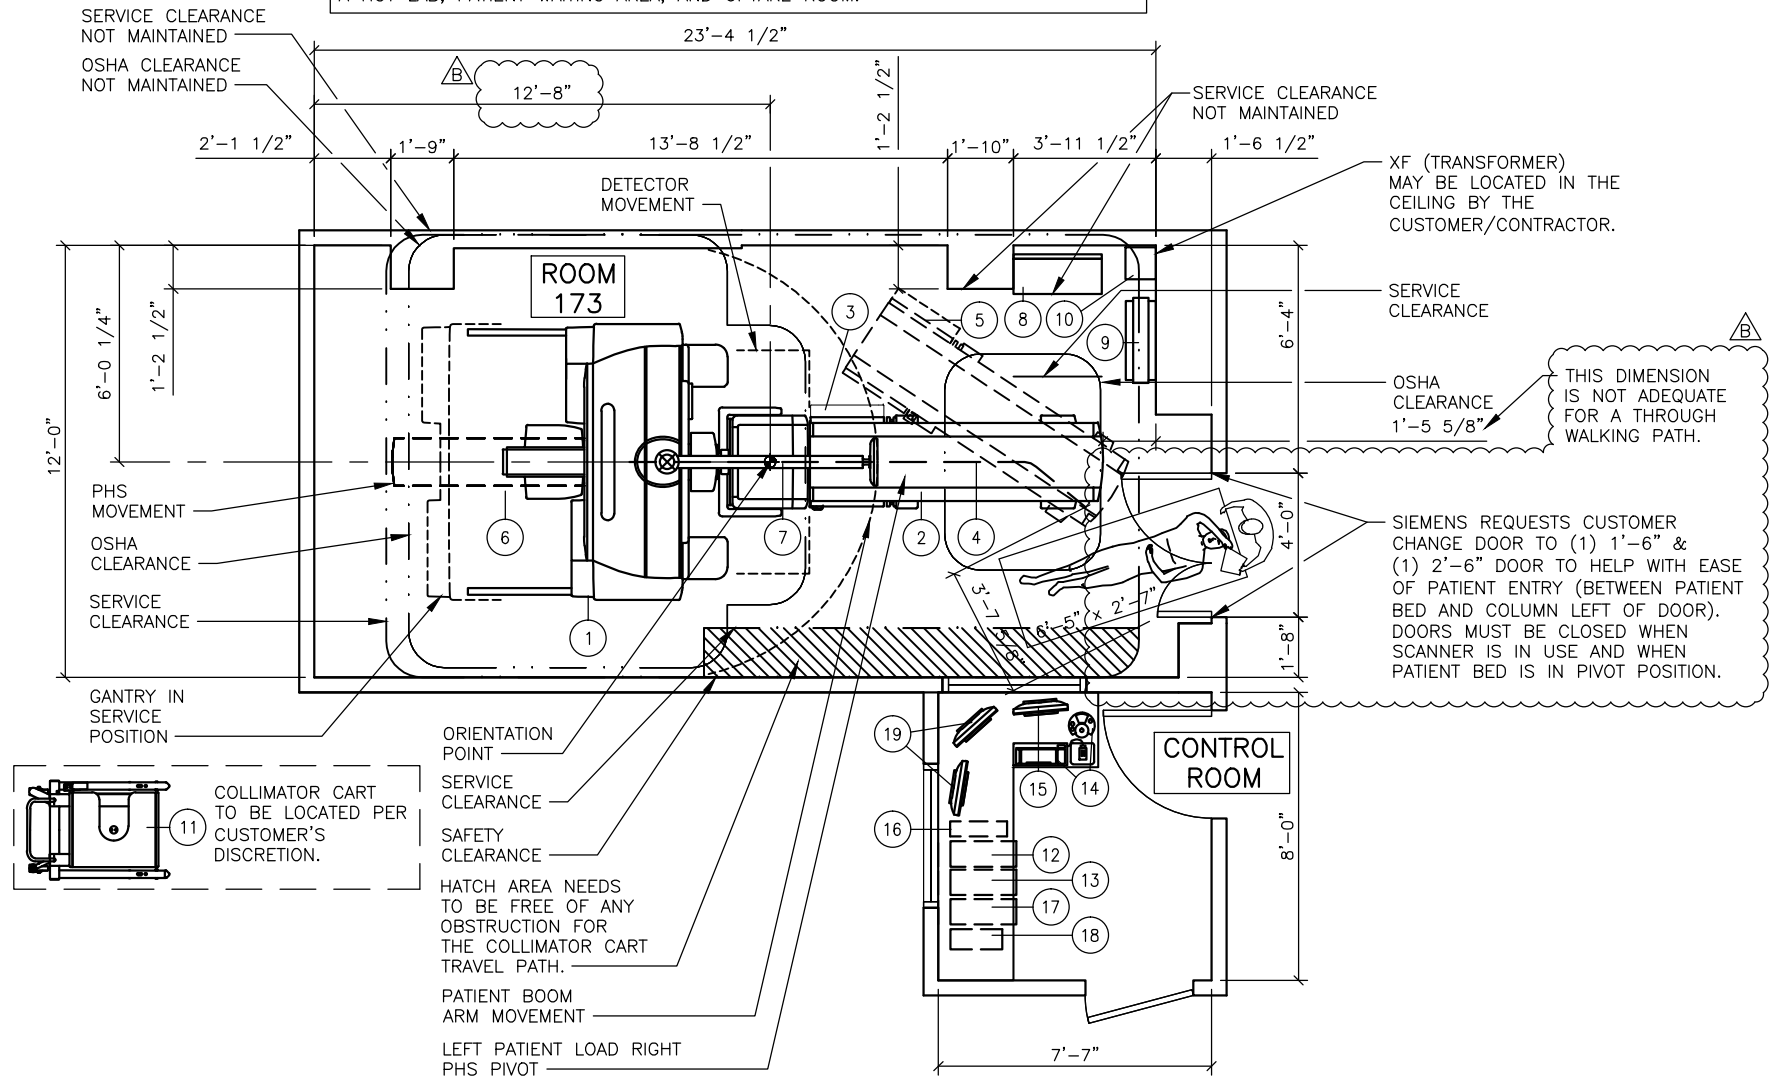

SCALE: 3/16" = 1'-0"

**SIEMENS**

**1603580**

PROJECT MANAGER: STEVE GAINES  
PHONE: (254) 541-2992  
EMAIL: STEVE.GAINES@SIEMENS.COM

**VA TEMPLE 674**

1901 SOUTH 1ST STREET, TEMPLE, TX 76504

**ROOM 173 - SYMBIA INTEVO 6**

REFERENCE DOCUMENT - NOT FOR CONSTRUCTION

B 09/27/16 ORIENTATION POINT CHANGE.

SHEET OF  
1 2

DATE:  
09/27/16

DRAWN BY:  
C. SCHANZ

REF:  
1-HNOGF4

EQUIPMENT LEGEND								
NO	DESCRIPTION	SMS SYM	WEIGHT (LBS)	BTU/HR TO AIR	DIMENSIONS (INCHES)			REMARKS
					W	D	H	
1	SYMBIA INTEVO 6 GANTRY W/COLLIMATORS	Ⓢ	7,413	24,574	93	84 1/2	90 1/2	6,826 BTU ON STANDBY. WORST CASE WEIGHT 7,963 LBS. WITH (2) HIGH ENERGY COLLIMATORS AT 275 LBS. EACH
2	FRONT PHS	Ⓢ	2,512	—	31 1/8	97 1/2	23 3/16	MAXIMUM HEIGHT 41"
3	SYMBIA INTEVO—ACC WITH ADC — PRODUCTIVITY PACKAGE (OPTION)	Ⓢ	658	—	31 1/8	97 1/2	23 3/16	WEIGHT CALCULATED WITH 1 SET LOW AND MEDIUM ENERGY COLLIMATORS.
4	UNDER THE FLOOR PHS CABLE STANDARD	Ⓢ	—	—	—	—	—	UNDER FLOOR
5	PHS STANDARD PIVOT	Ⓢ	—	—	—	—	—	STANDARD PIVOT — 33 DEGREES
6	REAR PHS WITH SNAC	Ⓢ	415.3	—	—	—	—	ON FLOOR
7	PATIENT BOOM SWING ARM	Ⓢ	—	—	—	—	—	—
8	LINE CONNECTION BOX	Ⓢ	227	1,365	29 1/2	11 3/4	32	ON FLOOR
9	UPS FOR SPECT (OPTION)	Ⓢ	120	1,024	10	28 3/8	17 7/8	ON FLOOR
10	TRANSFORMER REQUIRED WITH UPS FOR SPECT (SPS) (OPTION)	Ⓢ	—	—	—	—	—	CUSTOMER SUPPLIED PRIOR TO INSTALLATION. SEE POWER SCHEDULE
11	COLLIMATOR CART (EMPTY) (OPTION)	Ⓢ	400	—	47 3/8	32 5/8	47 1/2	WORST CASE 1330 LBS. WITH 1 SET HE AND 1 SET ME
12	IMAGE CONSTRUCTION SYSTEM FOR SYNGO MI (ACQUISITION) WORKPLACE	Ⓢ	66	2,389	8	22	18	OFF FLOOR.
13	IMAGE RECONSTRUCTION SYSTEM FOR SYNGO MI (ACQUISITION) WORKPLACE	Ⓢ	66	*	8	22	18	OFF FLOOR. *BTU'S INCL. WITH ICS
14	CONTROL AND KEYBOARD	Ⓢ	—	—	—	—	—	ON CUSTOMER'S COUNTER
15	18" MONITOR	Ⓢ	31	—	18 3/8	2 5/8	14 13/16	ON CUSTOMER'S COUNTER
16	SYNGO MI (ACQUISITION) WORKPLACE UPS FOR IMS STANDARD COMPONENT	Ⓢ	70	—	5	19	17 1/4	OFF FLOOR.
17	DEDICATED RECONSTRUCTION SYSTEM WORKPLACE — STANDARD INTEVO 6	Ⓢ	55	*	8	20 3/4	18	OFF FLOOR. *BTU'S INCL. WITH ICS
18	UPS FOR E.SOFT/C.CAM (OPTION)	Ⓢ	67	—	6 3/4	17 1/2	8 1/2	ON FLOOR
19	(2) ADDITIONAL MONITOR (DUAL MONITOR) (OPTION)	Ⓢ	31	—	20	19	20	ON CUSTOMER'S COUNTER

## ARCHITECTURAL NOTES

- 1) ALL PRELIMINARY EQUIPMENT LAYOUTS SUBMITTED BY SIEMENS HEALTHCARE ARE BASED ON THE RECOMMENDED SPACE NECESSARY FOR THE OPERATION AND SERVICEABILITY OF THE EQUIPMENT BEING PROPOSED. SIEMENS WILL NOT SUBMIT AN EQUIPMENT LAYOUT THAT IS NOT IN THE BEST INTEREST OF BOTH THE CUSTOMER AND SIEMENS. ALL EQUIPMENT LAYOUTS ARE BASED EITHER ON AN ACTUAL SITE LOCATION SURVEY OR ARCHITECTURAL DRAWINGS SUPPLIED TO SIEMENS. SIEMENS WILL NOT BE RESPONSIBLE FOR ANY ALTERATIONS THAT ENCROACH WITHIN DESIGNATED SAFETY AND SERVICE CLEARANCE ZONES AS INDICATED ON DRAWINGS (I.E. PIPE CHASES, VENTILATION DUCTS, CASEWORK, AND SOFFITS, ETC.) MADE BY THE CUSTOMER OR REQUIRED BY A CUSTOMER'S ARCHITECTURAL FIRM ONCE PRELIMINARY DRAWINGS HAVE BEEN SUBMITTED AND APPROVED. DO NOT ALTER ANY SPECIFICATIONS AND/OR DIMENSIONS WITHOUT CONTACTING AND RECEIVING WRITTEN CONFIRMATION FROM SIEMENS PROJECT MANAGER.
- 2) SIEMENS HEALTHCARE IS NOT AN ARCHITECTURAL OR ENGINEERING FIRM. DRAWINGS SUPPLIED BY SIEMENS ARE NOT CONSTRUCTION DRAWINGS. THEREFORE, THESE DRAWINGS ARE TO BE USED ONLY FOR INFORMATION TO COMPLEMENT ACTUAL CONSTRUCTION DRAWINGS AVAILABLE FROM A CUSTOMER APPOINTED ARCHITECTURAL REPRESENTATIVE OR A CUSTOMER'S ENGINEERING DESIGN GROUP. THE CUSTOMER'S ARCHITECT AND GENERAL CONTRACTOR SHALL BE ULTIMATELY RESPONSIBLE FOR COMPLIANCE WITH ALL APPLICABLE CODES AND PROFESSIONAL DESIGN REQUIREMENTS.
- 3) THE CUSTOMER IS RESPONSIBLE FOR ALL ROOM AND AREA PREPARATION COSTS, PROFESSIONAL FEES, PERMITS, REPORTS, AND INSPECTION FEES.
- 4) EQUIPMENT WARRANTIES, EXPRESSED OR IMPLIED ON THE PART OF SIEMENS SHALL BE CONTINGENT UPON STRICT COMPLIANCE WITH THE ARCHITECTURAL, STRUCTURAL, ELECTRICAL, MECHANICAL AND RECOMMENDATIONS AND REQUIREMENTS CONTAINED IN THESE DRAWINGS, UNLESS SPECIFIED OTHERWISE.
- 5) ALL DIMENSIONS SHOWN ARE TAKEN FROM FINISHED SURFACES UNLESS SPECIFIED OTHERWISE.
- 6) THIS DRAWING DOES NOT PROVIDE RADIATION SHIELDING REQUIREMENTS FOR X-RAY AND ASSOCIATED EQUIPMENT. THE CUSTOMER IS RESPONSIBLE FOR CONSULTING WITH A REGISTERED RADIATION PHYSICIST. ACTUAL PROTECTION REQUIREMENTS SHALL BE SPECIFIED BY A REGISTERED RADIATION PHYSICIST AT CUSTOMER'S ENGAGEMENT AND EXPENSE. RESPONSIBILITY FOR ALL INFORMATION AS TO THE ROOM LOCATION, USE, AND NUMBER OF ANTICIPATED EXAMINATIONS TO BE PERFORMED PER TIME PERIOD SHALL BE PROVIDED TO THE PHYSICIST BY THE CUSTOMER. THE CUSTOMER SHALL FURTHER TAKE ALL RESPONSIBILITY IN THE COMMUNICATION AND COORDINATION OF ACTIVITIES OF THE RADIATION PHYSICIST AND THE ARCHITECTURAL REPRESENTATIVE.
- 7) SIEMENS HEALTHCARE SHALL BE RESPONSIBLE FOR SIEMENS EQUIPMENT INSTALLATION AND CALIBRATION, CONNECTION AND INSTALLATION OF SIEMENS PROVIDED CABLES. THE CUSTOMER/ELECTRICAL CONTRACTOR IS RESPONSIBLE FOR TERMINATIONS OF CUSTOMER/ELECTRICAL CONTRACTOR—SUPPLIED CABLES TO SIEMENS EQUIPMENT. IN THE EVENT THAT SPECIFIC TRADE RULES OR LICENSE REQUIREMENTS PROHIBIT THIS, THE CUSTOMER SHALL INITIATE THE SERVICES OF APPROVED OTHER CONTRACTORS AND PAY FOR SELECTED, APPROVED PARTIES TO PERFORM THIS WORK WITH JOB SUPERVISION TO BE PROVIDED BY SIEMENS. CALIBRATION WHEN ACCOMPLISHED OUTSIDE OF NORMAL INSTALLATION SEQUENCES DUE TO CONTRACTOR OR TRADE RULE ACTIONS OR REQUIREMENTS SHALL BE SUPPORTED BY, CHARGED TO, AND ACCEPTED BY THE CUSTOMER AS AN ADDITIONAL INSTALLATION EXPENSE.
- 8) THE CUSTOMER SHALL VERIFY WITH SIEMENS PROJECT MANAGER FINAL INSTALLATION DRAWINGS THE LOCATIONS AND TRAVEL OF ALL ANCILLARY EQUIPMENT TO BE CEILING OR WALL MOUNTED (I.E.: O.R. LIGHTS, MEDICAL GAS COLUMNS, PHYSIOLOGICAL MONITORING INJECTORS, CRT PLATFORMS, SPRINKLER HEADS, SMOKE DETECTORS, ELECTRICAL OUTLETS, HVAC GRILLES, SPEAKERS, AND GENERAL ROOM LIGHTING, ETC.).
- 9) THE GENERAL CONTRACTOR/CUSTOMER SHALL BE RESPONSIBLE FOR ALL FINAL PAINT, TOUCH-UP AND ANY COSMETIC OR TRIM WORK WHICH NEEDS TO BE OR IS REQUIRED TO BE COMPLETED AFTER THE INSTALLATION OF THE SIEMENS EQUIPMENT AND ANY ASSOCIATED SUPPORT APPARATUS.

FOR ADDITIONAL PLANNING RELATED QUESTIONS, PLEASE REFER TO TYPICAL DRAWING SET OR SIEMENS PROJECT MANAGEMENT.

### RESTRICTIONS:

1. NOT ALL SAFETY REQUIREMENTS ARE MET. IT IS THE RESPONSIBILITY OF THE OWNER TO PROVIDE SAFETY MEASURES IN ACCORDANCE WITH LOCAL CODES, FOR EXAMPLE BARRIERS, WARNING SIGNS, AND SAFETY SWITCH PLATES. AS OUTLINED BELOW, THE SQUARE FOOTAGE ALLOCATED BY THE CUSTOMER MAY CAUSE CRAMPED OR UNSAFE CONDITIONS DURING CERTAIN PROCEDURES. SAFETY PRECAUTIONS MUST BE OBSERVED AND ARE THE RESPONSIBILITY OF THE CUSTOMER. IN ADDITION, FUTURE UPGRADES AND OPTIONS MAY NOT BE AVAILABLE DUE TO INSUFFICIENT ROOM SIZE.
2. SERVICE CLEARANCE HAS NOT BEEN MAINTAINED IN SOME AREAS AS INDICATED ON THE PLAN.
3. OSHA CLEARANCE HAS NOT BEEN MAINTAINED IN SOME AREAS AS INDICATED ON THE PLAN.
4. THIS DIMENSION IS NOT ADEQUATE SPACE FOR A THROUGH WALKING PATH AS INDICATED ON THE PLAN.

### WARNINGS:

1. THERE IS NO VIEW DOWN THE BORE OF THE GANTRY FROM THE CONTROL ROOM AREA.

### Authorization:

I have reviewed the below referenced plan(s) and understand and agree with the proposed room configuration and equipment arrangement. By signing below, I agree that I have the authority to sign on behalf of the customer. I have been fully informed by Siemens about the limitations (if applicable) that exist regarding the proposed equipment installation. Siemens has explained that the listed limitations may interfere with certain functions of the equipment. We agree to assume responsibility to inform employees, agents, contractors, users or any other persons handling this equipment of these limitations and will assure that the equipment is handled in compliance with these parameters.

Signature: \_\_\_\_\_ Date: \_\_\_\_\_

Name Printed: \_\_\_\_\_ Title: \_\_\_\_\_

PROJECT MANAGER: STEVE GAINES  
PHONE: (254) 541-2992  
EMAIL: STEVE.GAINES@SIEMENS.COM

### VA TEMPLE 674

1901 SOUTH 1ST STREET, TEMPLE, TX 76504

**SIEMENS**

B 09/27/16 ORIENTATION POINT CHANGE.

SHEET OF  
2 2

DATE:  
09/27/16

DRAWN BY:  
C. SCHANZ

REF:  
1-HNOGF4

**ROOM 173 - SYMBIA INTEVO 6**  
REFERENCE DOCUMENT - NOT FOR CONSTRUCTION

**1603580**