

REVISION #6	12/8/10
REVISION #5	11/2/10
REVISION #4	6/15/10
REVISION #3	6/8/10
REVISION #2	6/29/10
REVISION #1	5/24/10
100% SUBMISSION	
Revisions	Date

VA WESTERN NEW YORK HEALTHCARE SYSTEM
222 RICHMOND AVENUE
BATAVIA, NEW YORK 14020



ROBERT'S SHACKLETON
ARCHITECTS AND ENGINEERS



WENDEL
ARCHITECTS AND ENGINEERS

66 CATTARAUGUS ROAD
WESTERN NEW YORK, NY 14025
PHONE: 716/867-0122
E-MAIL: design@shackleton.com

140 JAMES JAMES BUILDING
BATAVIA, NY 14020
PHONE: 716/867-0122

Architect

Engineer

INFECTION CONTROL	DATE	CARELINE MANAGER	DATE
SAFETY OFFICER	DATE	CHIEF OF STAFF	DATE

ENGINEERING MANAGER	DATE
ASSOCIATE MEDICAL CENTER DIRECTOR	DATE

Project Title	Bldg. 1 WARD 'E' SWING WARD BLDG. 3 ENGINEERING OFFICES
Building Number	1.3
Checked	Drawn
Location	V.A.M.C. BATAVIA, NEW YORK

Drawing Title	FURNITURE LAYOUT
Project Title	Bldg. 1 WARD 'E' SWING WARD BLDG. 3 ENGINEERING OFFICES
Building Number	1.3
Checked	Drawn
Location	V.A.M.C. BATAVIA, NEW YORK

Date	MAY 28, 2010
Section No.	52844-10-203
10-203-A104	

Office of Facilities



Department of Veterans Affairs

WARD 'E' FURNITURE PLAN


SCALE: 1/8"=1'-0"




KEY PLAN
SCALE: NONE

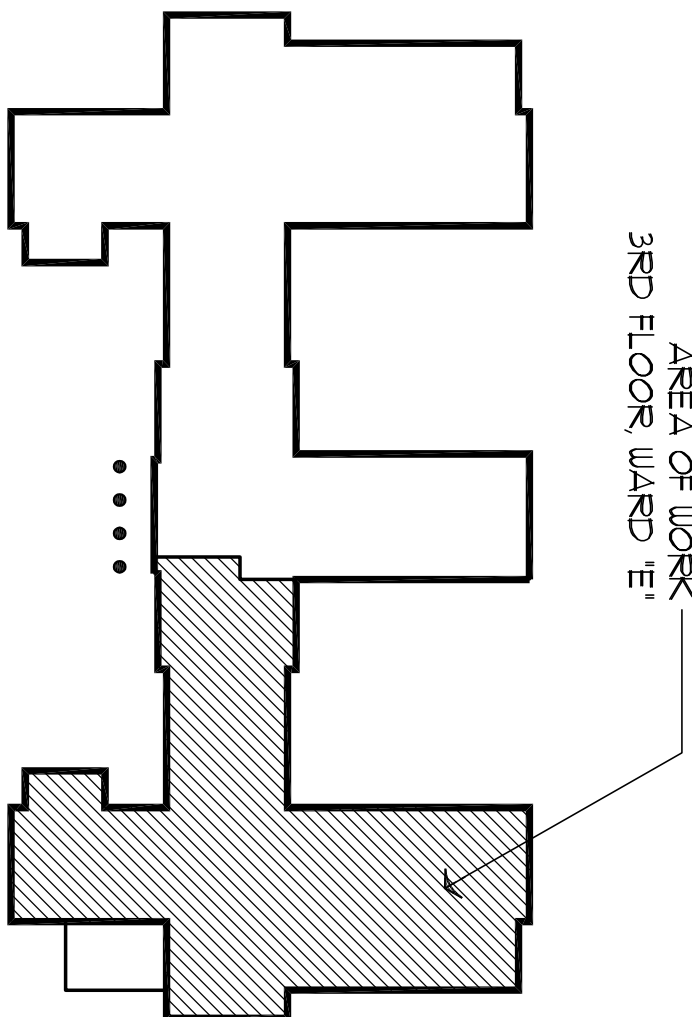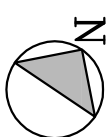

AREA OF WORK
3RD FLOOR WARD 'E'

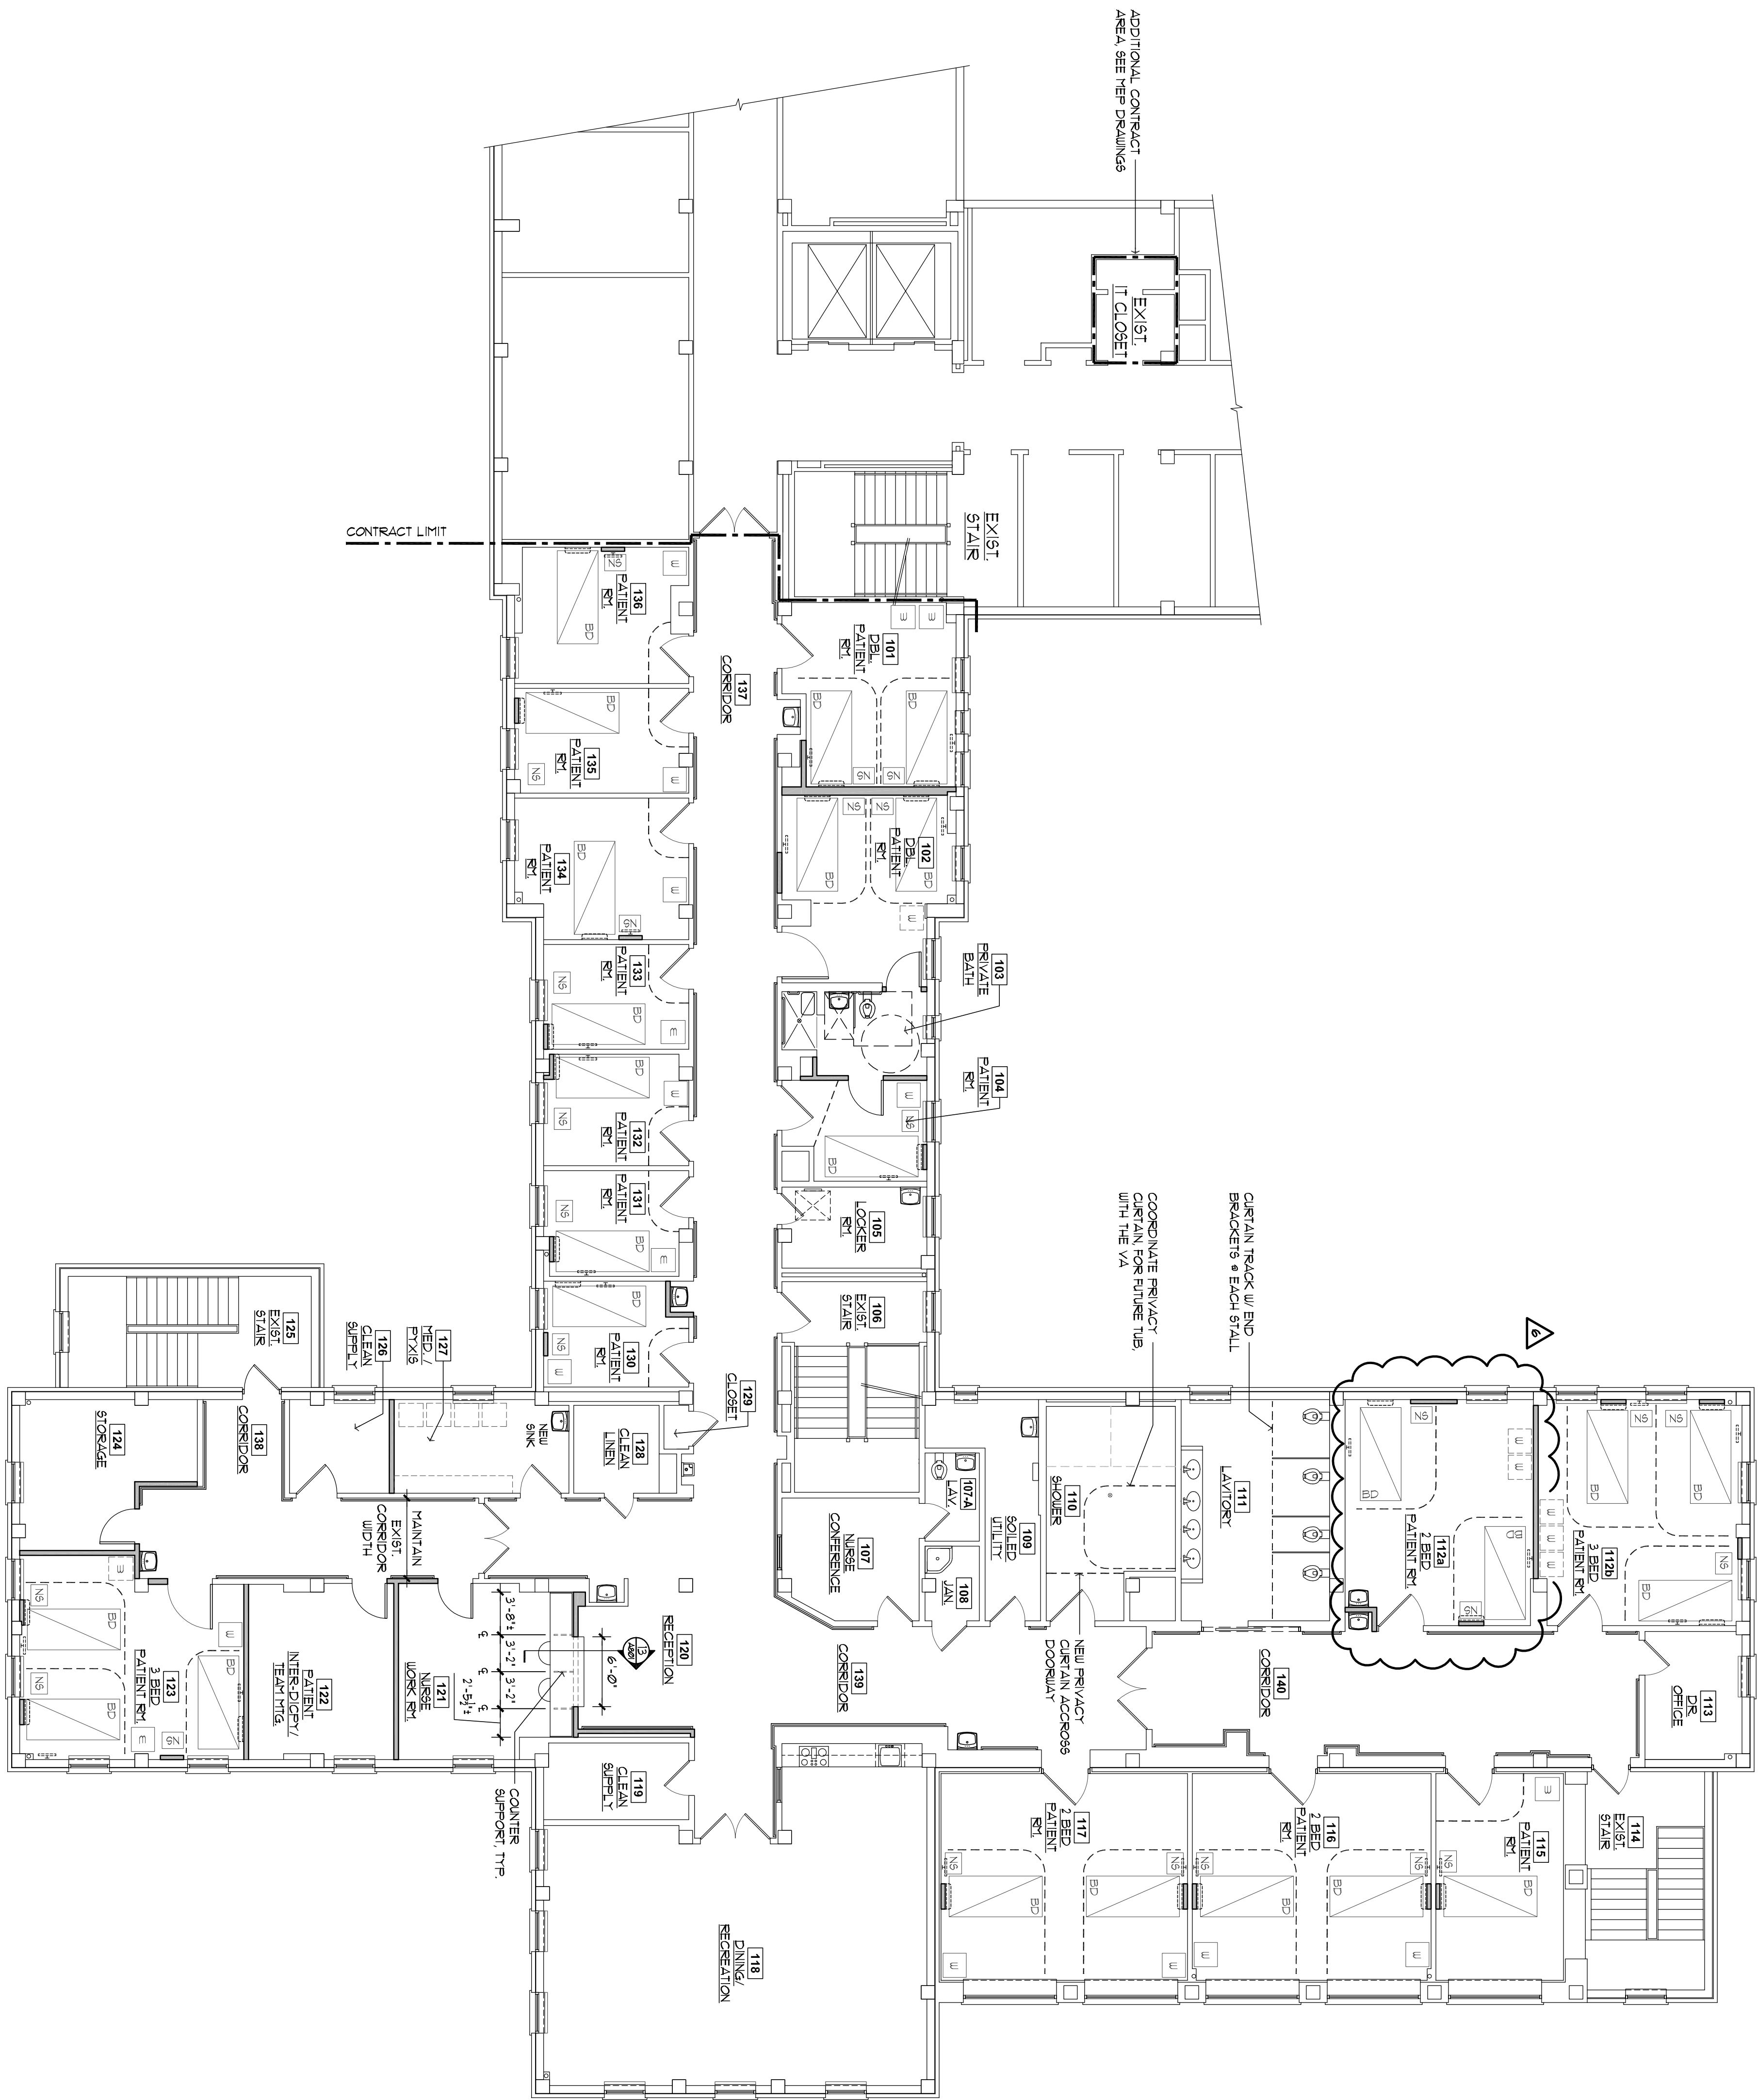

CONSTRUCTION KEY

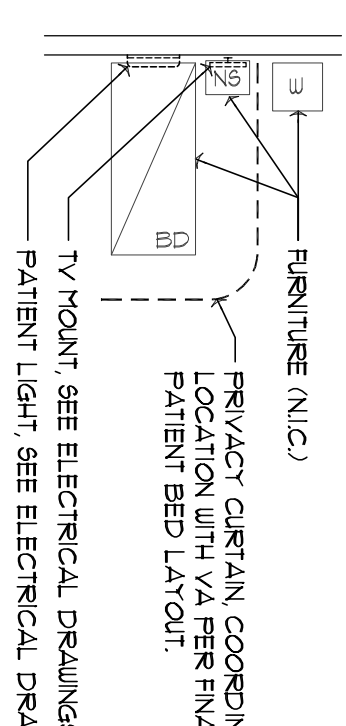

FURNITURE (NIC)
PRIVACY CURTAIN COORDINATE
PATIENT LIGHT