


**ATTACHMENT 07 - PIPING PLAN Part 5**  
**36C25818R0178 - Legionella Prevention**  
**8 May 2018**

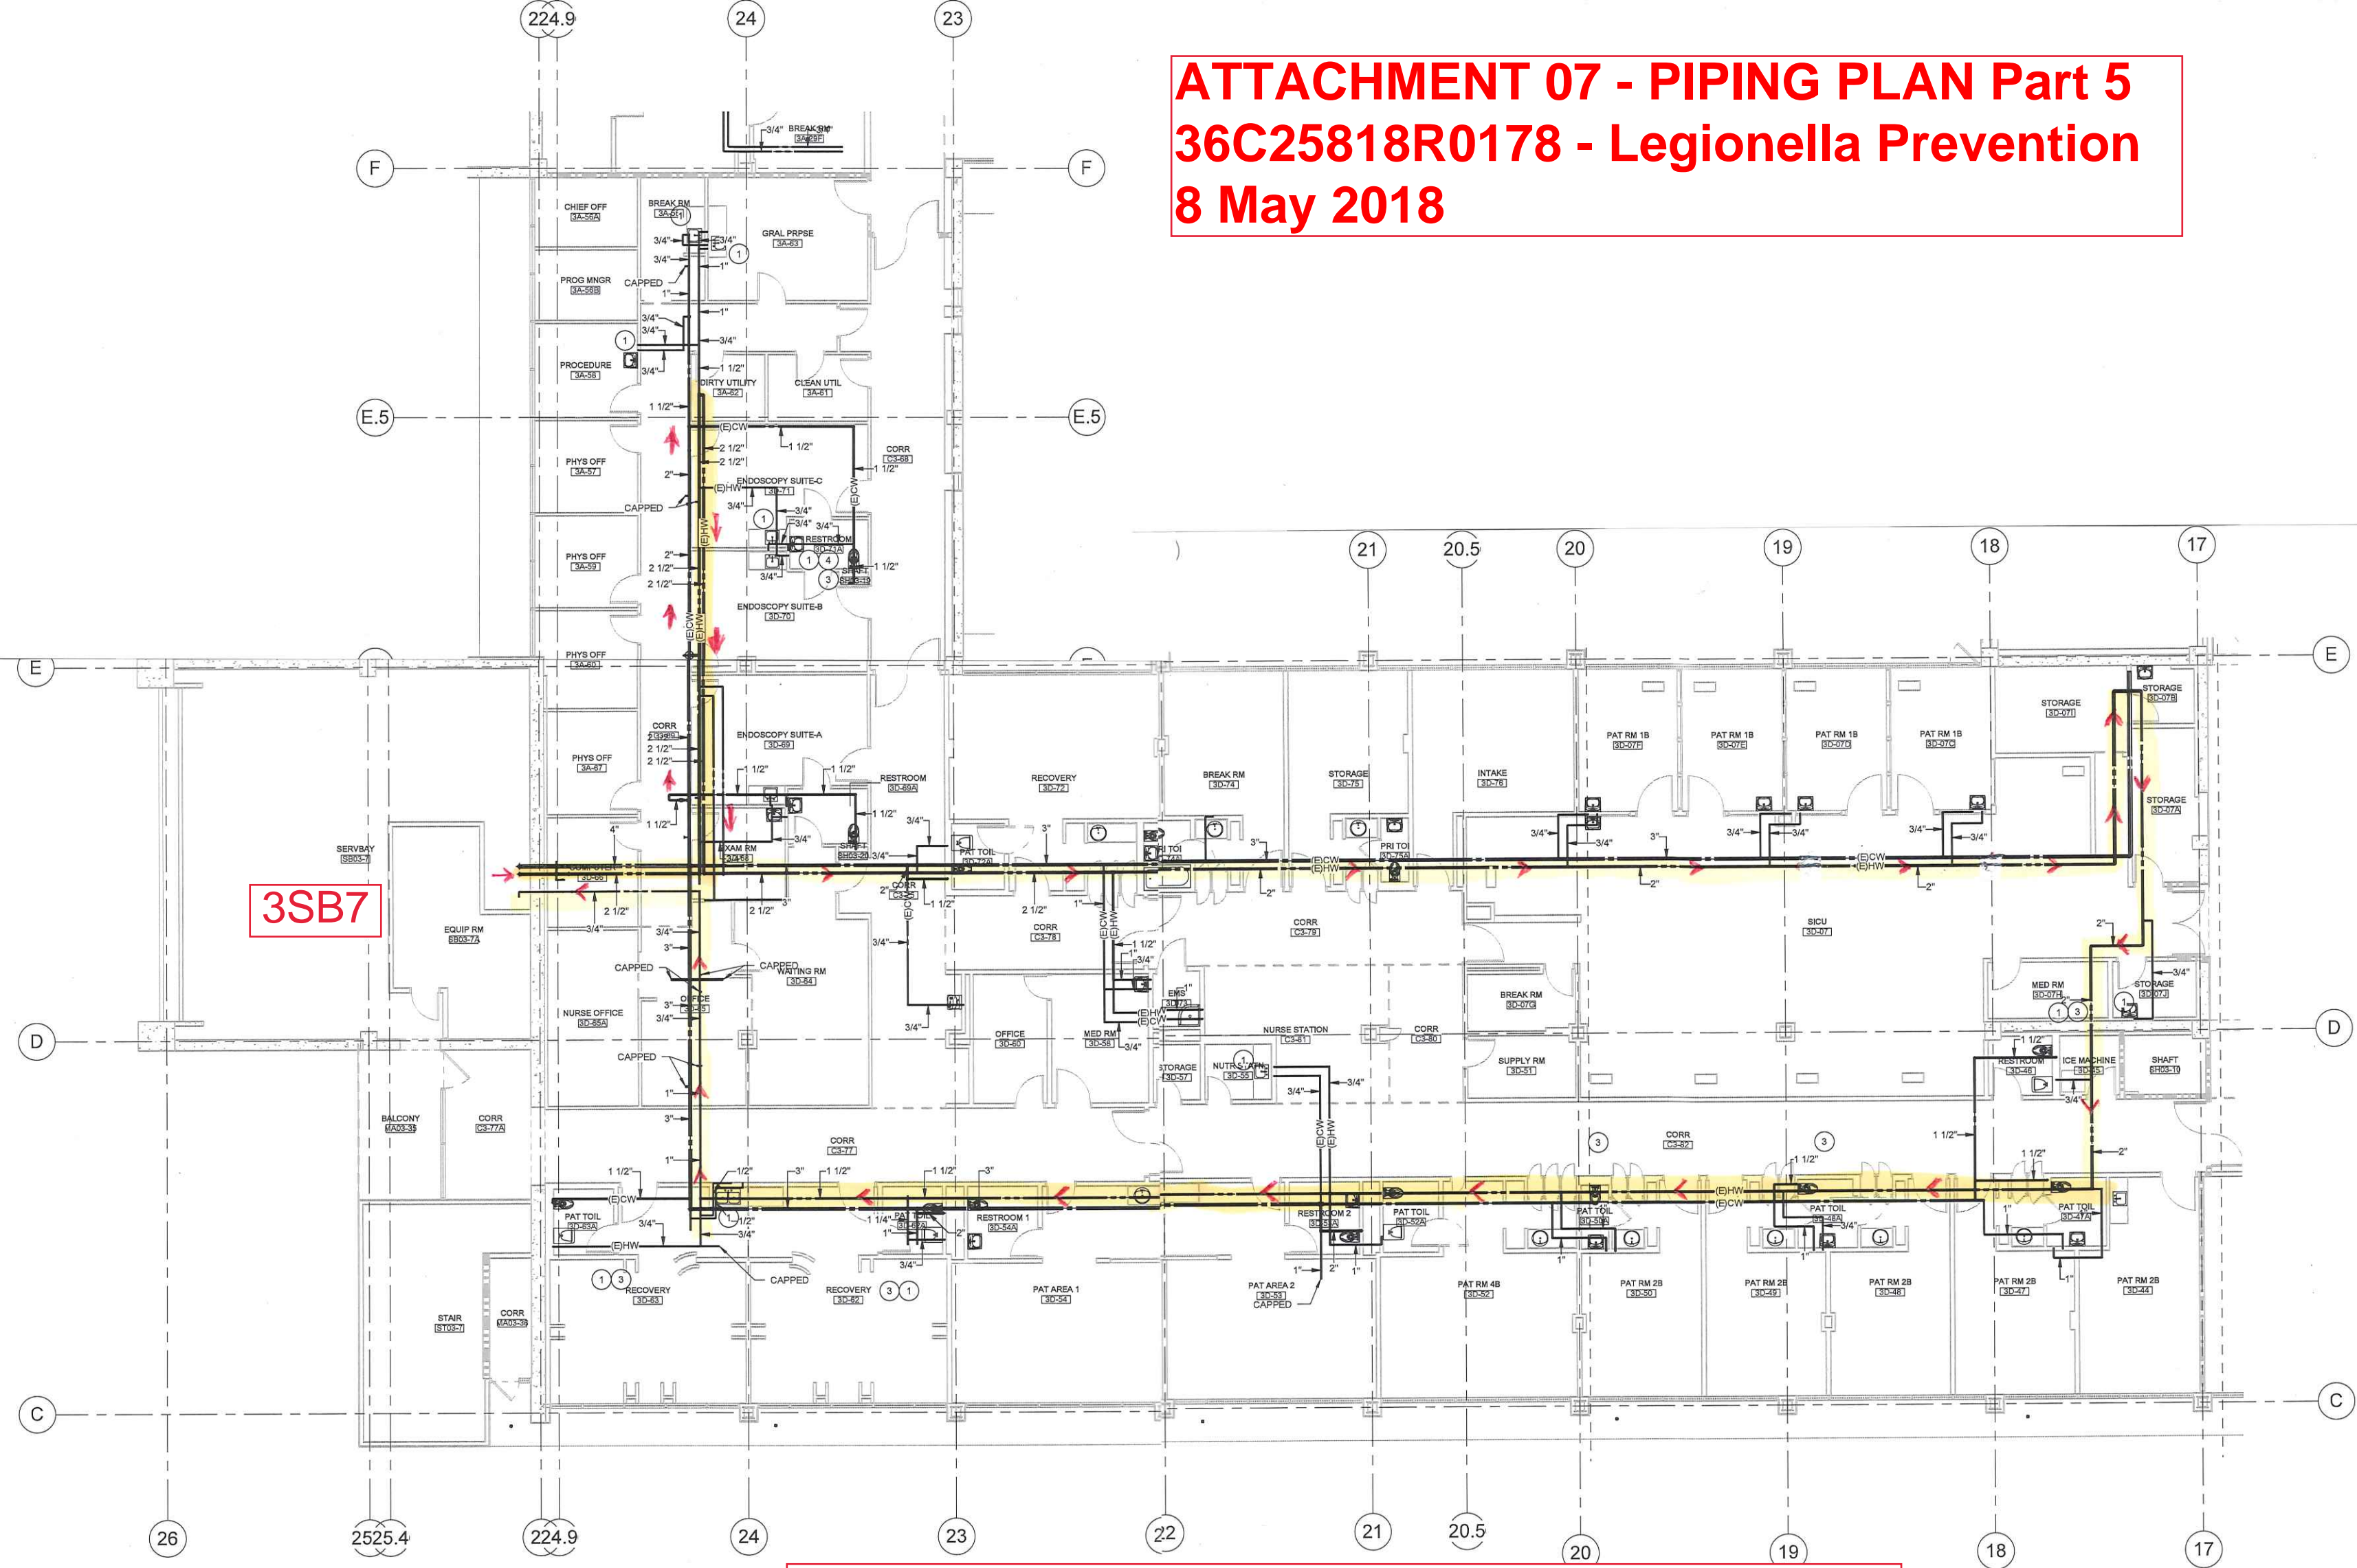

**3SB7 - SICU-GI CW, HW, HWR Piping Plan**

SICU / GI / SHORT 5