


NOTE: This sketch does NOT utilize actual flooring plank sizes- actual layout should be based off of product modules.

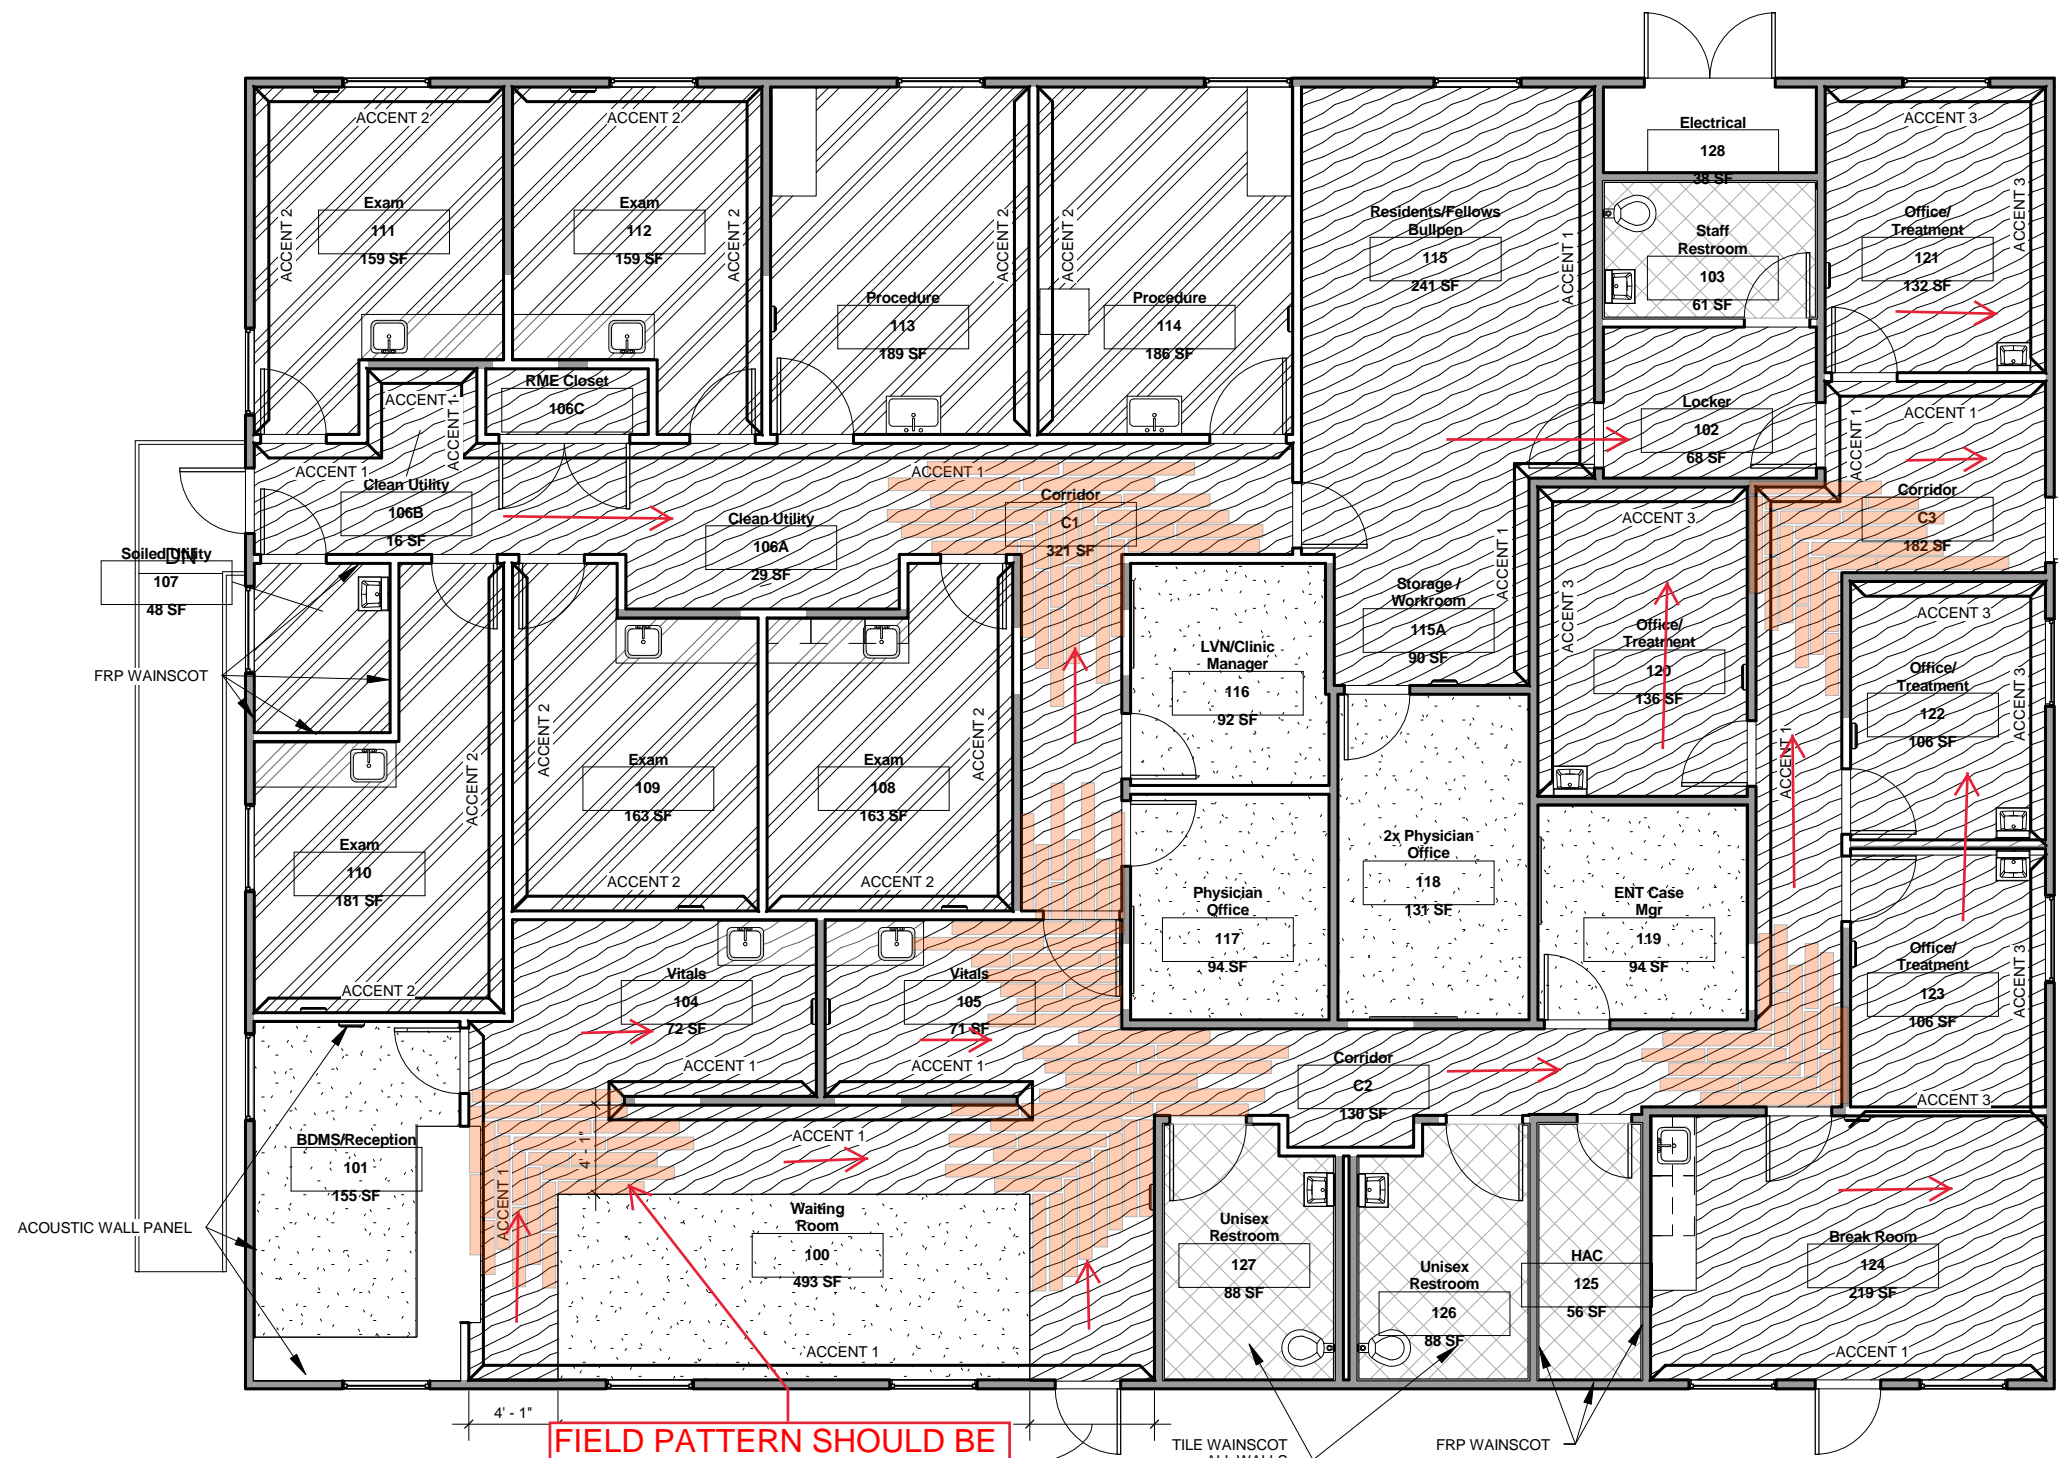

- FLOORS:**
- CERAMIC TILE (DALTILE)
W/ 48"H CERAMIC TILE WAINSCOT ABOVE 6" COVED TILE BASE IN RESTROOMS
W/ 48"H OF FRP PANEL ABOVE 6" COVED TILE BASE IN HAC
 - HEAT WELDED RESILIENT SHEET
W/ 6" INTEGRAL COVED BASE
 - CARPET (INTERFACE)
W/ 4" COVED RESILIENT BASE
 - LVT (INTERFACE)
W/ 4" COVED RESILIENT BASE
- WALLS:**
- TYPICAL PAINT: EGGSHELL, (KELLY MOORE)
RESTROOMS/HAC: EPOXY, COLOR TO MATCH TYPICAL
- ACCENT 1: EGGSHELL (COMMON AREAS)
ACCENT 2: EGGSHELL (ENT EXAM/PROC.)
ACCENT 3: EGGSHELL (S+LP)
- DOOR FRAMES: SEMI-GLOSS
ACOUSTIC WALL PANEL
FRP (SOILED UTILITY AND HAC CLOSET)
- MILLWORK:**
- CASEWORK: WILSONART LAMINATE
COUNTERS: CORIAN
DOORS: WOOD TO MATCH EXISTING

1 Level 1 Finish Plan
1/8" = 1'-0"

FIELD PATTERN SHOULD BE STANDARD RANDOMIZED-PATTERNED ALIGNMENT SHOULD BE AT "CORNER ZIGS" ONLY



AUTODESK
www.autodesk.com/revit

ENT / S+LP
BLDG 722

No.	Description	Date

INTERIOR FINISH PLAN		
Project number	N/A	A-200
Date	9/3/17	
Drawn by	C.PEREIRA	
Checked by	T.DILTS	
Scale 1/8" = 1'-0"		