


Location of work
in building 5. All
flooring in this
room to be
replaced.

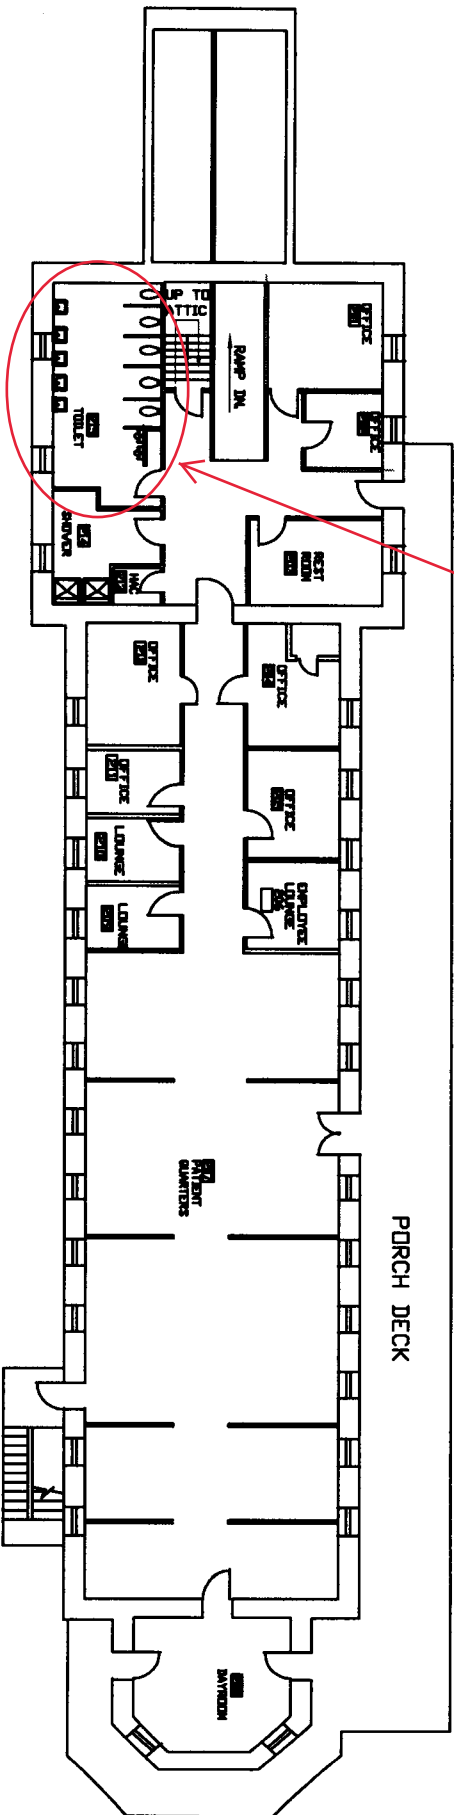

SECOND FLOOR BLDG. #5

