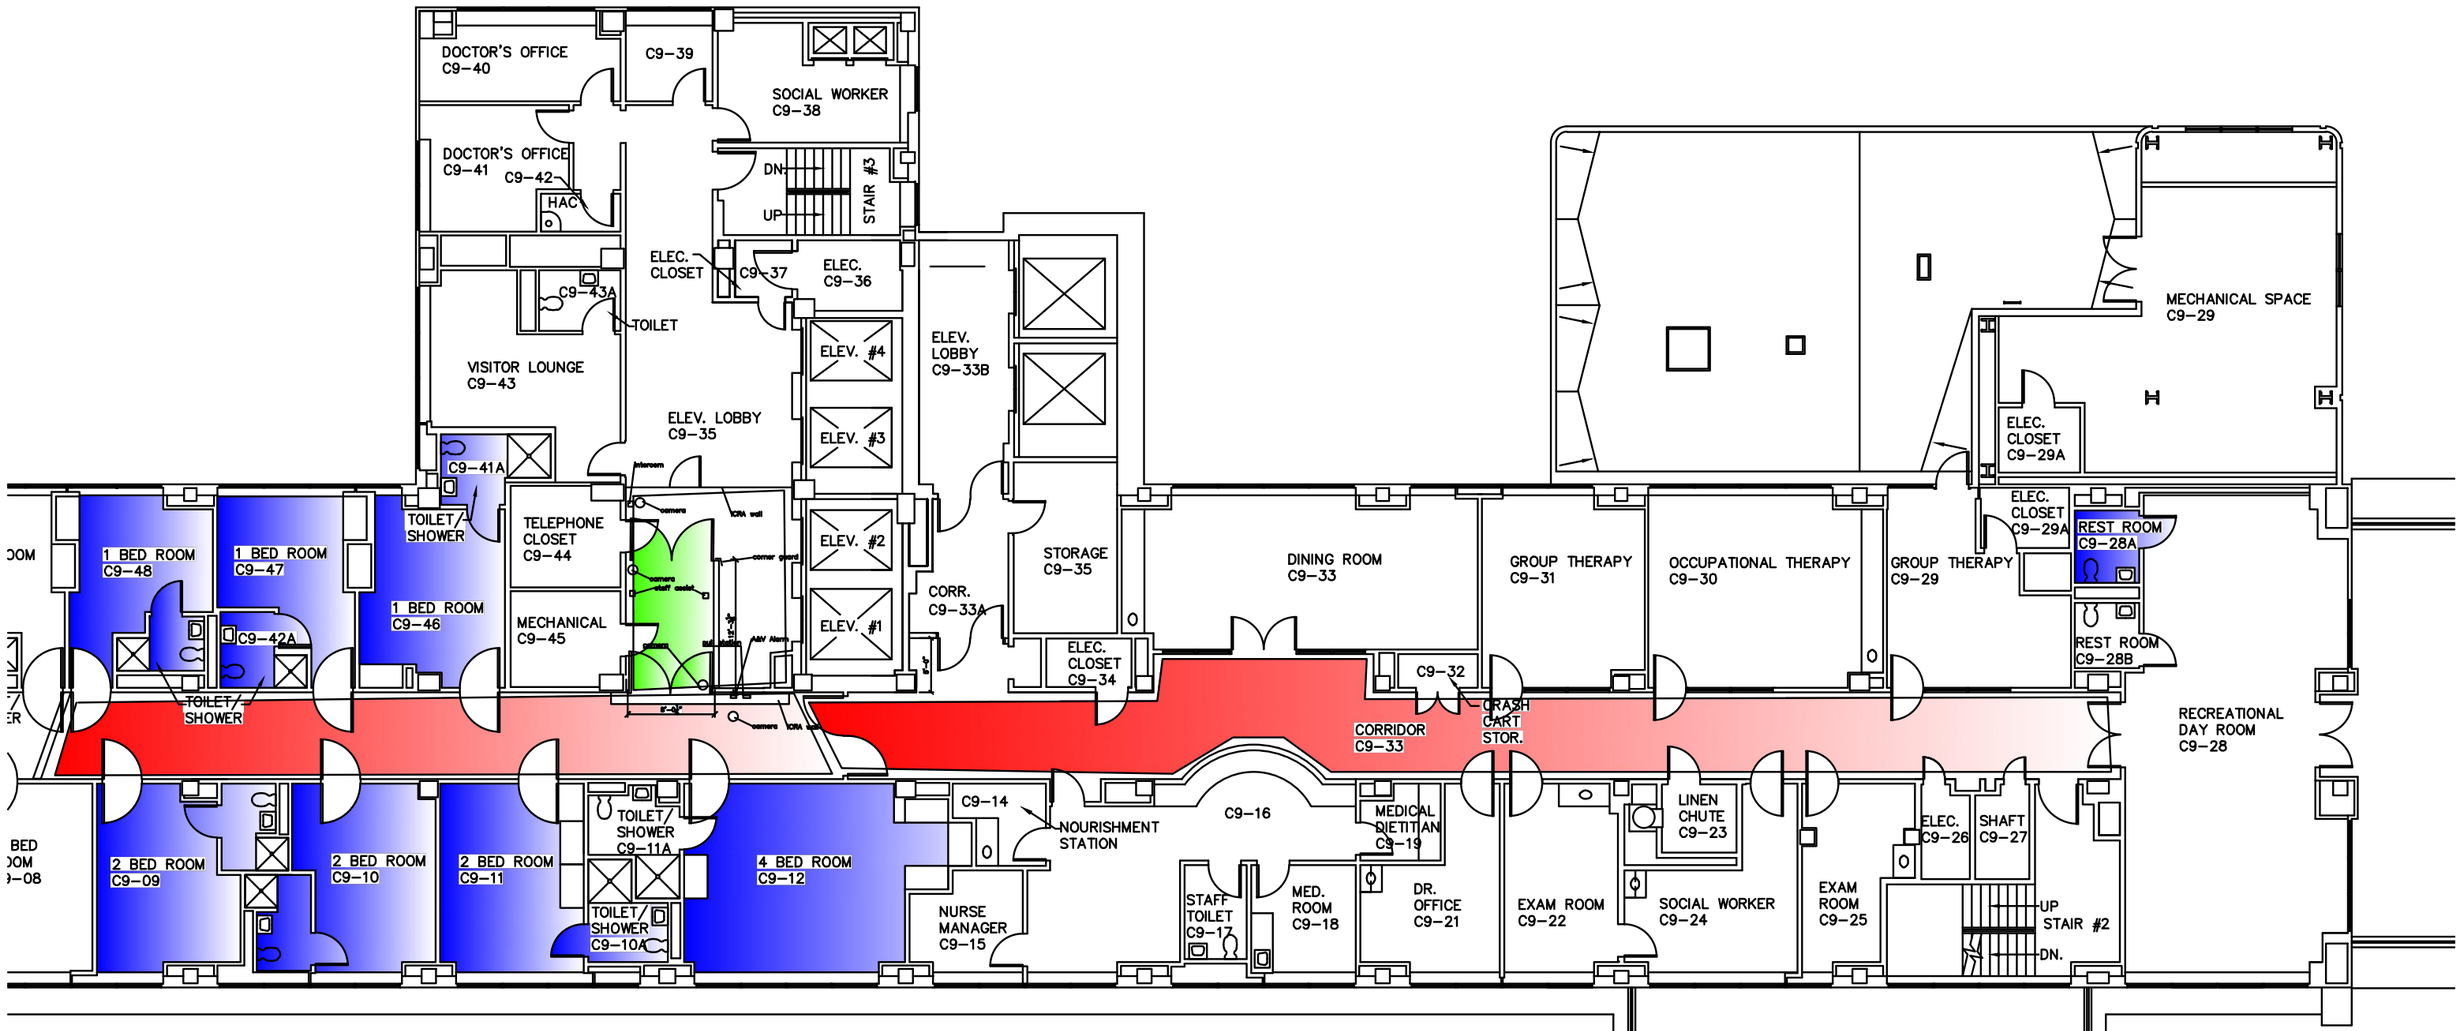


1) blue area, nurse call, sinks, thermostat and shower doors.
2) red area handrails.
3) Sally port area.