




three inches = one foot  
one and one half inches = one foot  
one inch = one foot  
three quarters inch = one foot  
one half inch = one foot  
three eighths inch = one foot  
one quarter inch = one foot  
one eighth inch = one foot

SHEET NOTES

- A REFER TO SHEET E001 FOR ADDITIONAL NOTES.  
B NOT USED.

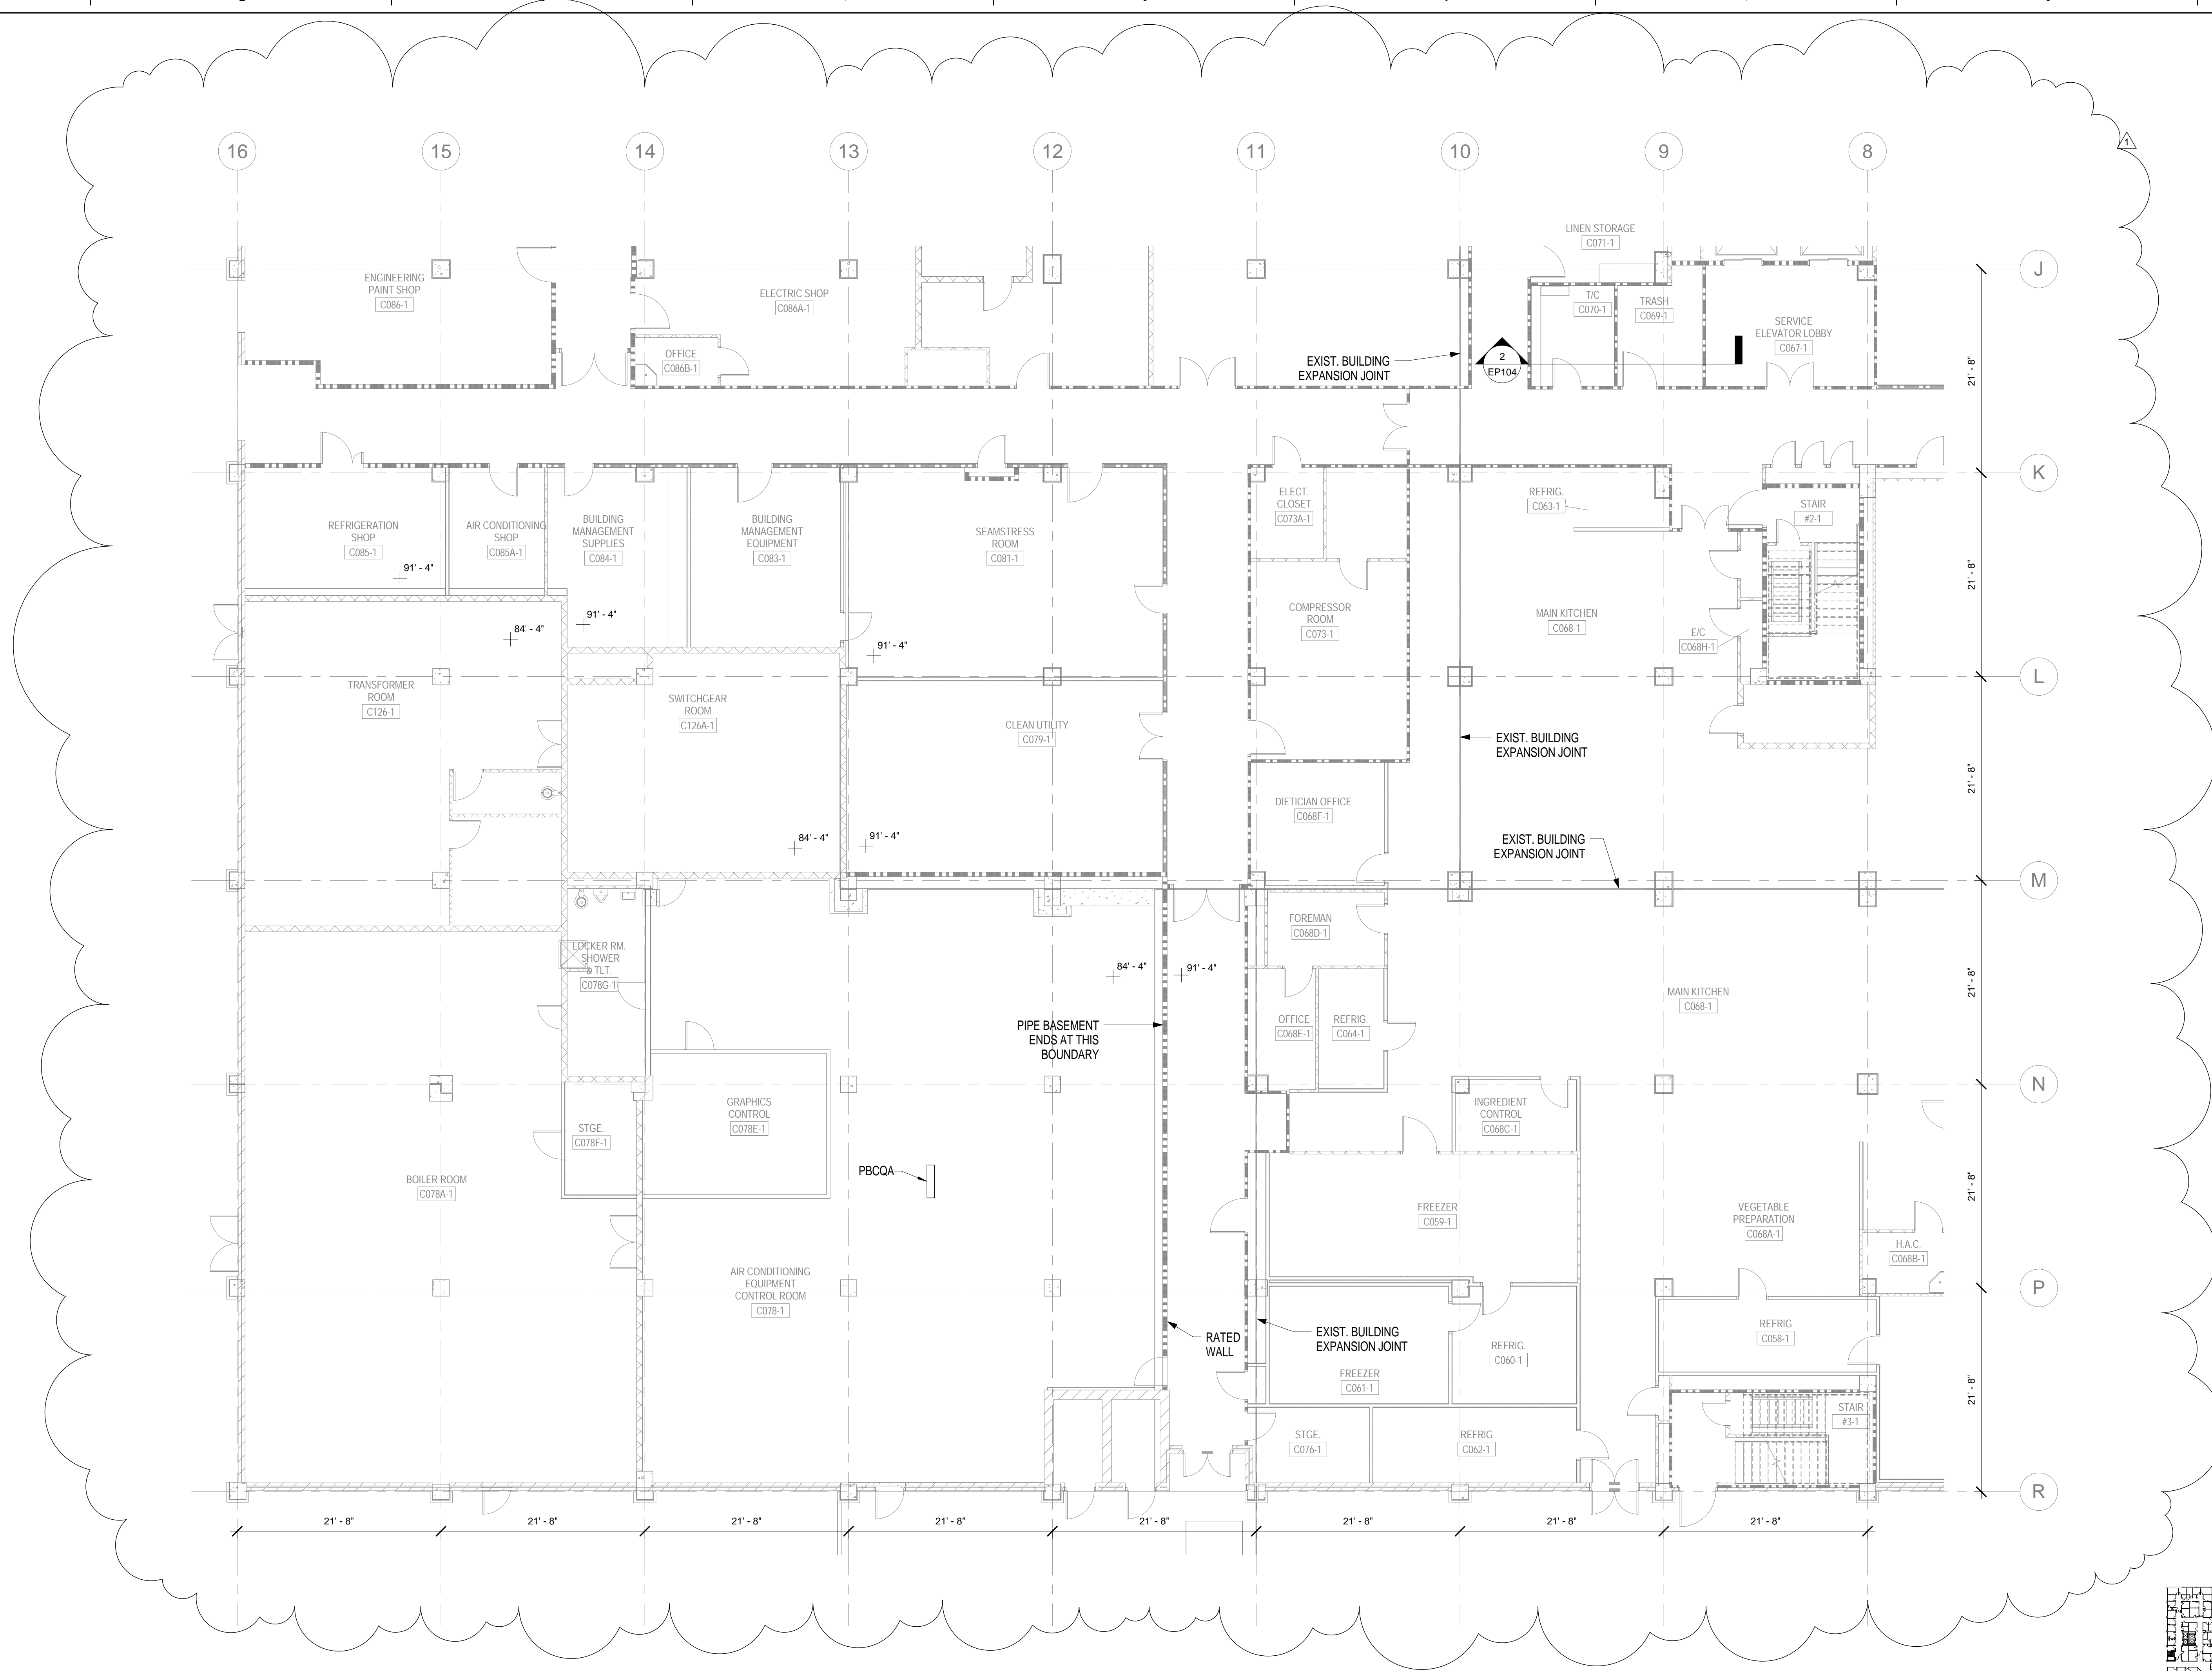

1 BASEMENT (SOUTH) - POWER AND RACEWAY ROUTING  
1/8" = 1'-0"

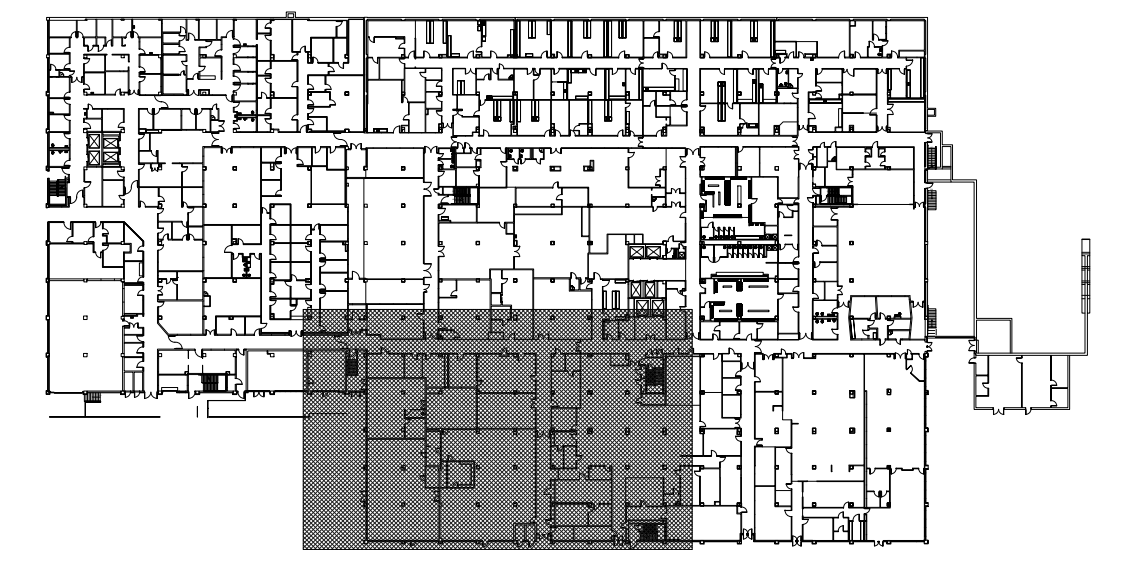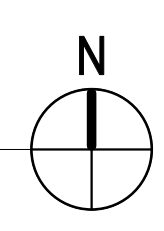

FINAL DESIGN  
APPROVED FOR CONSTRUCTION

<div><div></div><div>ADDENDUM #1 - EQUIP. POWER REVISION</div></div>		5/29/2018	CONSULTANTS:		ENGINEER - OF - RECORD CHAD J. FRALICK FL. P.E. NO. 73811	ARCHITECT/ENGINEERS: <div><div>AKEA</div><div>INC.</div><div>3603 NW 98th Street, Suite B</div><div>Gainesville, FL 32606</div><div>Phone: (352) 474-6124</div><div>Fax: (352) 474-6324</div><div>COA: FL #26693</div><div>AKEA Project No. 094-14</div></div>	Drawing Title		Project Title		Project Number		Office of Construction and Facilities Management
							BASEMENT (SOUTH) - POWER AND RACEWAY ROUTING		RENOVATE WARD 3C FOR CARDIOLOGY EQUIPMENT INSTALLATION		573-CSI-102		
											Building Number		
											1		
											Drawing Number		
											EP101		
Revisions:		Date					Approved: Project Director		Location		Drawing Number		<div><div></div><div>Department of Veterans Affairs</div></div>
									GAINESVILLE, FLORIDA		EP101		
							Date		Checked		Drawn		
							MARCH 9, 2018		CJF		CJF		