


three inches = one foot
one and one half inches = one foot
one inch = one foot
three quarters inch = one foot
one half inch = one foot
three eighths inch = one foot
one quarter inch = one foot
one eighth inch = one foot

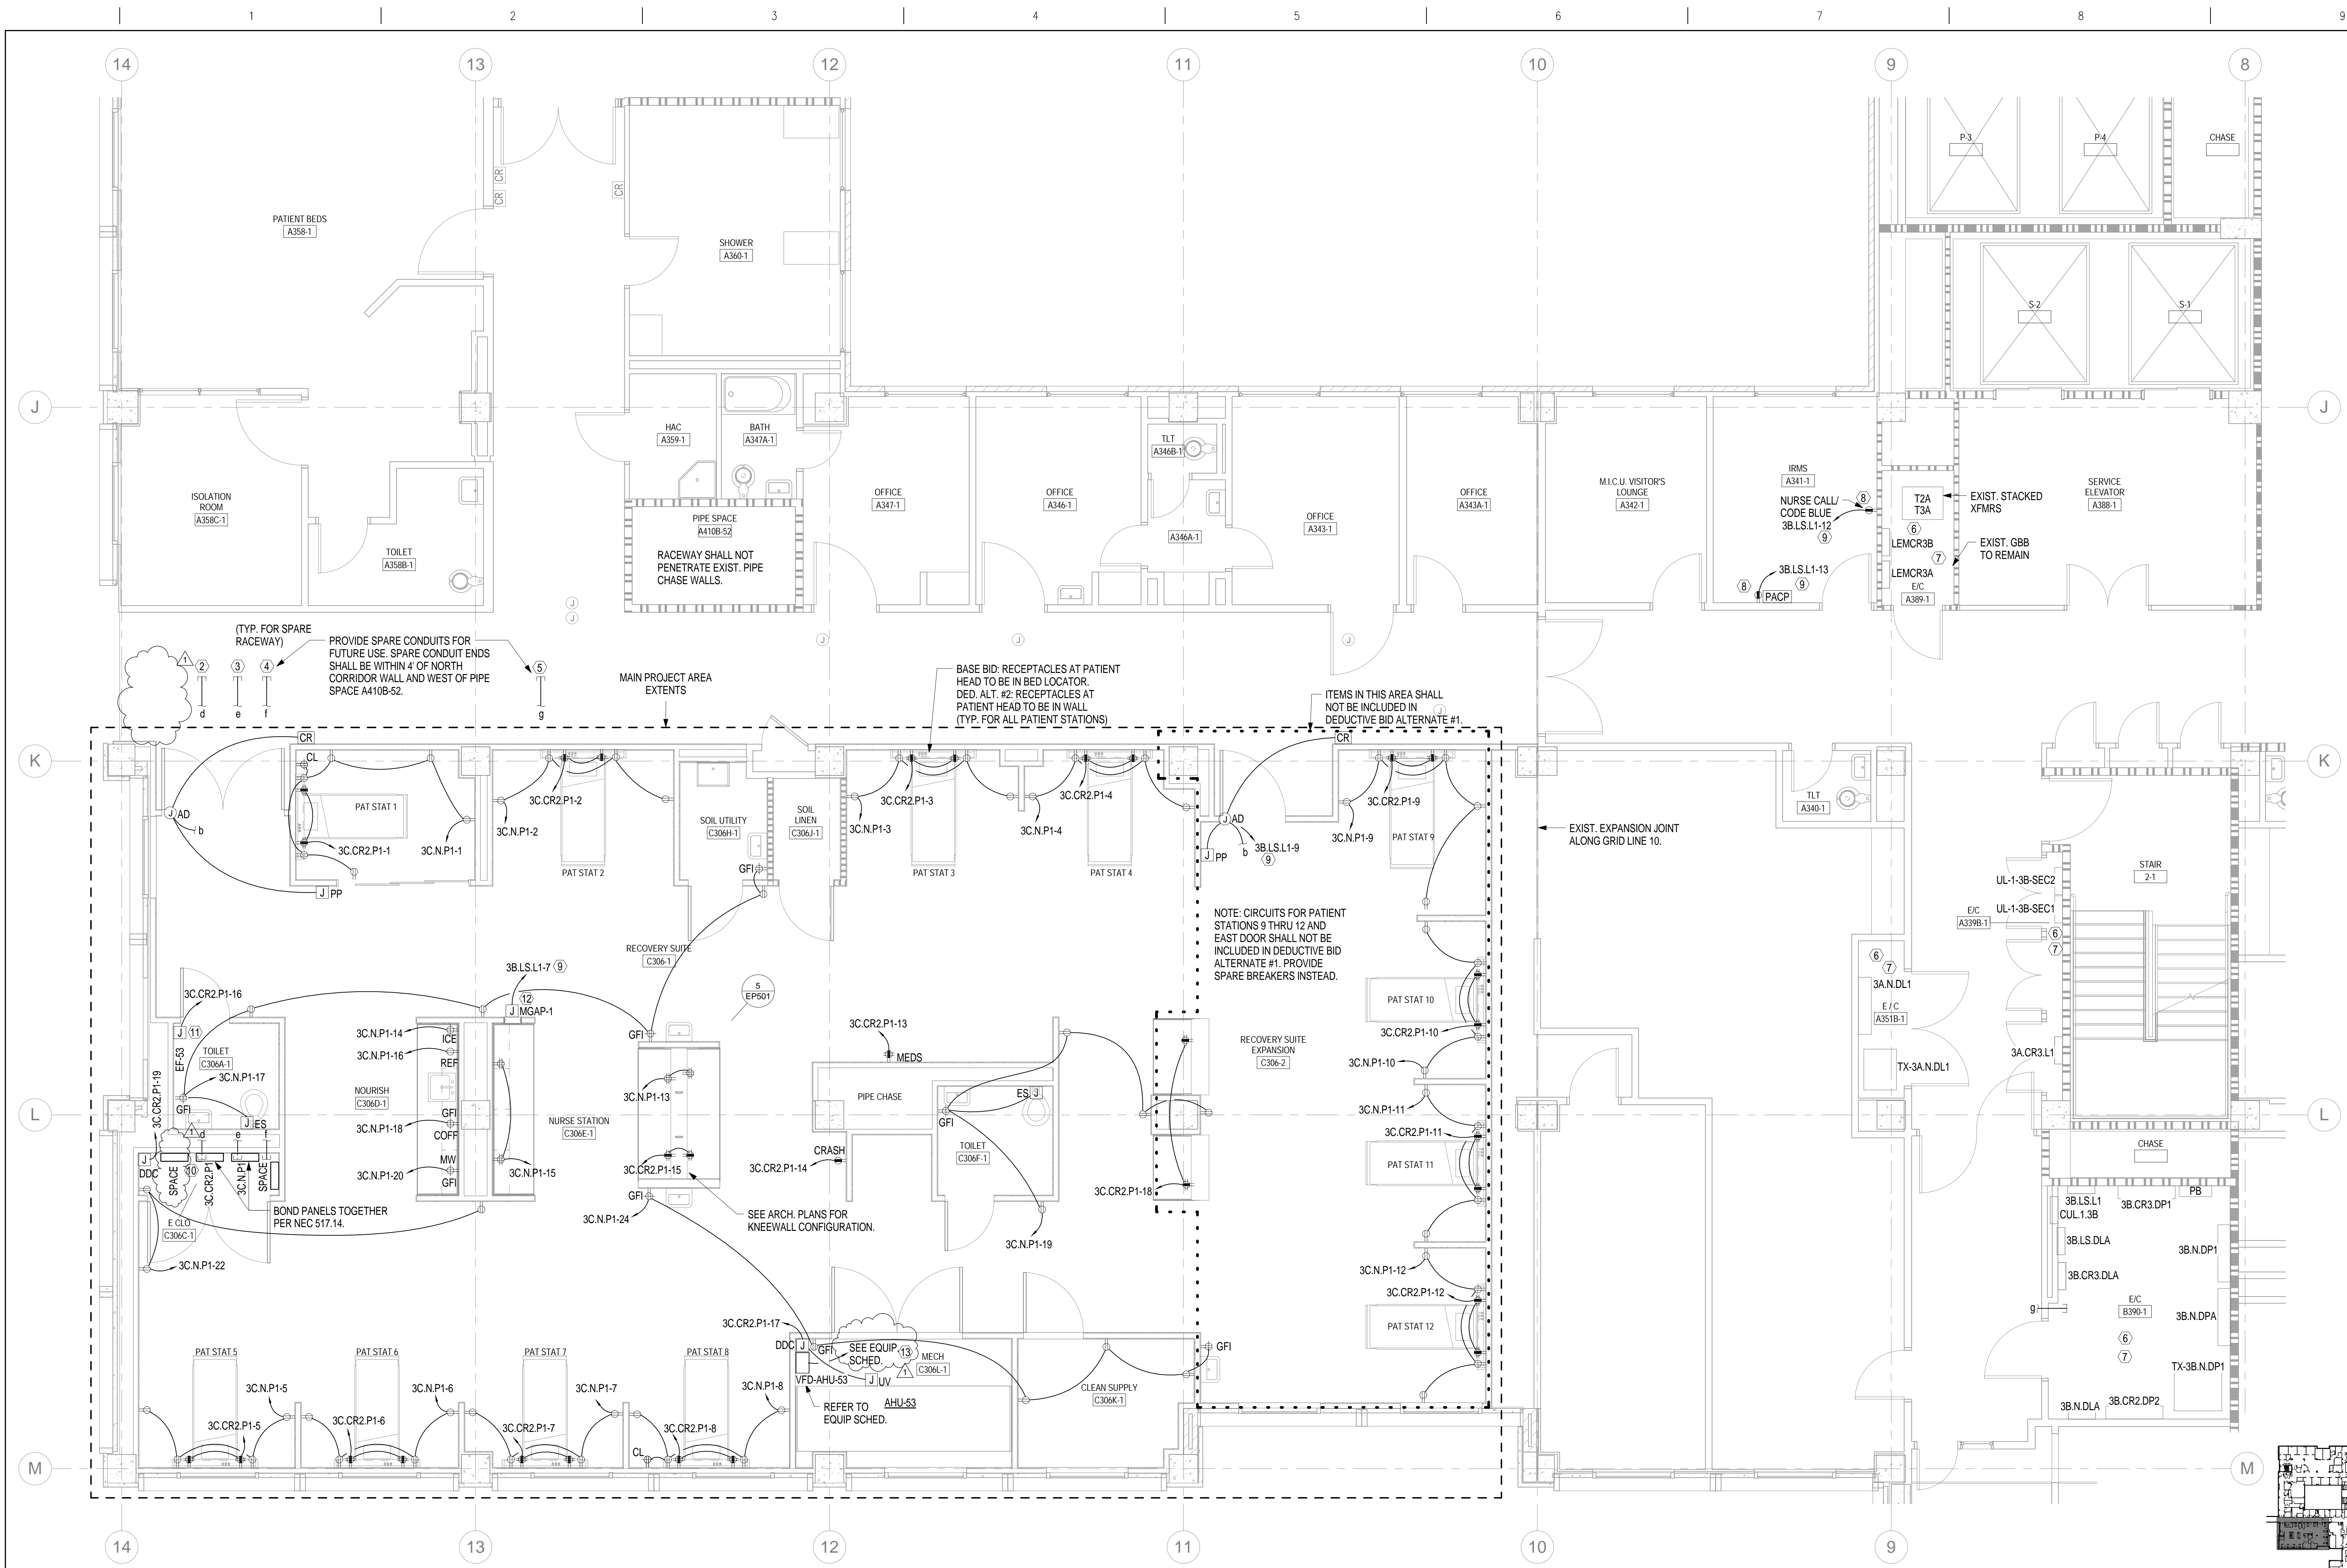

- SHEET NOTES**
 - A REFER TO SPARE CONDUIT DETAIL 10 ON SHEET EP501 FOR ALL SPARE CONDUITS.
 - B REFER TO EP104 FOR PROPOSED ROUTING OF CONDUITS 2" AND LARGER.
 - C CONTRACTOR SHALL BE AWARE THAT PROJECT REQUIRES CONTRACTOR TO PERFORM WORK ABOVE EXISTING-TO-REMAIN CEILINGS AND SPACES. CONTRACTOR SHALL PLAN ACCORDINGLY.
- SHEET KEYNOTES**
 - 1 NOT USED.
 - 2 PROVIDE SPARES: (4) 1" C. AND (4) 3/4" C. TO 3C.CR2.P1.
 - 3 PROVIDE SPARES: (4) 1" C. AND (4) 3/4" C. TO 3C.N.P1.
 - 4 PROVIDE SPARES: (4) 1" C. TO ROOM C306C-1.
 - 5 PROVIDE SPARES: (6) 1" C. TO ROOM B390-1.
 - 6 480V-208V TRANSFORMERS AND ELECTRICAL PANELS IN THIS ROOM ARE EXISTING-TO-REMAIN. CONTRACTOR SHALL PROVIDE NEW BREAKERS IN EXISTING PANELS AS NOTED ELSEWHERE. CONTRACTOR SHALL VERIFY EXISTING PANEL TYPES, BRANDS, AIC RATINGS, AND CHARACTERISTICS.
 - 7 SEAL NEW PENETRATIONS THRU EXISTING WALLS OF THIS ROOM TO MEET 2-HR FIRE SMOKE RATING, UNLESS DIRECTED OTHERWISE BY COR.
 - 8 CONTRACTOR SHALL COORDINATE POWER REQUIREMENTS AND LOCATIONS WITH PACS CONTROL PANEL AND NURSE CALL EQUIPMENT. BID SHALL ACCOMMODATE CIRCUIT LOCATIONS AT ANY LOCATION IN THE ROOM.
 - 9 PROVIDE 120V 20A 1P BREAKER IN EXISTING PANEL AS NOTED.
 - 10 TERMINATE SPARE CONDUITS 6" MIN. WITHIN ROOM, ABOVE THE SOURCE PANEL (IF NOTED).
 - 11 PROVIDE JUNCTION BOX, SINGLE POLE MOTOR RATED SWITCH, AND RELAY ABOVE CEILING FOR FRACTIONAL HP EXHAUST FAN. COORDINATE WITH MECHANICAL.
 - 12 COORDINATE LOCATION WITH MED GAS
 - 13 PROVIDE NEW 30A/3P BREAKER IN EXISTING PANEL NOTED. CONTRACTOR SHALL FIELD COORDINATE CONDUIT ROUTING.

1 THIRD FLOOR POWER PLAN
1/4" = 1'-0"

ADDENDUM #1 - EQUIP. POWER REVISION 5/29/2018	CONSULTANTS:	ENGINEER - OF - RECORD CHAD J. FRALICK FL. P.E. NO. 73811	ARCHITECT/ENGINEERS: AKEA INC. 3603 NW 98th Street, Suite B Gainesville, FL 32606 Phone: (352) 474-6124 Fax: (352) 474-6324 COA: FL #26693 AKEA Project No. 094-14	Drawing Title THIRD FLOOR POWER PLAN	Project Title RENOVATE WARD 3C FOR CARDIOLOGY EQUIPMENT INSTALLATION	Project Number 573-CSI-102	Office of Construction and Facilities Management
				Approved: Project Director	Location GAINESVILLE, FLORIDA	Building Number 1	
					Date MARCH 9, 2018	Checked CJF	
Revisions:	Date					Drawing Number EP401 54 OF 62	

FINAL DESIGN
APPROVED FOR CONSTRUCTION