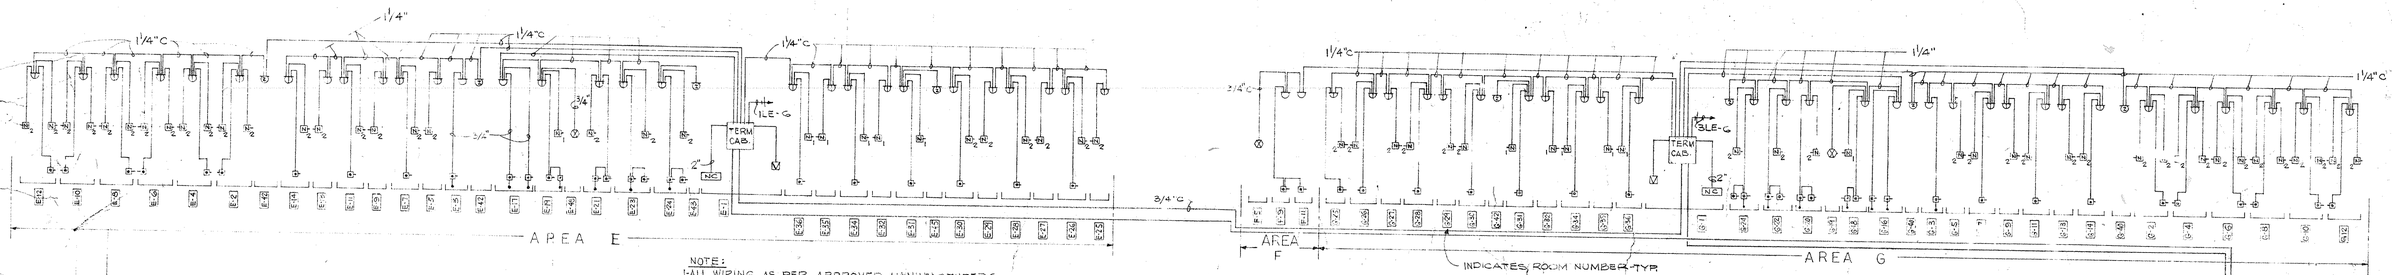

NOTE:
1-ALL WIRING AS PER APPROVED MANUFACTURERS WIRING DIAGRAM.
2-ALL CONDUIT 3/4" EXCEPT OTHERWISE NOTED.

NURSES CALL - RISER DIAGRAM
NOT TO SCALE

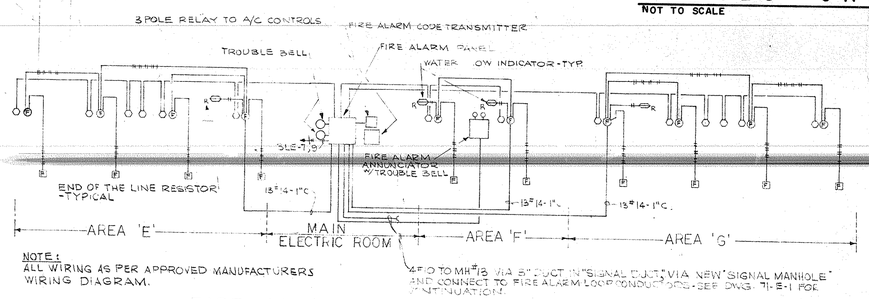

NOTE:
ALL WIRING AS PER APPROVED MANUFACTURERS WIRING DIAGRAM.

4-F.D. TO MH#13 VIA 5" DUCT IN "SIGNAL DUCT" VIA NEW "SIGNAL MANHOLE" AND CONNECT TO FIRE ALARM LOOP CONDUCTORS - SEE DWG. 71-E-1 FOR CONTINUATION.

FIRE ALARM RISER DIAGRAM
NOT TO SCALE

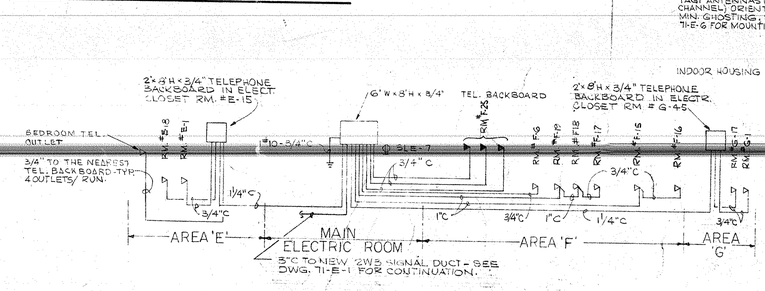

3"C TO NEW 12W5 SIGNAL DUCT - SEE DWG. 71-E-1 FOR CONTINUATION.

TELEPHONE RISER DIAGRAM
NOT TO SCALE

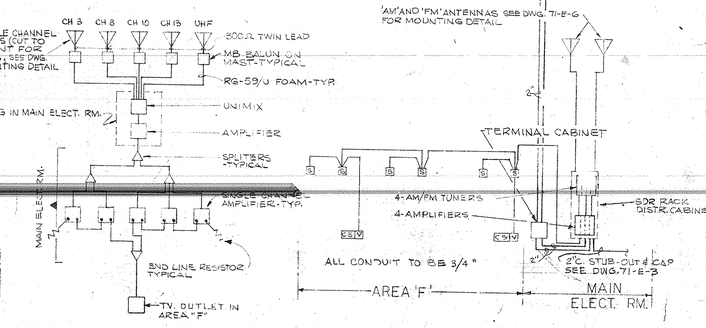

T.V. RISER DIAGRAM
NOT TO SCALE

ENTERTAINMENT RISER DIAGRAM
NOT TO SCALE

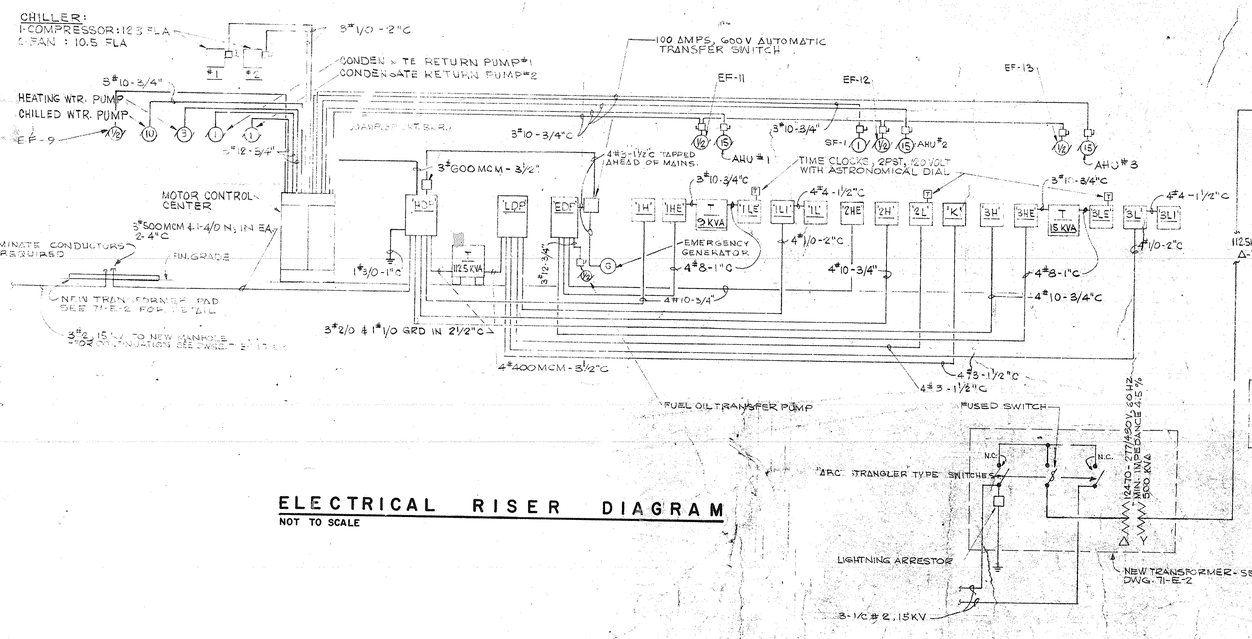

ELECTRICAL RISER DIAGRAM
NOT TO SCALE

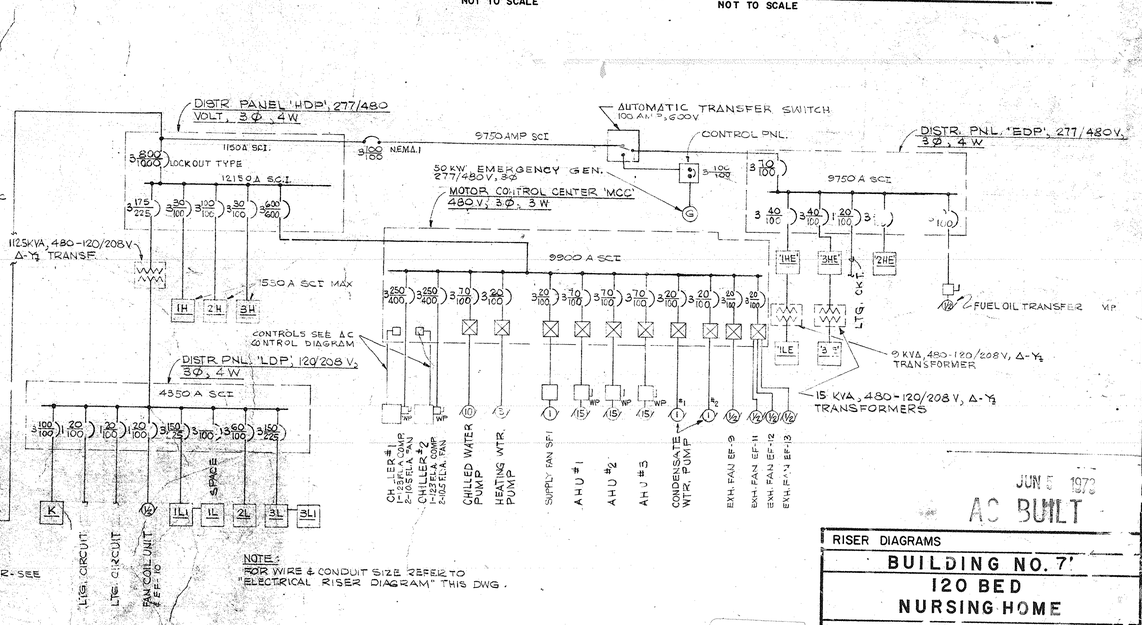

NOTE:
FOR WIRE & CONDUIT SIZE, REFER TO "ELECTRICAL RISER DIAGRAM" THIS DWG.

ELECTRICAL SINGLE LINE DIAGRAM
NOT TO SCALE

JUN 5 1972
AS BUILT

2-4-1-2499

RISER DIAGRAMS
BUILDING NO. 7'
120 BED
NURSING HOME
VETERANS ADMINISTRATION
BAY PINES, FLORIDA

Drawn F.E.G. | Proj. Mgr. J.D.V.
Checked J.D.P. | Date 4-26-71

REVISIONS

norman m. giller & associates
ARCHITECTS ENGINEERS
975 ARTHUR GODFREY RD. MIAMI BEACH, FLA.

Project Director

DRAWING NUMBER
71-E-11
Sheet 11 Of 11
Proj. No. 0952527

RETURN TRACINGS TO PLAN LIBRARY

FILE FOLDER NO. 2D