KEY

A AHU V-15 and S-5 REPLACEMENT/07NRM/||INSTALL S-5 AHU||695-07-132||C0608, C00876

B UPGRADE SMALL VARIOUS AC COMPONENTS AND UNITS/17NRM/695-17-109

ENTIRE FLOOR: REPLACE FIRE ALARM SYSTEM/09NRM||695-09-151||C90855

111 REKEY BLDG/12NRM/695-12-124

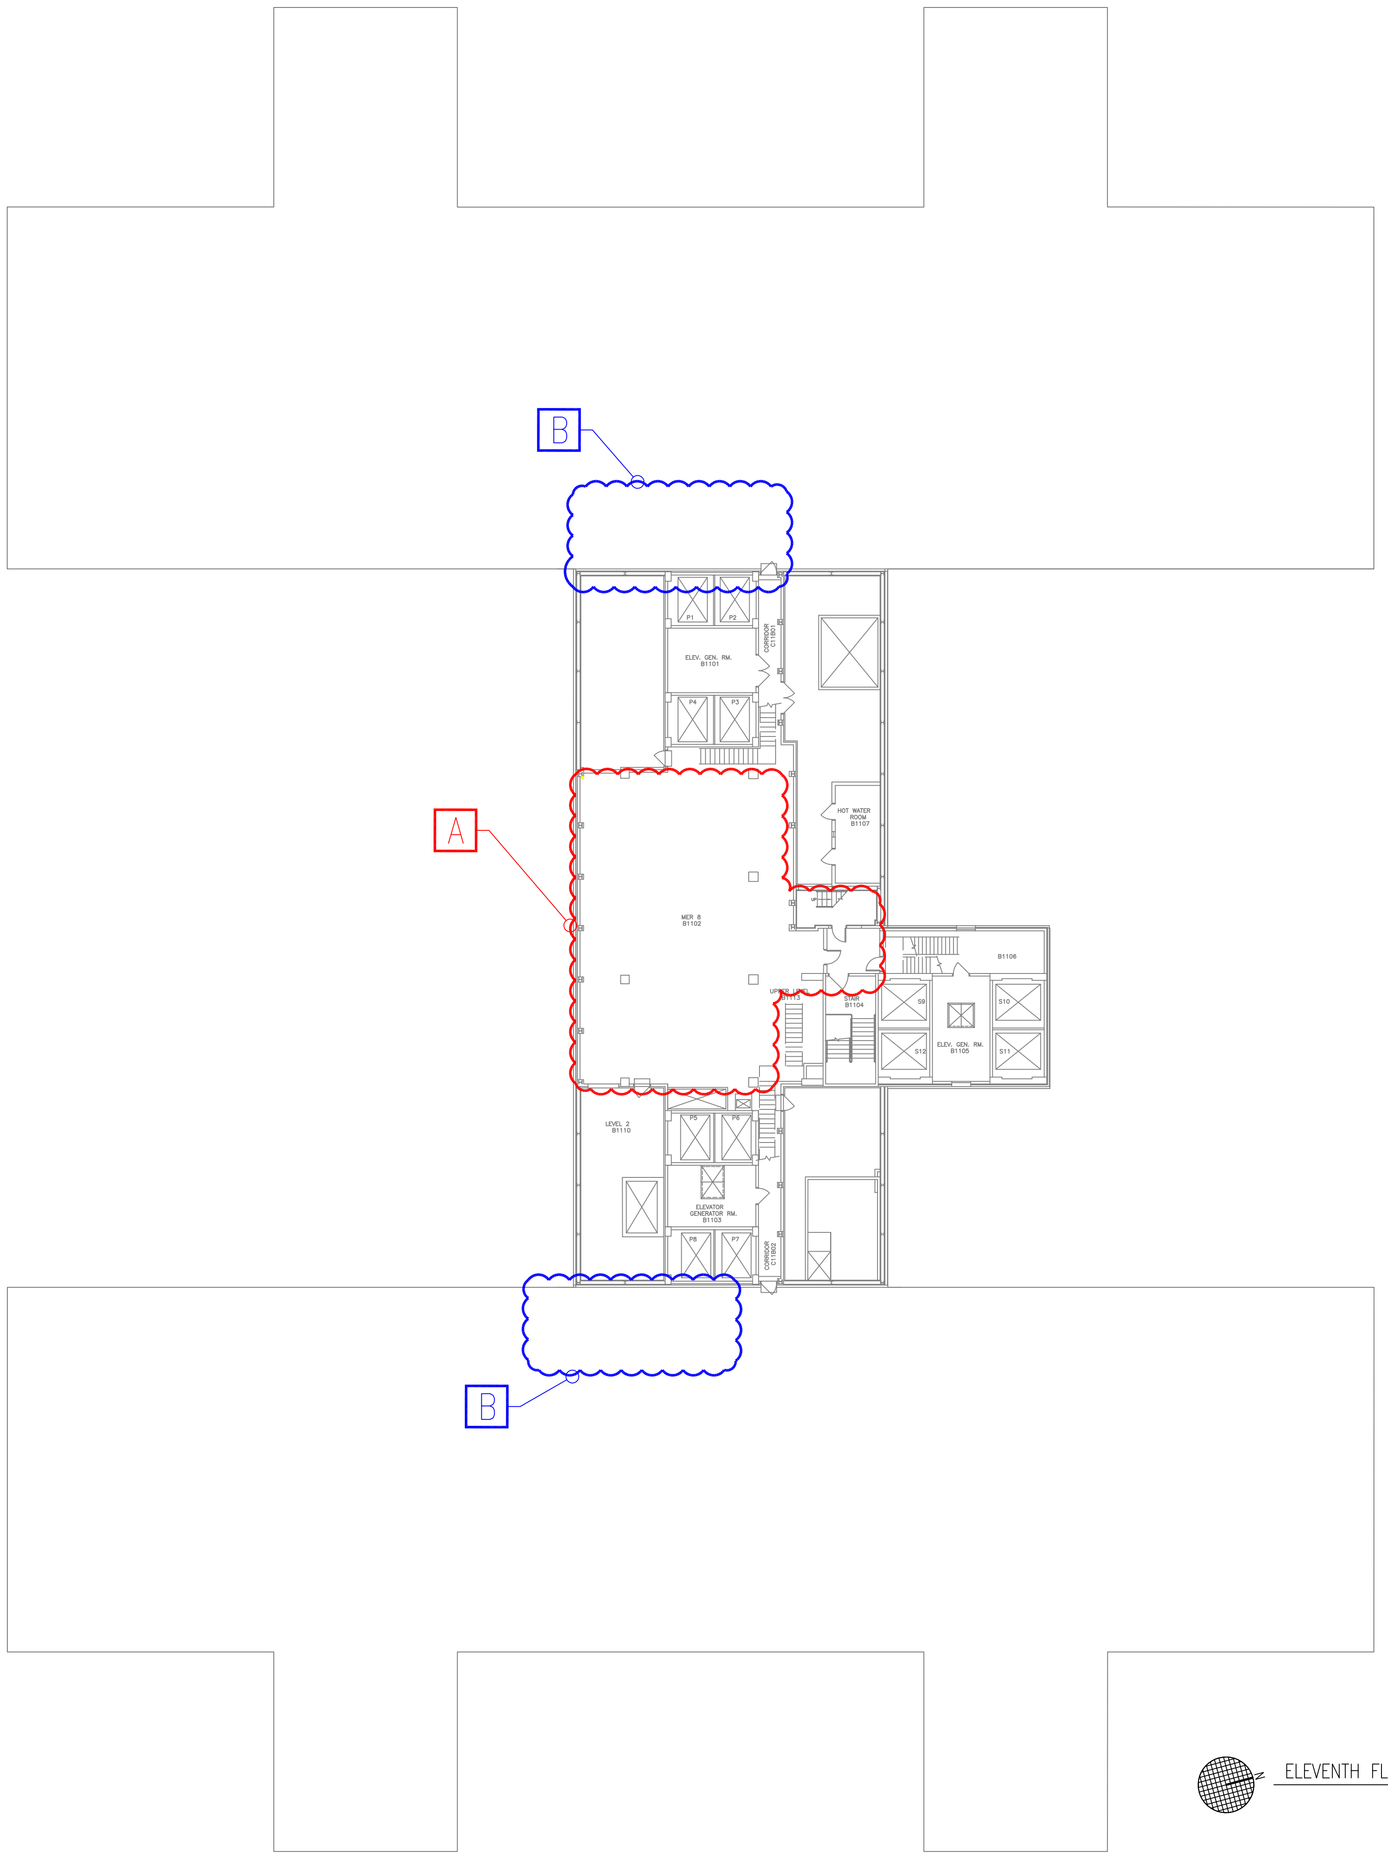

ELEVENTH FLOOR PLAN

N.T.S.

Revisions:	Date

Dept. of Veterans Affairs
Medical Center
5000 W. National Avenue
Milwaukee, WI

KEY PLAN:

ENGINEER:

ARCHITECT:

Drawing Title
ELEVENTH FLOOR PLAN
FLOOR AS-BUILT RECORD

Approved Project Director

Project Title
-
-

Location
VA Medical Center,Milwaukee, WI

Date 11/13/2017 | Checked - | Drawn mwm

Project Number
-

Building Number
Building 111

Drawing Number
111-11
12 of 14

Office of Construction and Facilities Management
Department of Veterans Affairs

VA FORM 08-6231