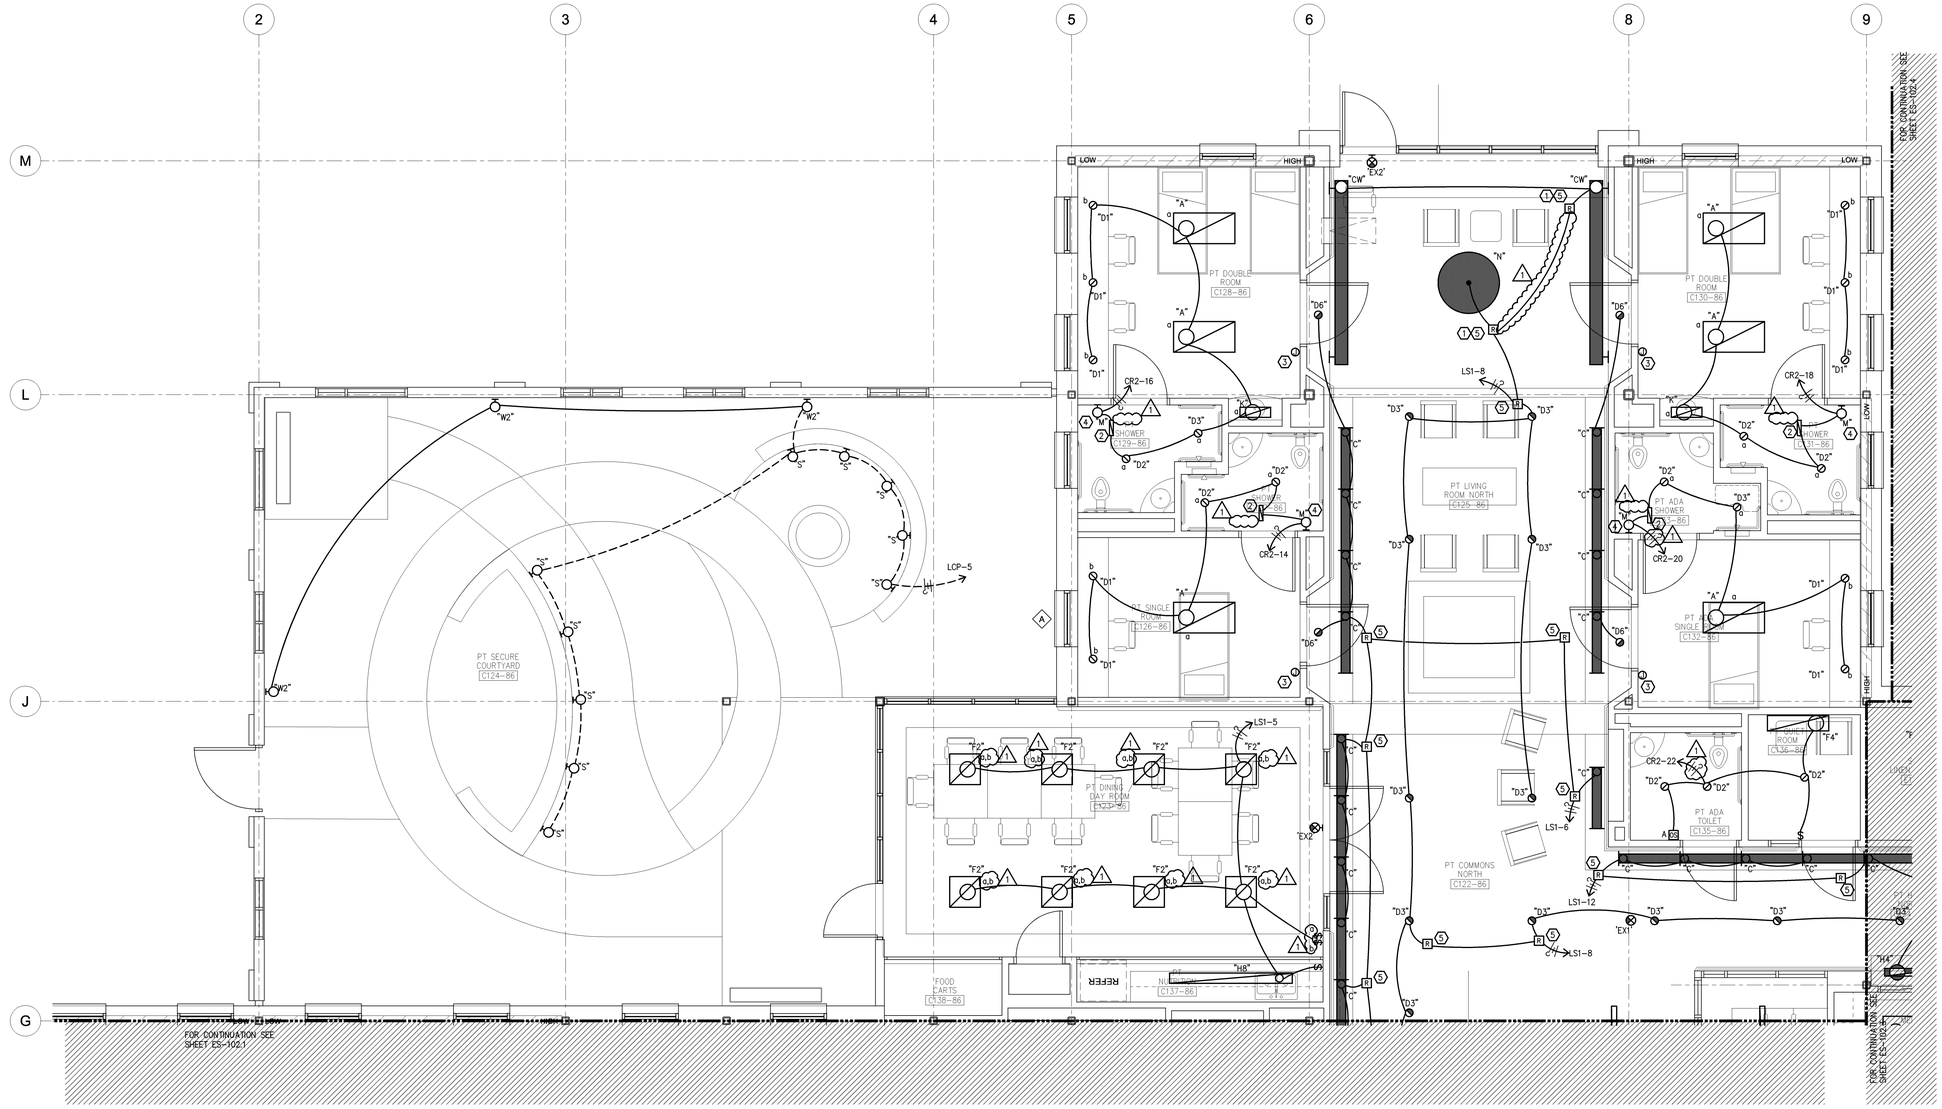

GENERAL NOTES:

1. ALL EXIT SIGNS SHOWN SHALL BE CIRCUITED TO PANEL "LS1", CIRCUIT LS1-22.

SHEET NOTES:

1. DEVICE TO BE INSTALLED ABOVE NEAREST ACCESSIBLE CEILING.
2. 6"x6" JUNCTION BOX WITH (4) LIGHTING CONTROL MODULES ABOVE CEILING. REFERENCE DETAIL 8/ES-105 FOR WIRING INFORMATION.
3. PROVIDE JUNCTION BOX WITH BLANK STAINLESS STEEL COVERPLATE. J-BOX FOR FUTURE LOW VOLTAGE SWITCH. REFERENCE DETAIL 8/ES-105 FOR WIRING INFORMATION.
4. PROVIDE UNSWITCHED FEED TO NIGHT LIGHT. REFERENCE DETAIL 8/ES-105 FOR WIRING INFORMATION.
5. PROVIDE ENCELIUM LUMINAIRE CONTROL MODULE WITH GREENBUS II COMMUNICATION CAPABILITIES. REFERENCE GREENBUS II RISER DIAGRAM FOR CONNECTION DETAILS.
6. LOCATE REMOTE DRIVERS FOR TYPE "S" FIXTURES ABOVE ACCESSIBLE CEILING.

1 FLOOR PLAN NORTH WING - LIGHTING

SCALE: 1/4"=1'-0"

ADDENDUM 1	10 AUG 2012
Revisions:	Date

CONSULTANTS:

BALZHISER & HUBBARD ENGINEERS
MECHANICAL · ELECTRICAL · SURVEYORS
100 WEST 13TH AVENUE EUGENE, OR 97401
P: 541-686-8478 F: 541-345-1300
2100-031-10es-102.1_4.dwg

REGISTERED PROFESSIONAL ENGINEER OREGON JULY 21, 1989 KEVIN M. WARE
DIGITAL SIGNATURE
EXPIRES 6/30/14

ARCHITECT/ENGINEERS:

Tina Ely architect
2915 Wingate Street / Eugene, OR 97408
541.521.2477 / TinaEly@comcast.net

Drawing Title	FLOOR PLAN NORTH WING - LIGHTING
Approved: Project Director	
Project Title	SEISMIC REPLACEMENT BLDG 2 PHASE 1 MINOR ACUTE PSYCHIATRIC WARD
Location	ROSEBURG, OREGON
Date	30 APR 2012
Checked	KMW
Drawn	GCH
VA Project Number	653-322
Building Number	086
Sheet Number	ES-102.2

Office of Construction and Facilities Management
Department of Veterans Affairs

VA FORM 08-6231