


**1 MECHANICAL ROOM PLAN**  
SCALE: 1/4"=1'-0"

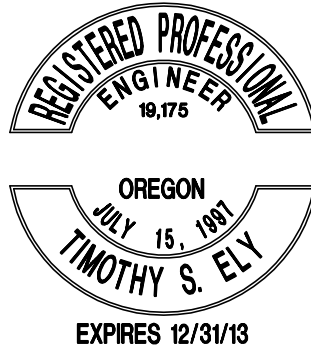

BALZHISER & HUBBARD ENGINEERS	
MECHANICAL	100 WEST 13TH AVENUE
ELECTRICAL	EUGENE, OR 97401
CIVIL	P: 541-686-8478
SURVEYORS	F: 541-345-5303
2100-031-10mh300.dwg	
VA Project Number	
653-322	
SEISMIC REPLACEMENT BLDG 2	
PHASE 1 MINOR	
ACUTE PSYCHIATRIC WARD, B86	
ROSEBURG, OREGON	
Revision Title	Addendum 1
Revision Date	10 AUG 12
Drawing Reference	MH-300
Sketch Number	SK-M01