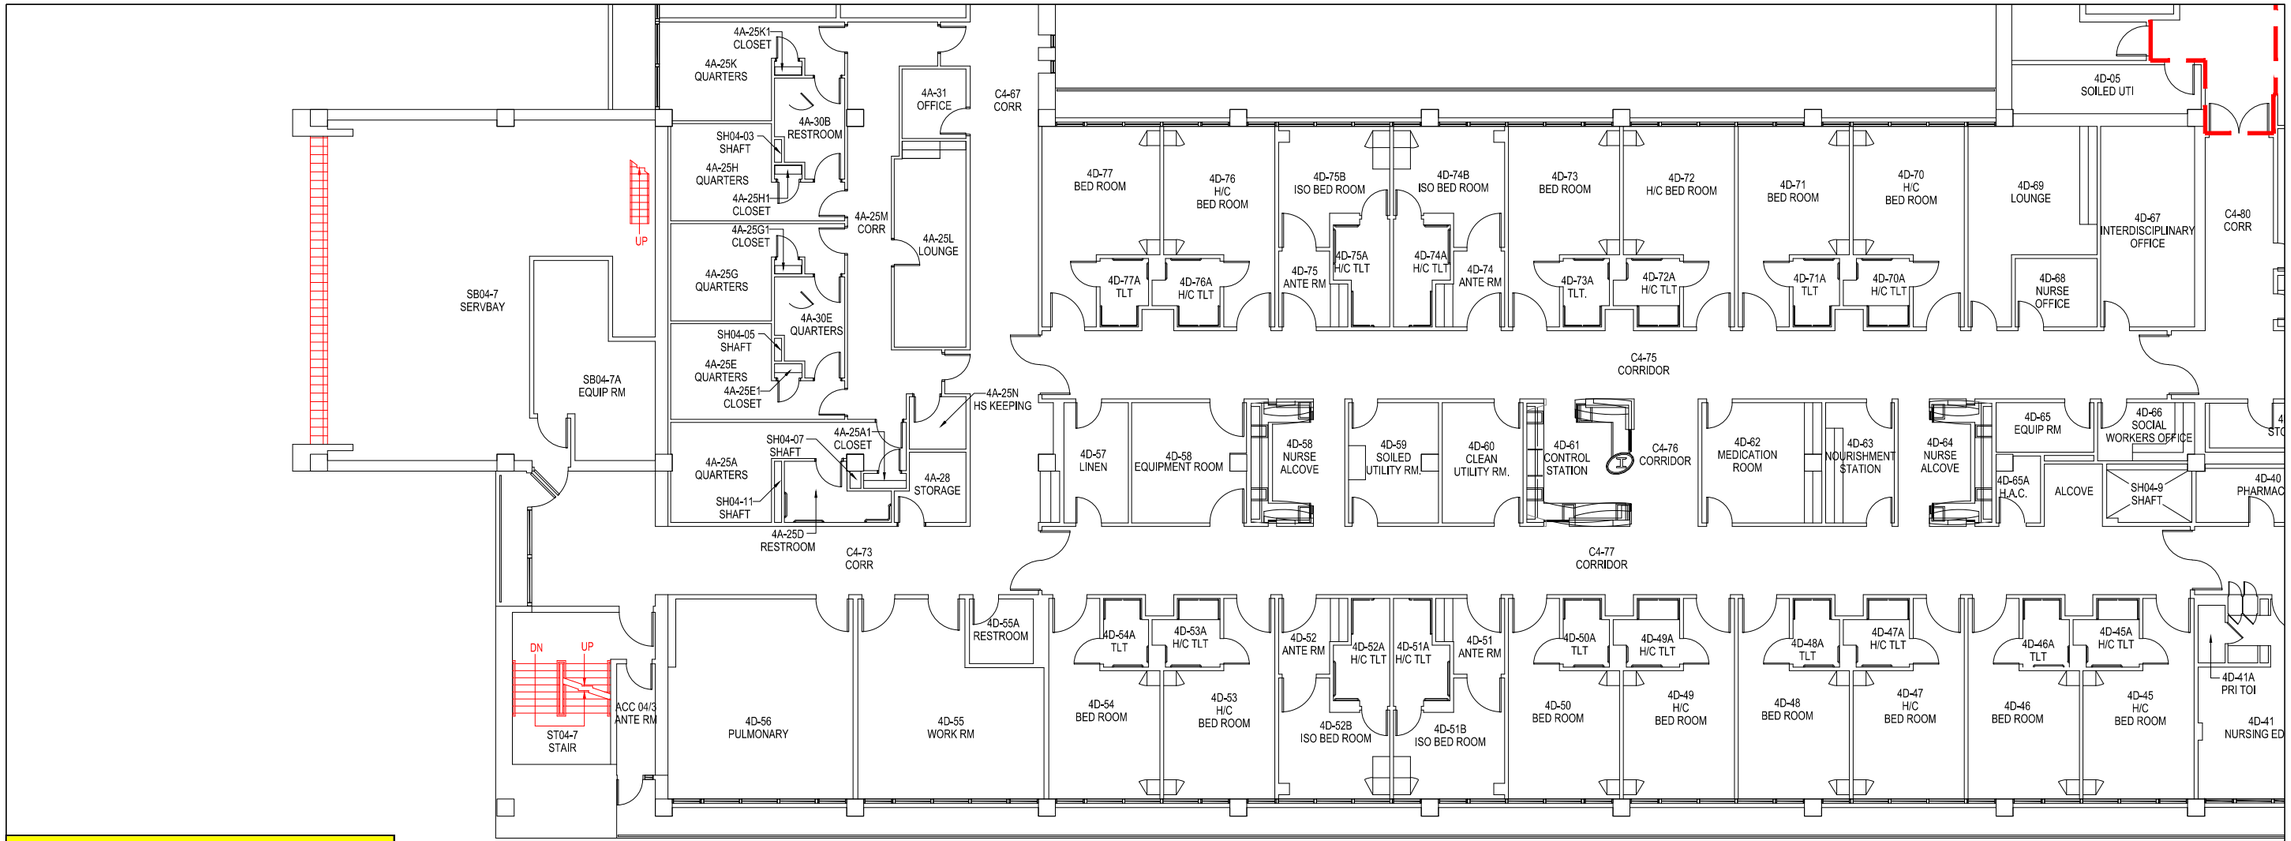

PLEASE SEE THE SAFETY OFFICE PRIOR TO PERFORMING MAINTENANCE/RENOVATION ACTIVITIES ON ANY OF THE FOLLOWING COMPONENTS IN HATCHED AREAS.

These Building Components Depicted in Red Are Assumed To Contain Lead Containing Paint (LCP) at Greater Than 1.0 mg/cm² unless otherwise determined.

COMPONENT	SUBSTRATE	SYMBOL
TREAD SUPPORT (STAIRS)	METAL	
STAIRAIL (STAIRS)	METAL	
HANDRAIL (STAIRS)	METAL	
HANDRAIL OUTER (STAIRS)	METAL	
STRINGBOARD OUTER (STAIRS)	METAL	
STRINGBOARD (STAIRS)	METAL	
DOOR	DRY WALL, WOOD	
DOOR FRAME	METAL	
LOCKER	METAL	
LOUVRE	METAL	
WINDOW	GLASS	
WALL SHOWER	CERAMIC	
INTERIOR WALL STRIPE	CERAMIC	
INTERIOR WALL	CERAMIC, DRY WALL, GLASS	

If Present in the Hatched Area These Other Building Components Are Assumed To Be Lead Containing Paint (LCP) at Greater Than 1.0 mg/cm² unless otherwise determined.

		SYMBOL
BASEBOARDS	CERAMIC	

Notes:
1. Components similar to those listed in the table above found in the hatched areas should be assumed to contain LCP for worker protection, maintenance, renovation, disposal, etc. purposes unless otherwise determined by an approved method.
2. Lead-containing paint (LCP) screening measurements were collected using an XRF analyzer. For additional information and full screening results refer to the M&A Asbestos & LCP building report.
3. Users of this information should not rely on color alone to decide whether similar building components contain LCP.
4. Equipment, furniture, non structural items, and non-painted building components such as glazed tile, glazed block, stained or frosted glass, unpainted piping, etc. were not included in the survey and are not included in the table above but may contain Lead.

Revisions	Date

KEY PLAN

Professional Seal

Mabbett®
Scientists | Engineers | Program Managers
Mabbett & Associates, Inc.
5 Alfred Circle Bedford, MA 01730-2318
T. 781-275-6050
www.mabbett.com

Drawing Title	FOURTH FLOOR PLAN ARCHITECTURAL
Project Title	LEAD SURVEY
Date	MARCH 2017
Project No.	2016016.001
Drawing No.	L1-4G
Site:	VA LOMA LINDA
Building:	1
Drawn:	DJA
Checked:	DAN
Approved:	?
Location:	JERRY L.PETTIS MEMORIAL VA HOSPITAL LOMA LINDA, CALIFORNIA
Scale	NOT TO SCALE

VA LOMA LINDA

Department of Veterans Affairs

VA FORM 08-6231, OCT 1978