



EXTERIOR CAMERAS

CAMERA 1- Pelco Sarix SMP external cameras

CAMERA 2- Pelco Sarix SMP external cameras

CAMERA 3- Pelco Sarix SMP external cameras

CAMERA 4- Pelco Sarix SMP external cameras

CAMERA 5- Pelco Sarix SMP external cameras

CAMERA 6 - Pelco Sarix SMP external cameras

CAMERA 7 - Pelco Sarix SMP external cameras

NOTES:
1. SEE SPECIFICATIONS FOR CONTACTOR TYPE

NOTES:
1. SEE SPECIFICATIONS FOR CONTACTOR TYPE





1									

[illegible]











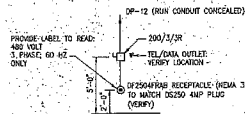

MOBILE MRI WIRING DETAIL

NOTE: WIRING PHASES MUST BE CHECKED PRIOR TO MOBILE OPERATION. USE ON-BUILD PHASE INDICATOR IN MAIN PANEL.

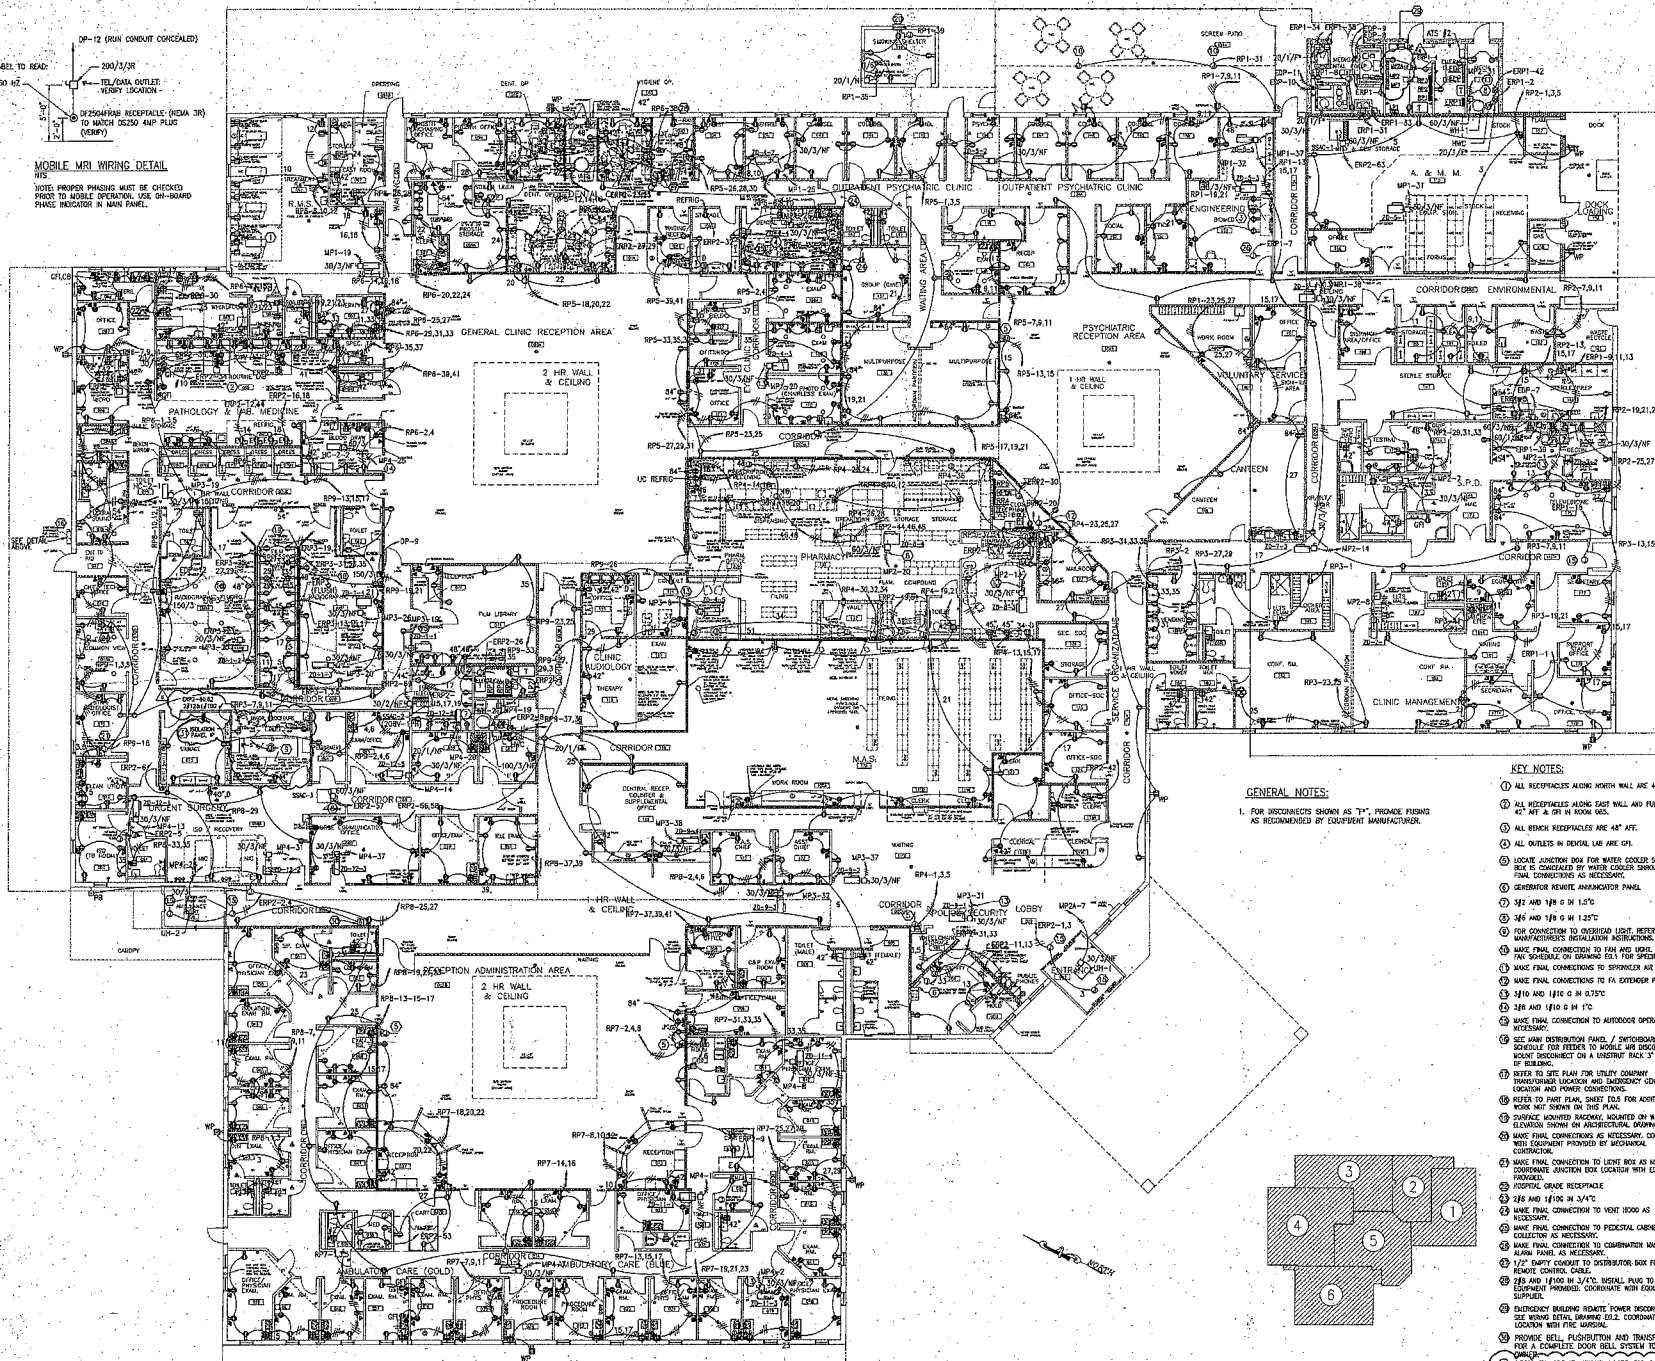


GENERAL NOTES:


KEY NOTES:

1. ALL RECEPTACLES ALONG NORTH WALL ARE 48" AFF. UOL.
2. ALL RECEPTACLES ALONG EAST WALL AND FURNITURE ARE 42" AFF. & 91" IN ROOM UOL.
5. LOWER CLOSET BOX FOR WATER COOLER SHOWN THAT BOX IS CONCEALED BY WATER COOLER SHROUD. MAKE FINAL CONNECTIONS AS NECESSARY.
6. GENERATOR REMOTE ANNUNCIATOR PANEL.
7. 3/4" AND 1/2" G IN 1.5'.
8. 3/4" AND 1/2" G IN 1.25'.
9. FOR CONNECTION TO OVERHEAD LIGHT, REFER TO MANUFACTURER'S INSTALLATION INSTRUCTIONS.
10. MAKE FINAL CONNECTION TO FAN AND LIGHT, REFER TO THE SPECIFICATIONS ON DRAWING E01 FOR SPECIFICATIONS.
11. MAKE FINAL CONNECTION TO SPRINKLER AND COMPRESSOR.
12. MAKE FINAL CONNECTIONS TO FA EXTERIOR PANEL.
13. 3/16" AND 1/16" G IN 0.75'.
14. 3/8" AND 1/8" G IN 1'.
15. MAKE FINAL CONNECTION TO AUTODOOR SENSORS AS NECESSARY.
17. REFER TO SITE PLAN FOR UTILITY COMPANY TRANSMISSION LOCATION AND EMERGENCY OPERATOR LOCATION AND POWER CONNECTIONS.
18. REFER TO FINAL PANEL SHEET E01 FOR ADDITIONAL WORK NOT SHOWN ON THIS PLAN.
19. SURFACE MOUNTED RACQING, MOUNTED ON WALL AT ELEVATION SHOWN ON ARCHITECTURAL DRAWINGS.
20. MAKE FINAL CONNECTIONS AS NECESSARY. COORDINATE WITH EQUIPMENT PROVIDED BY MECHANICAL CONTRACTOR.
21. MAKE FINAL CONNECTION TO LEAKS BOX AS NECESSARY. COORDINATE JUNCTION BOX LOCATION WITH EQUIPMENT MANUFACTURER.
23. 3/8" AND 1/16" G IN 3/4'.
24. MAKE FINAL CONNECTION TO VENT 1000 AS NECESSARY.
25. MAKE FINAL CONNECTION TO FEDERAL CABINET DUST COLLECTOR AS NECESSARY.
26. MAKE FINAL CONNECTION TO COMBINATION WATER ALARM PANEL AS NECESSARY.
27. 1/2" RAMPY CORDSET TO DISTRIBUTION BOX FOR REMOTE CONTROL CABLE.
28. 3/8" AND 1/16" G IN 3/4'. INSTALL PLUG TO MATCH EQUIPMENT PROVIDED. COORDINATE WITH EQUIPMENT SUPPLIER.
30. PROVIDE BELL, PULLSTATION AND TRANSFORMER PLUS A COMPLETE DOOR BELL SYSTEM TO SUIT OWNER.
31. REFER TO SPECIFICATIONS 18075 FOR PANEL DESCRIPTION. COORDINATE EXACT LOCATION AND WALL DEPTH FOR 8" DEEP PANEL WITH INSULON EQUIPMENT.

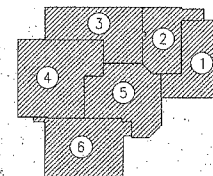

DATE	NO. REVISIONS	DATE	NO. REVISIONS
7/1/02	1	7/1/02	1
12/2/02	2	12/2/02	2
1/17/03	3	1/17/03	3
3/9/03	4	3/9/03	4
4/2/03	5	4/2/03	5
5/1/03	6	5/1/03	6


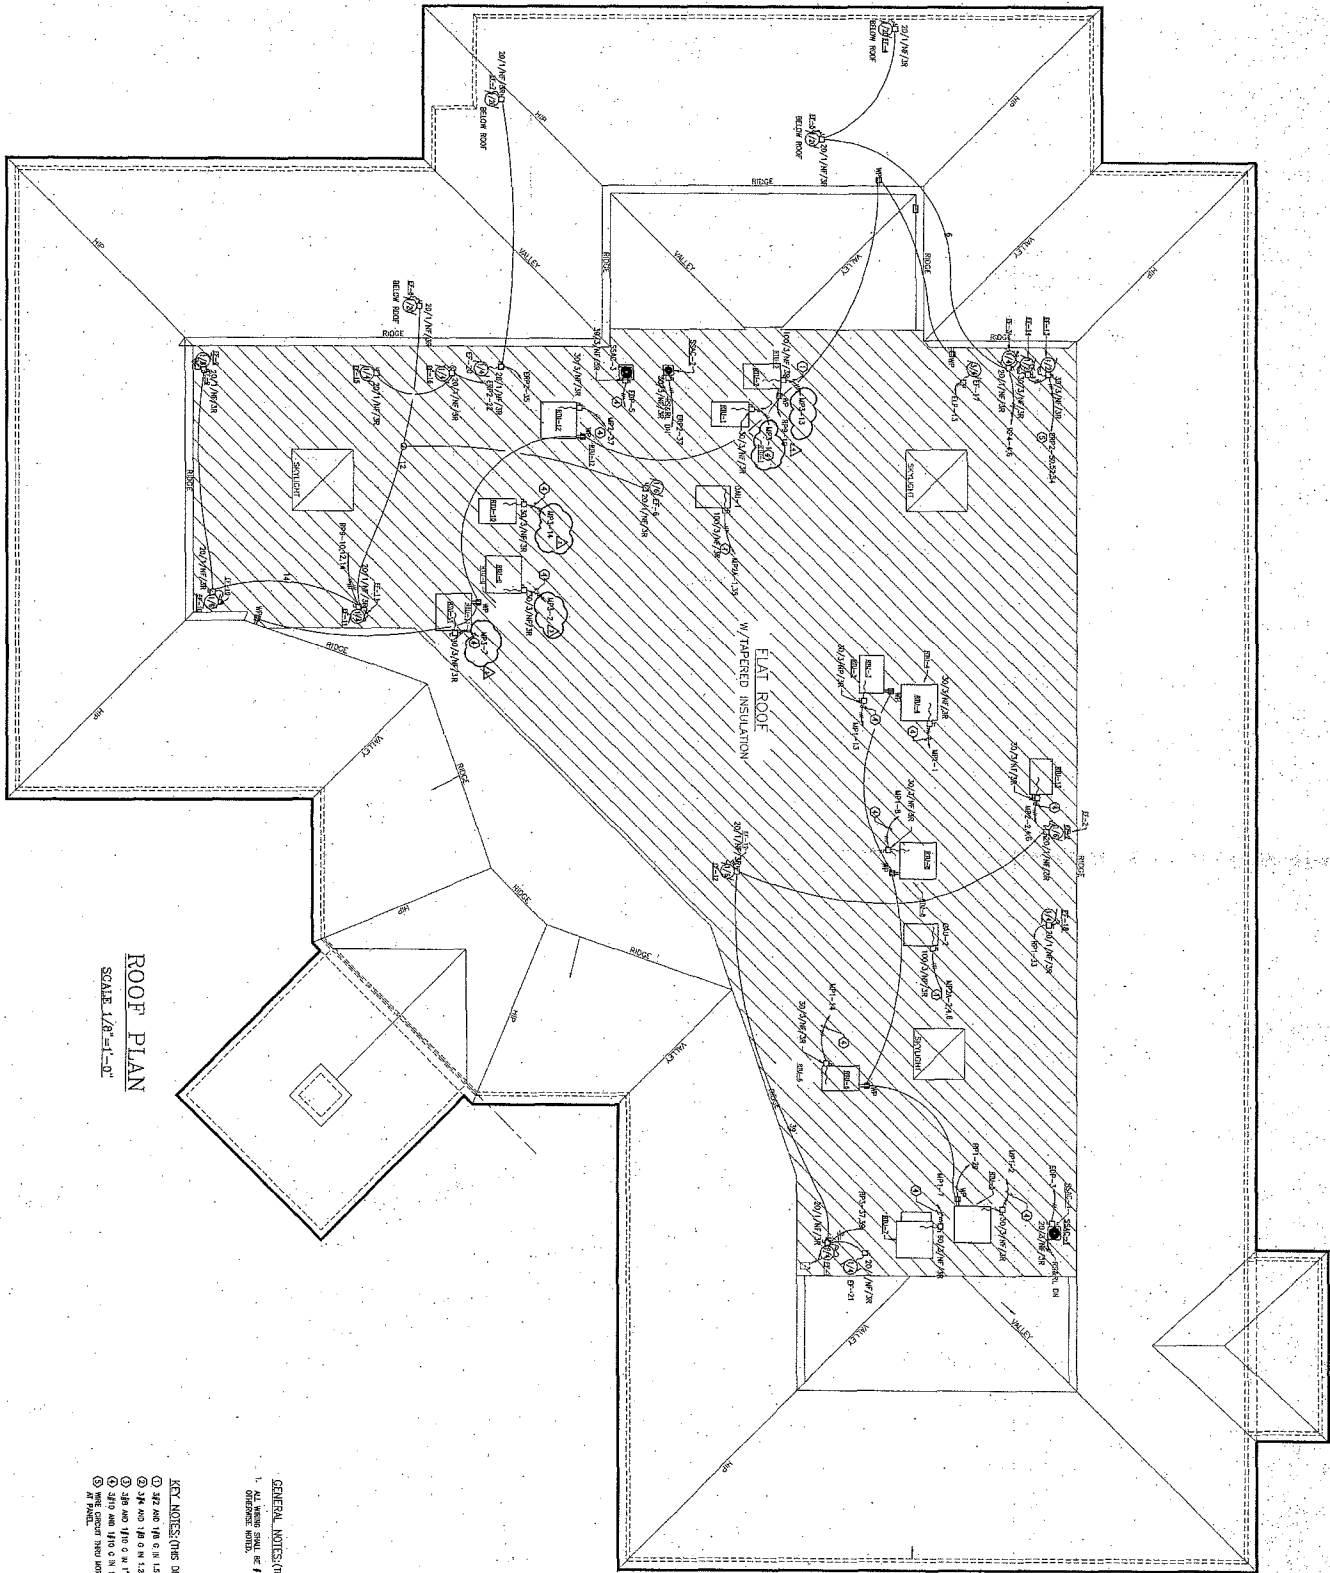


ROOF PLAN
SCALE 1/8"=1'-0"

GENERAL NOTES (THIS DRAWING ONLY)
DAYTONA, FLORIDA
SFO NO. 573 - 184 - 002 - 89
ELECTRICAL ROOF PLAN

HEIDORN DEVELOPMENT
HC 64 BOX 120
SHARPSVILLE, PA 15555
(717) 654-3056 Fax: (717) 654-2083

NO. REVISIONS	DATE	NO. REVISIONS	DATE
1	7/14/00	1	7/14/00

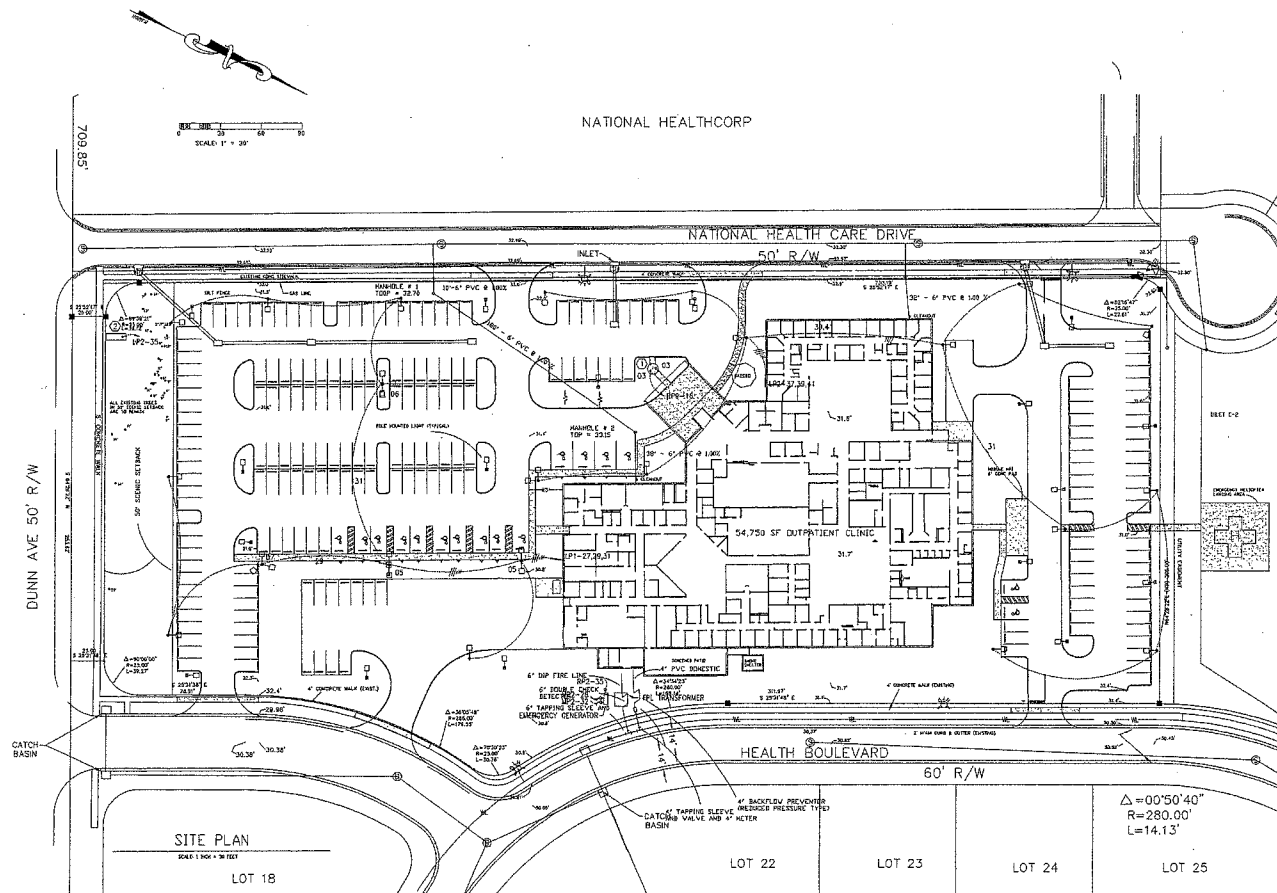

GENERAL NOTES:

1. ALL OUTDOOR FIXTURES SHALL BE TYPE 04 UNLESS OTHERWISE NOTED.
2. ALL WIRING TO OUTDOOR FIXTURES SHALL BE 2/8 AND 1/8 IN 1/2 UNLESS OTHERWISE NOTED.
3. PROVIDE MINIMUM PAGING FOR EACH POLE FIXTURE.
4. REFER TO TIMELOCK DETAIL, SHEET E01 FOR COORDINATE OF OUTSIDE LIGHTING.

KEY NOTES:

- ① INSTALL FIXTURES IN A 180° CONFIGURATION AS SHOWN. INSTALL FIXTURES 3' BACK FROM BASE OF POLE CORRECT THROUGH INTERNAL PHOTOCELL.
- ② MAKE FINAL CONNECTION TO VA ENTRANCE SIGN AS NECESSARY. VERIFY LOCATION PRIOR TO INSTALLATION.

ELECTRICAL SITE PLAN				- VA REVIEW	7/14/00
				- BUILDING PERMIT SET	10/21/00
SCALE					
PROJECT NO.	580221				
DATE	JULY 3, 2000				
SCALE	1" = 30'				
DRAWING NO.	E3.0				
1 OF 1					

