


Roof Drawing Symbols

- ITEMS ON ROOF DECK
- ITEMS ABOVE ROOF DECK
- CLIMBER/STAIR CLIMB
- GOOSENECK VENT
- LIGHTNING PROTECTION
- ROOF DRAIN
- PLUMBING VENT
- SUPPLY/RETURN DUCTS
- EXHAUST VENT
- SCUPPER/OVERFLOW DRAIN
- EPDM ROOF PAVERS
- NO WORK ON THIS ROOF
- ALTERNATE: SEE QUBS AND SPECIFICATIONS FOR MORE INFO.
- SPRINKLER SYSTEM DRY PIPE
- GUARDRAIL
- LADDER W/ CAGE AND CROSSOVER PLATFORM
- LADDER W/ CAGE AND CROSSOVER PLATFORM
- WINDOW CLEANING LADDER/SAFE POINT LOCATION


Specific Plan Notes

Note: Not all specific plan notes appear of every sheet. This list includes all specific plan notes for the entire project.

1. CUT OUT & REMOVE EXISTING ROOF SYSTEM WITH TRIPLE INSULATION. PROVIDE NEW INSULATION COVER BOARD AND EPDM ROOF. REMOVE EXISTING EPDM ROOF INTO EXISTING EPDM ROOF RECOMMENDATIONS. PROVIDE NEW FLASHING AT WALLS, ROOF TOP UNITS, AND ROOF PENETRATIONS AS REQUIRED. PROVIDE NEW METAL SCUPPER IN THIS AREA. CUT OUT & REMOVE EXISTING ROOF SYSTEM TO DECK. INSTALL NEW INSULATION 4" THICK FOR 20' RAUVALE OR GREATER AS REQUIRED FOR SLOPE. INSTALL NEW CURBS AND 2" DRAIN BERMS. PROVIDE NEW FLASHING AT WALLS, ROOF TOP UNITS AND ROOF PENETRATIONS AS REQUIRED. REMOVE EXISTING WALKWAY PADS AS REQUIRED FOR NEW CONSTRUCTION. SPECIFICATION OF ROOF INSULATION, METAL NEW WALKWAY PADS IN SAME LOCATION. MATCH EXISTING EXISTING LADDER. MODIFY LOOSE END LENGTH TO BE NO LESS THAN 4' ABOVE EPDM. CLEAN ROOF DRAIN AND PIPE. VIDEO 1/4" DIA FOR CLEAR OBSTRUCTIONS UNITS STORM DRAINS LATERAL BELOW GRADE. REMOVE ROOF DRAIN AND REPLACE WITH NEW ROOF DRAIN EQUAL SIZE. EXISTING LIGHTNING PROTECTION. REMOVE FOR WORK. REINSTALL. NOT USED. REMOVE REFRESH AND REPLACE STONE CAP. PROVIDE NEW WALK PADS. TYPICAL MATCH EXISTING. PROVIDE NEW SCUPPER OPENING THROUGH EXISTING GADDERY PARAPET AND PROVIDE SCUPPER PER DETAIL. CHANGE: ROUTE DOWNSPOUT HORIZONTALLY TO THIS LOCATION WITH 1/4" PER FOOT SLOPE. MINIMUM TURN DOWN AND DISCHARGE ON ROOF BELOW. PROVIDE WALL BRACKET 2" P.C. MAX. GENERAL CONTRACTOR TO COORDINATE WITH CORP/ONE PERFORMING ANY AND ALL WORK IN THE FRONT OF DESIGNATED CUT OUT BIO-HAZARDOUS AND LAB EXHAUST VENTS.

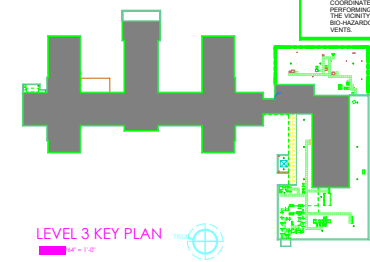

LEVEL 3 KEY PLAN
1/4" = 1'-0"

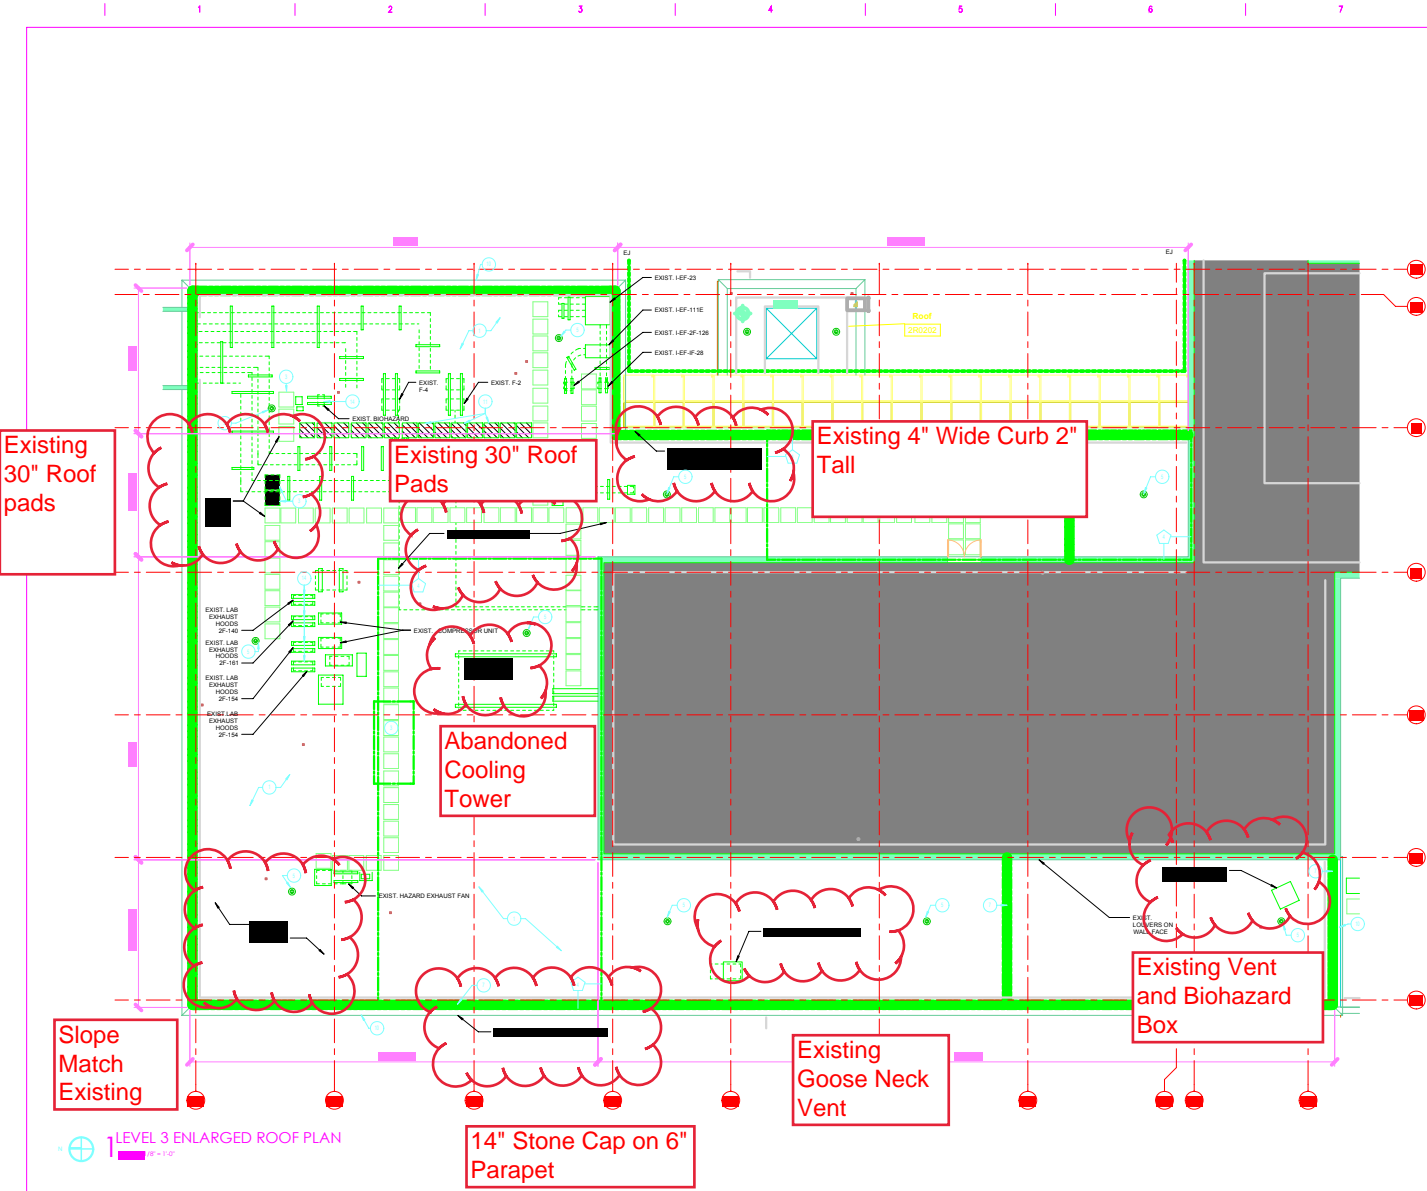

Existing 30" Roof pads

Existing 30" Roof Pads

Existing 4" Wide Curb 2" Tall

Abandoned Cooling Tower

Existing Vent and Biohazard Box

Existing Goose Neck Vent

Slope Match Existing

14" Stone Cap on 6" Parapet

Revisions:	Date:

VAMC CLARKSBURG
1 MED CENTER DRIVE CLARKSBURG, WV 26301

ARCHITECT/ENGINEERS:

BID DOCUMENTS			
Drawing Title LEVEL 3 ROOF PLANS	Project Title REPLACEMENT OF OPERATING ROOMS AND ICU ROOFS	Project Number Building Number CLINICAL ADDITION	Office of Facilities Management
Approved for Design Concept:	Location LOUIS A. JOHNSON VAMC	Drawing Number 2 of 2	VA Project Number 540-18-0255
Date 05-07-2018	Checked By:	Drawn By:	