

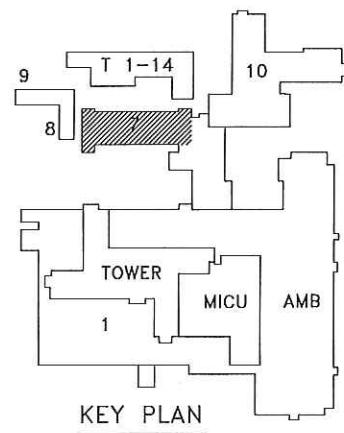


RESEARCH & EDUCATION BLDG. 7  
1ST FLOOR PLAN  
INFORMATION NOT VERIFIED

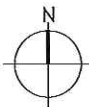

LEGEND:  
 UNDER CONSTRUCTION




(36) PANES

PANES INCLUDES (7) ALL FLOORS


PANES (7) INCLUDES ALL FLOORS


(1) UNDER BLDG. 1 COUNT OPENING REQUIRES METAL TRIM


(36) PANES

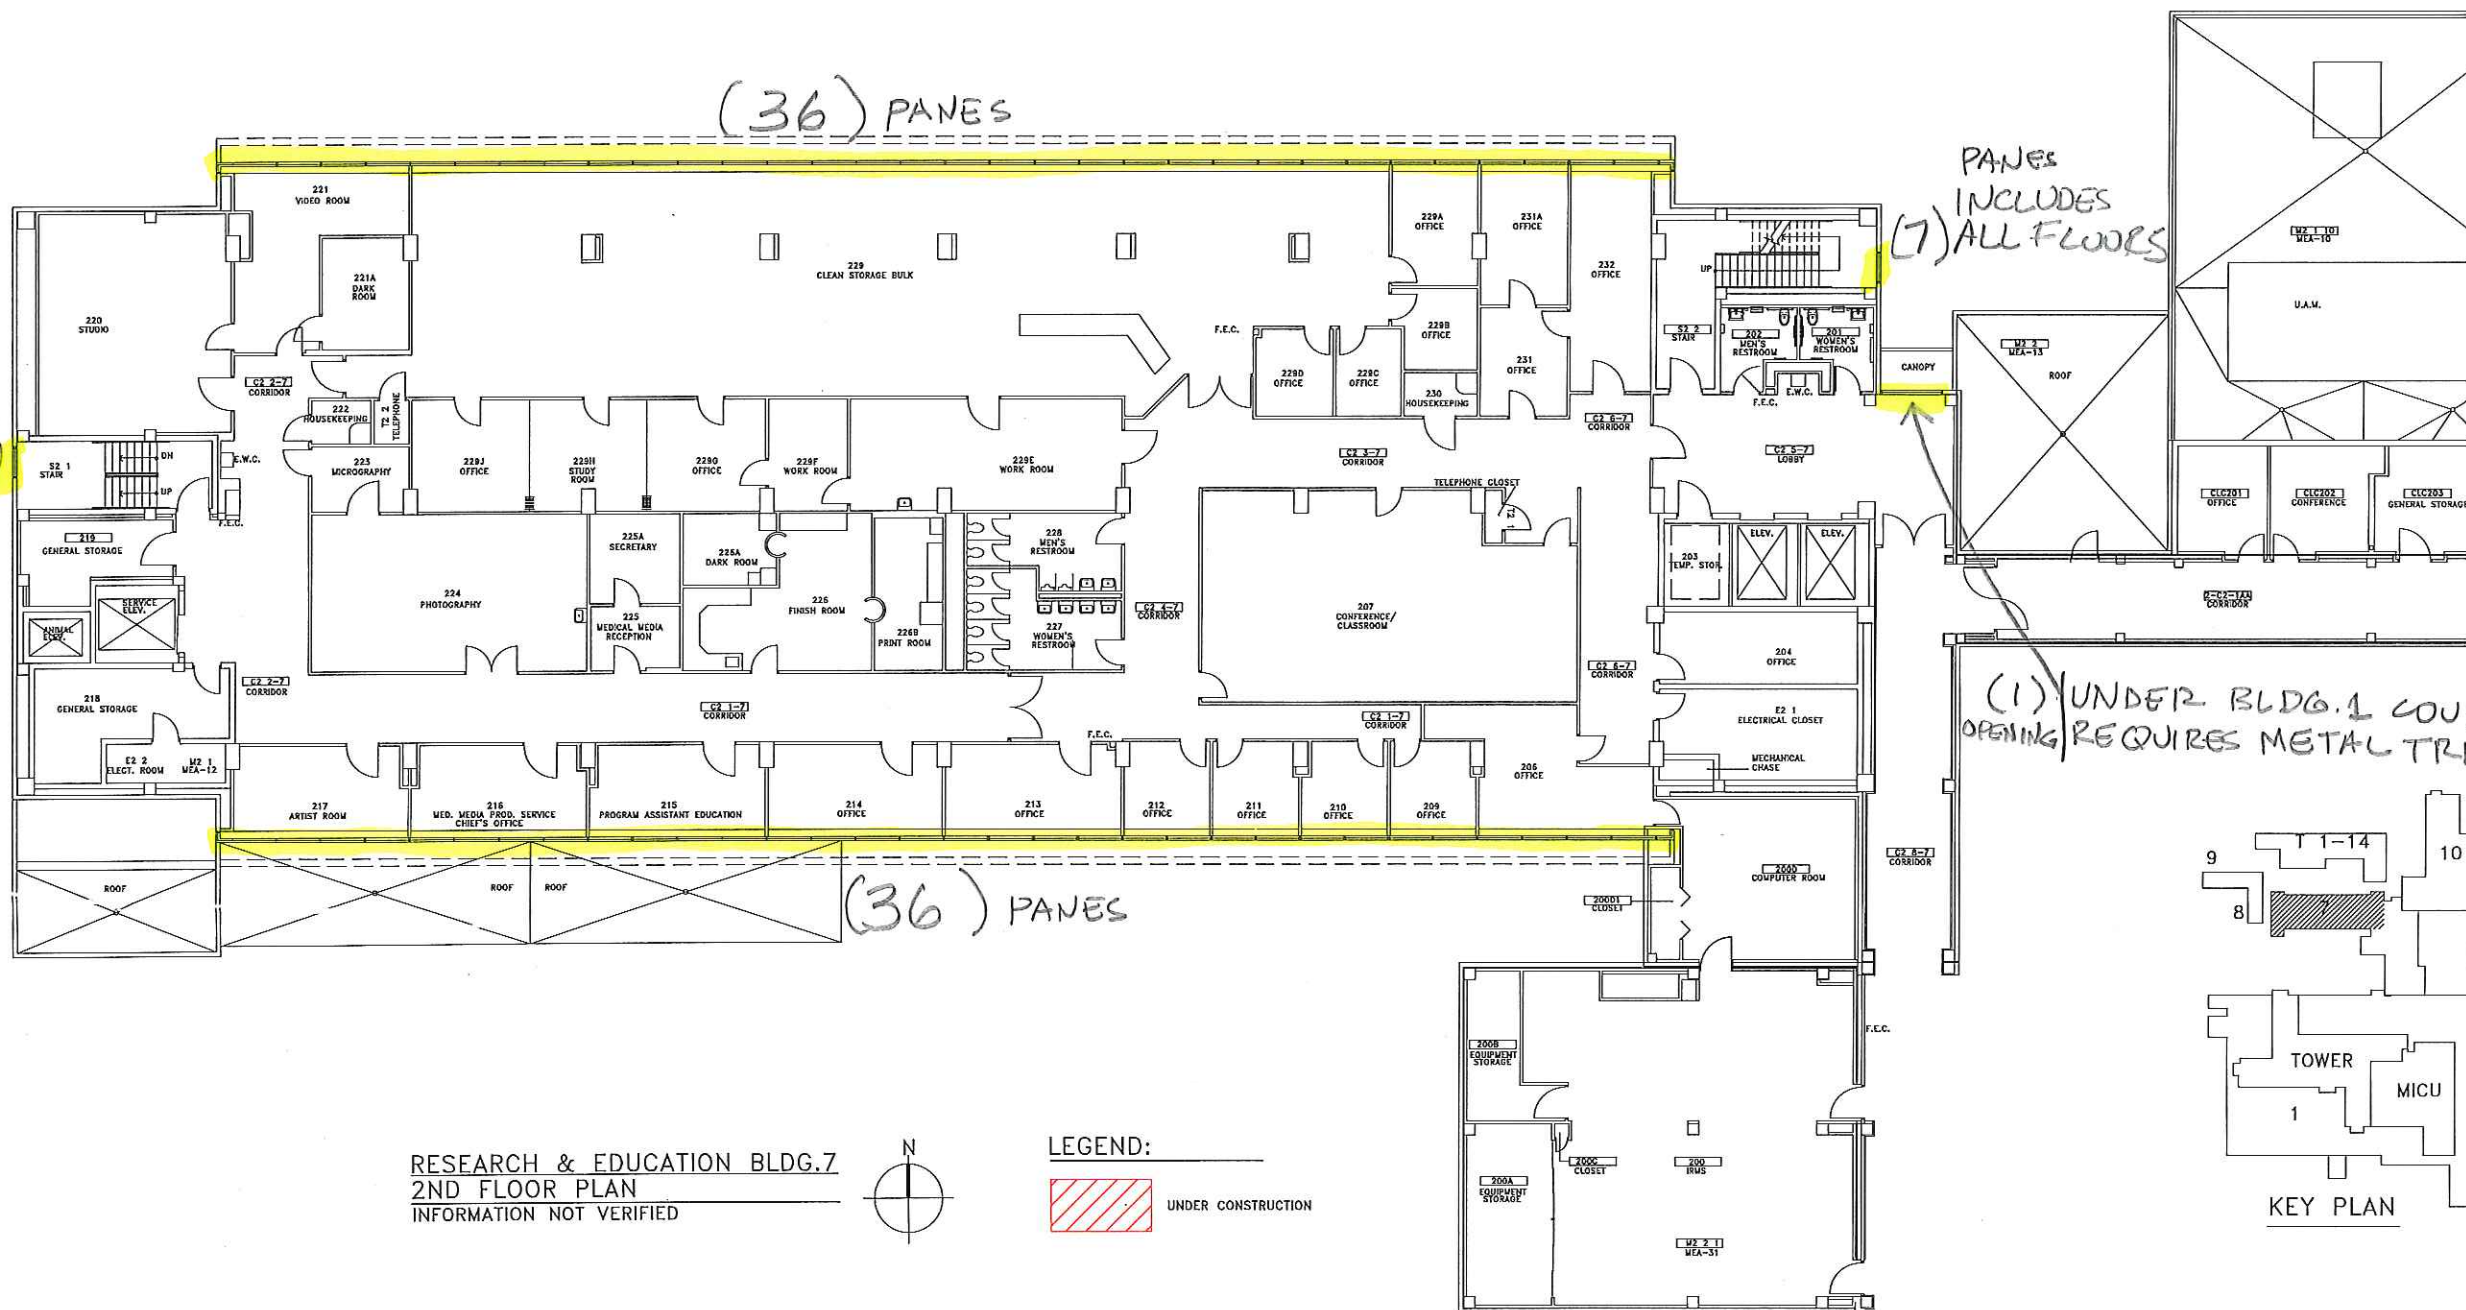


RESEARCH & EDUCATION BLDG. 7  
2ND FLOOR PLAN  
INFORMATION NOT VERIFIED

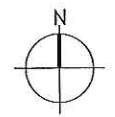


LEGEND:  
 UNDER CONSTRUCTION

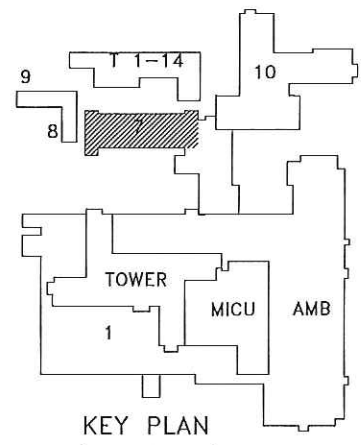


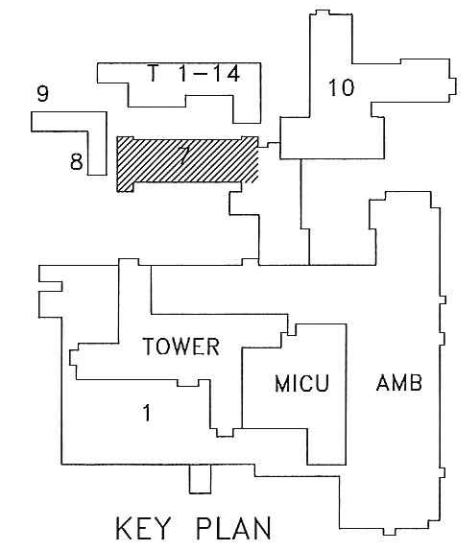
KEY PLAN

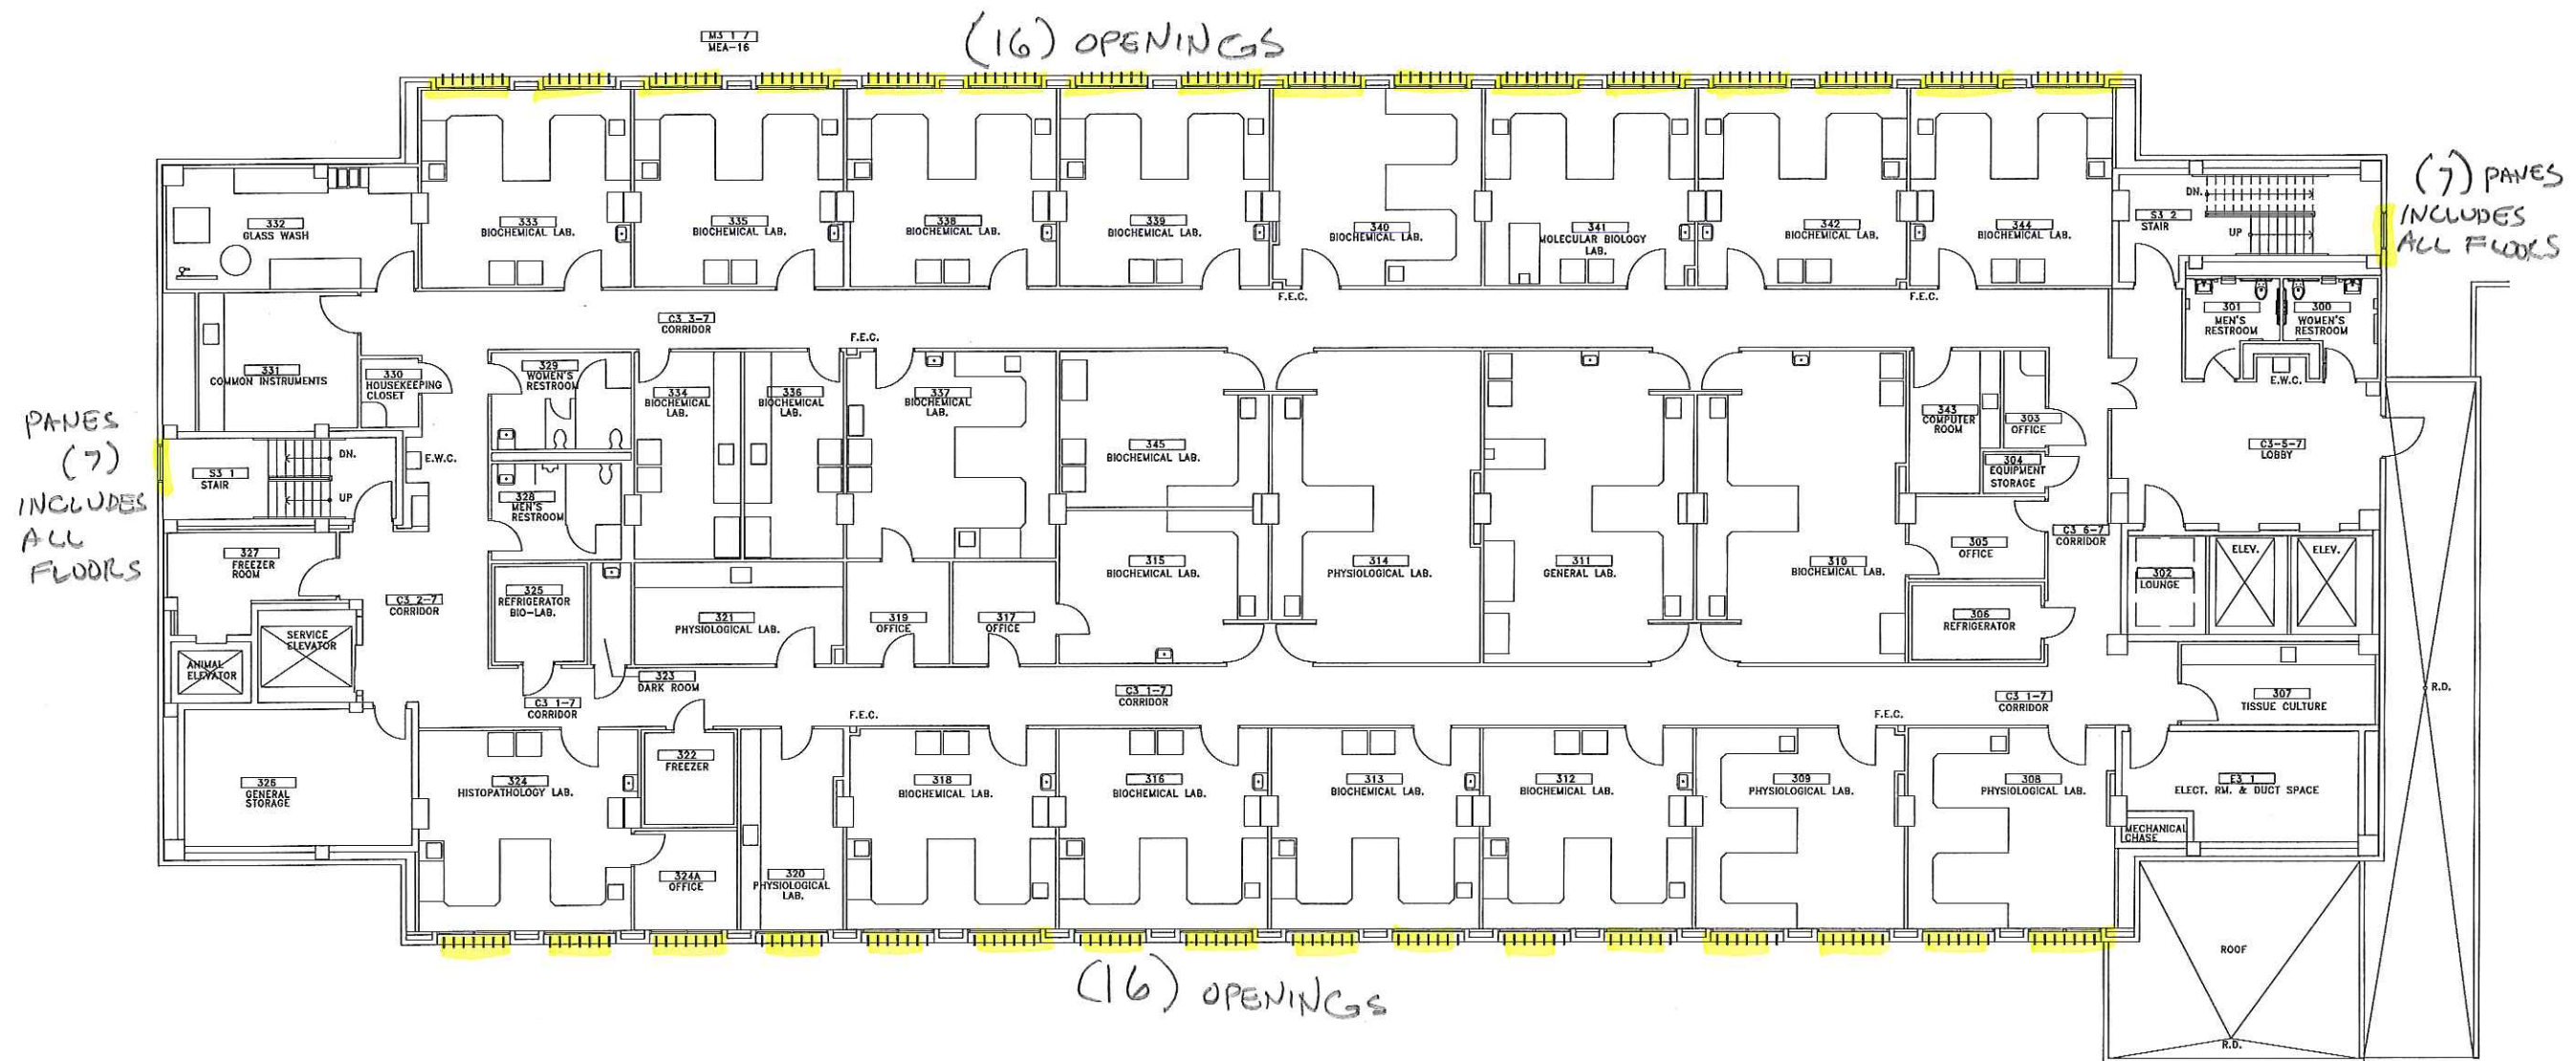

RESEARCH & EDUCATION BLDG. 7  
 3RD FLOOR PLAN  
 INFORMATION NOT VERIFIED

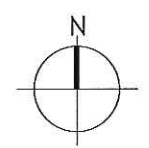


LEGEND:  
 UNDER CONSTRUCTION



KEY PLAN

(16) openings

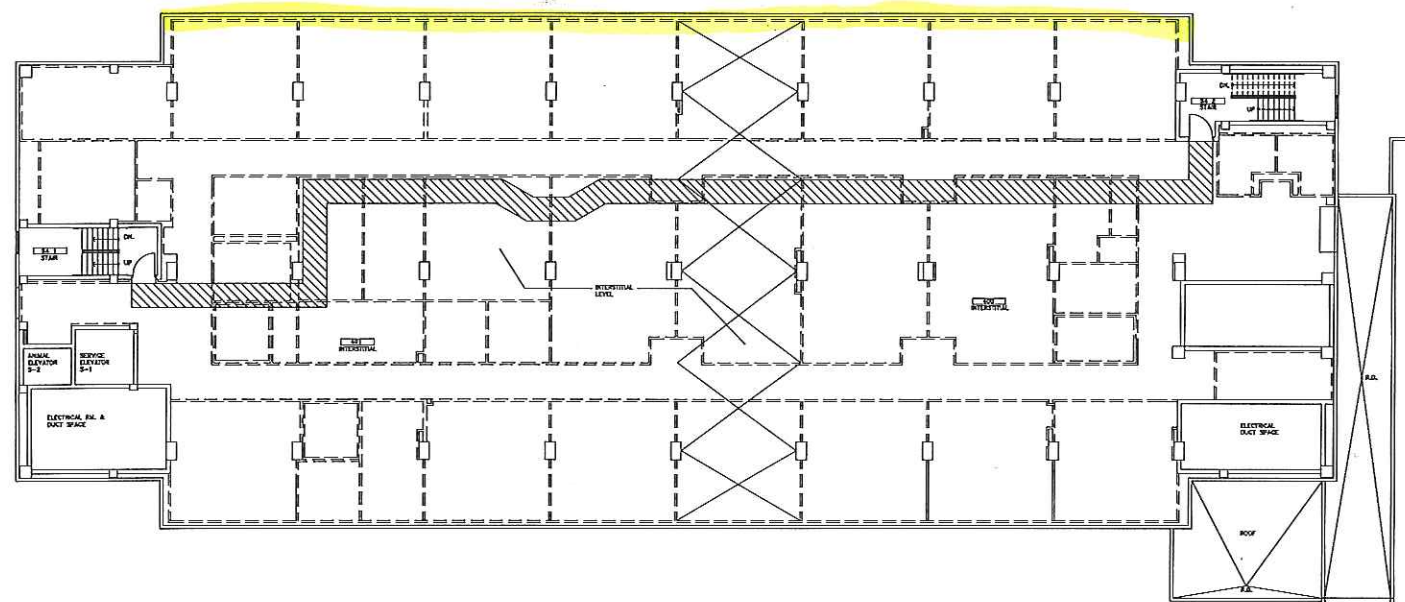

RESEARCH & EDUCATION BLDG. 7  
4TH FL. INTERSTITIAL FLOOR PLAN  
INFORMATION NOT VERIFIED



LEGEND:  
 UNDER CONSTRUCTION

