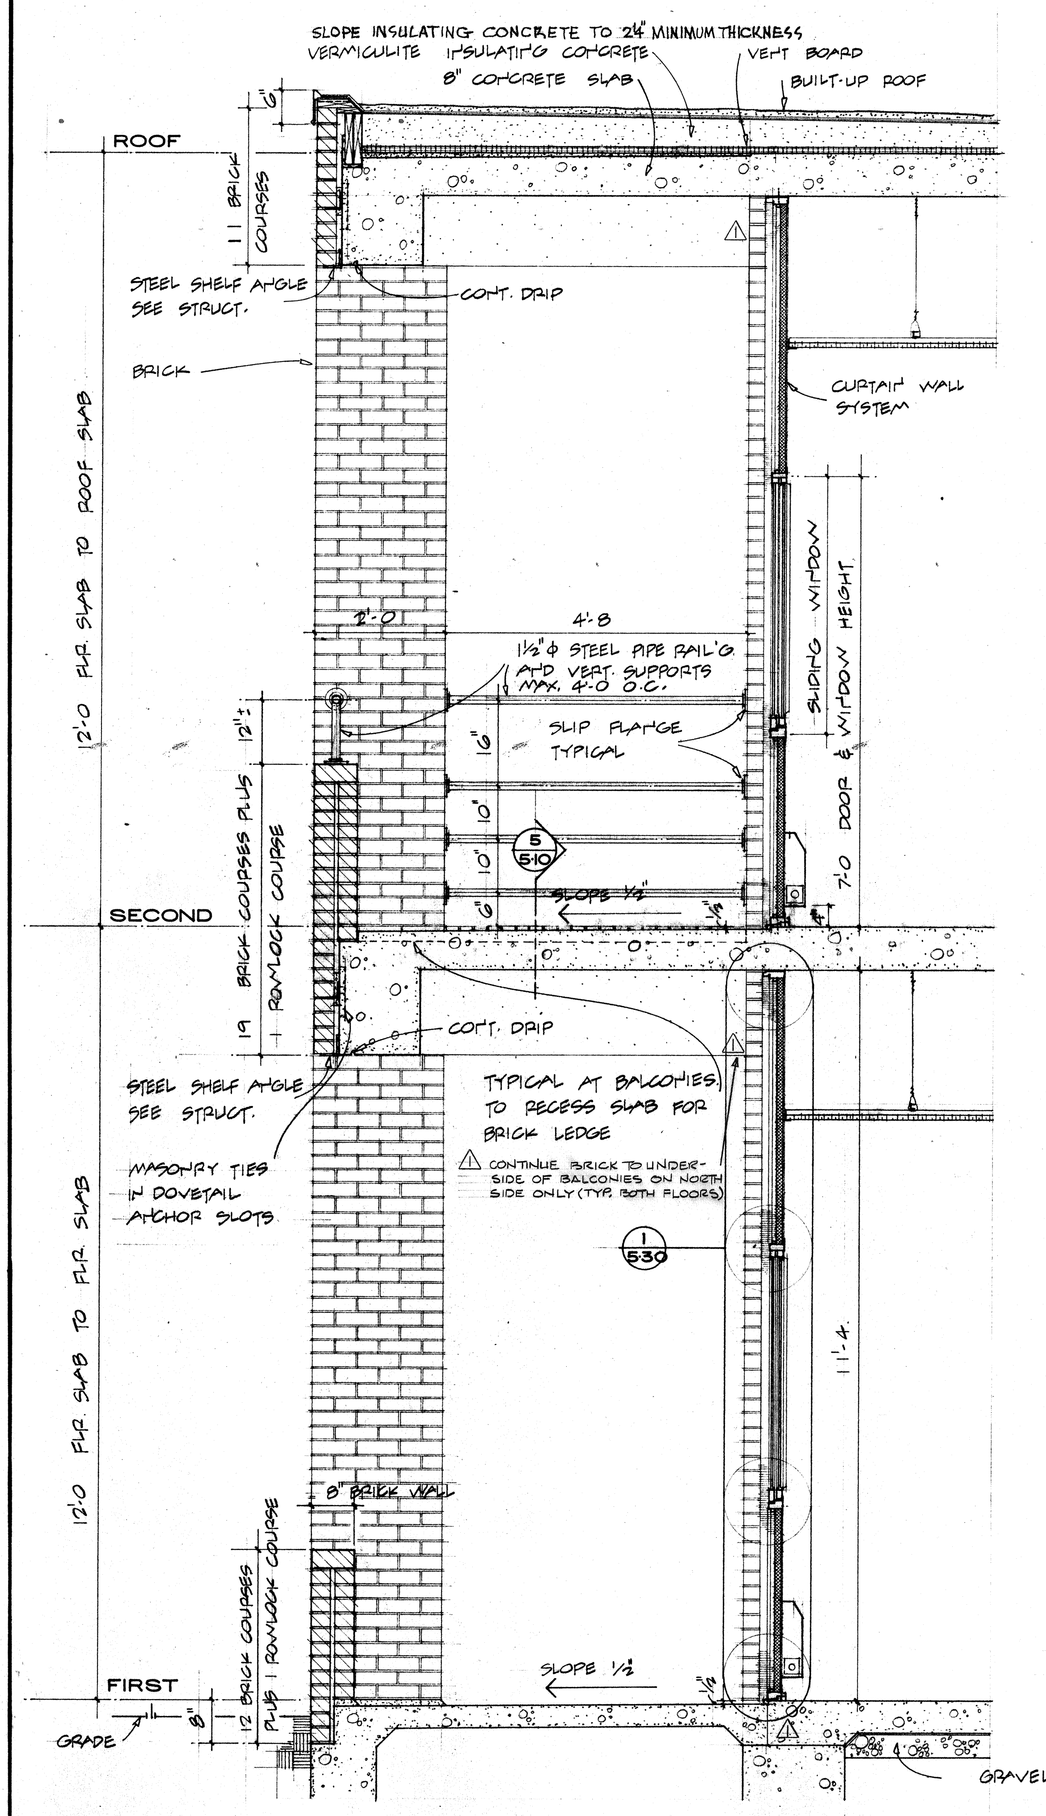

1 5-9 SECTION · PATIENT ROOM BALCONY / PORCH NORTH ELEVATION
3/4" = 1'-0

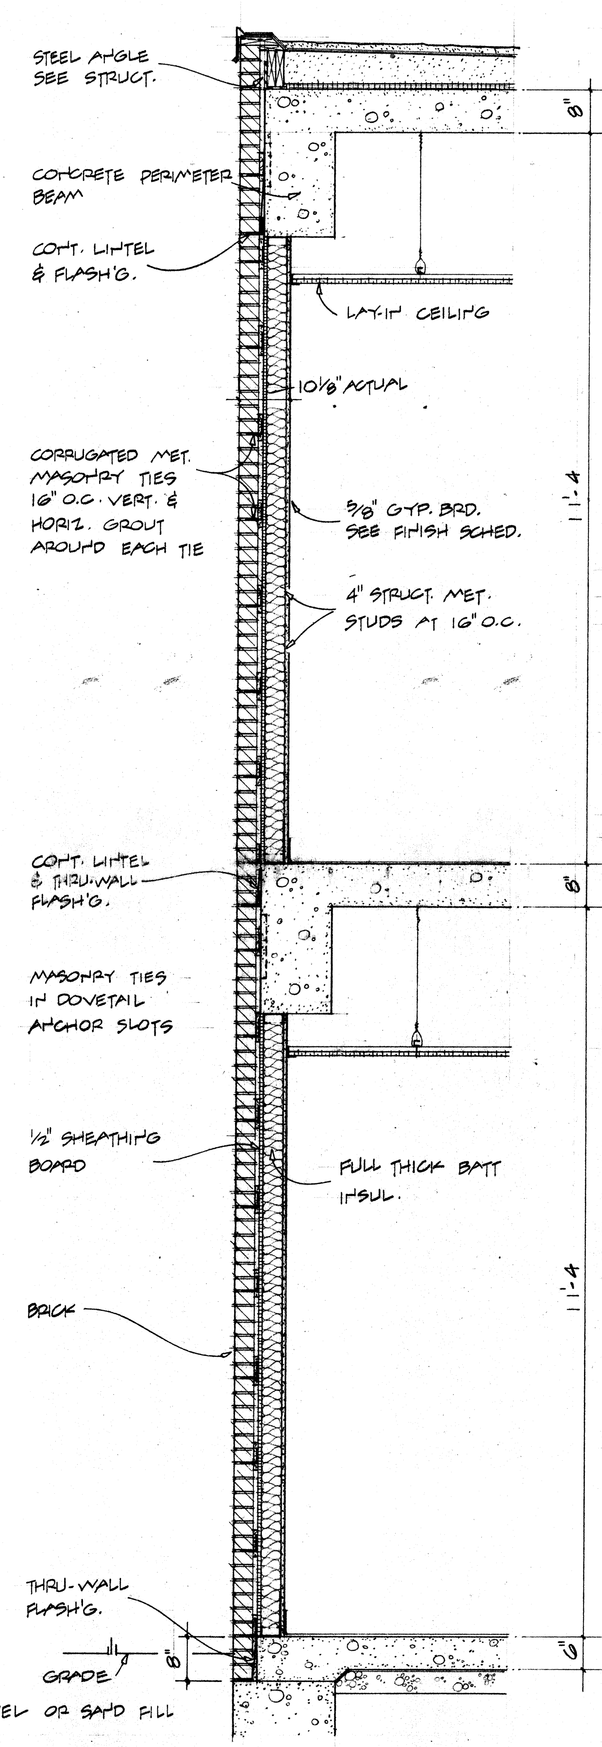

2 5-9 SECTION · TYPICAL AT BRICK & METAL STUD WALL
3/4" = 1'-0

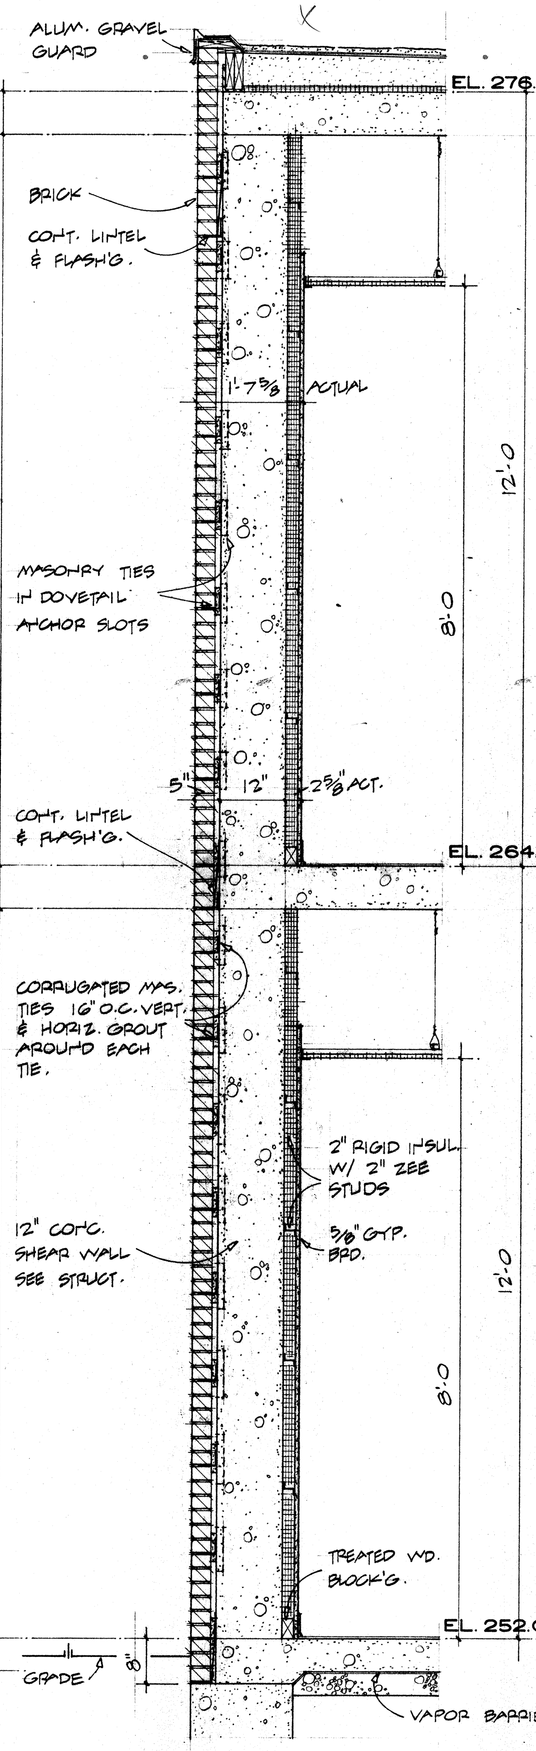

3 5-9 SECTION · EXT. SHEAR WALL
3/4" = 1'-0

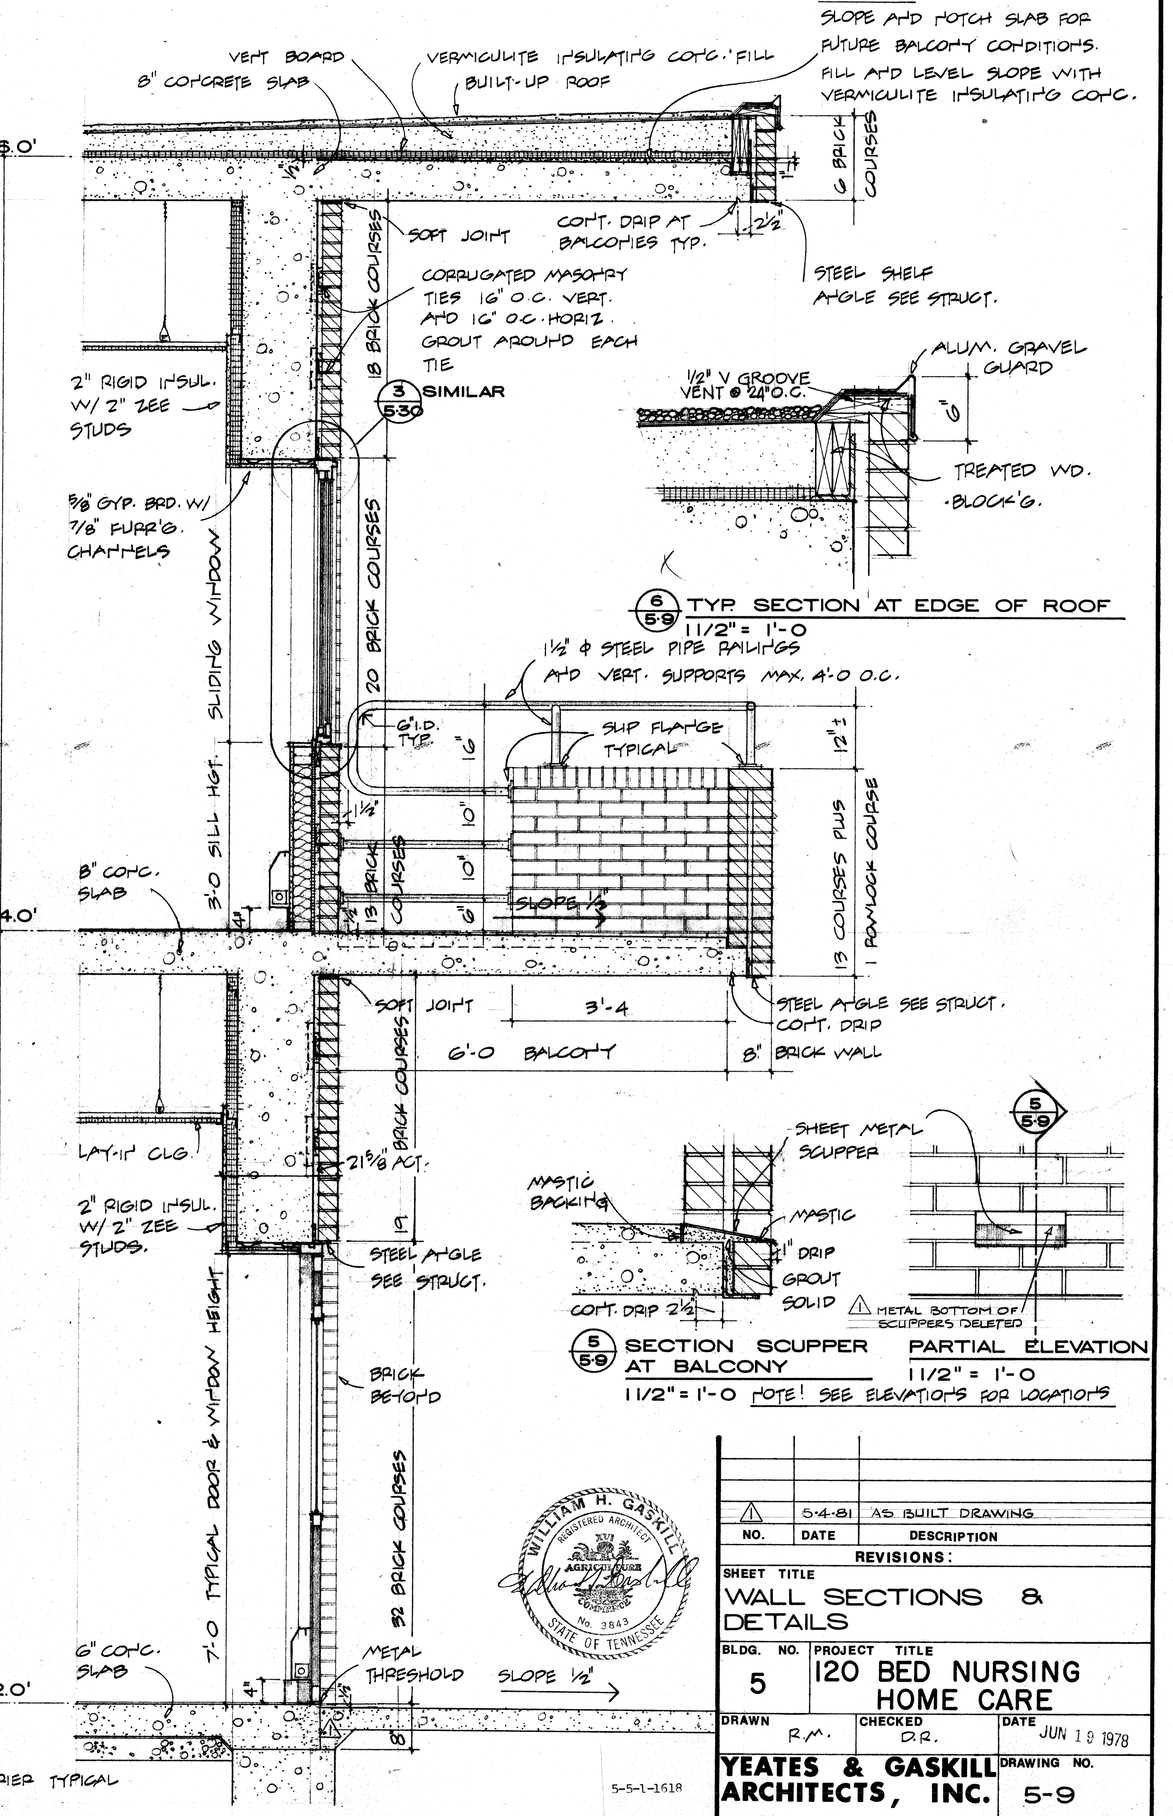

4 5-9 SECTION · PATIENT ROOM BALCONY / PORCH SOUTH ELEVATION
3/4" = 1'-0

5-5-1-1618

NO.	DATE	DESCRIPTION
⚠	5-4-81	AS BUILT DRAWING

REVISIONS:

SHEET TITLE: WALL SECTIONS & DETAILS

BLDG. NO. 5 — PROJECT TITLE: 120 BED NURSING HOME CARE

DRAWN: R.M. — CHECKED: D.R. — DATE: JUN 19 1978

YEATES & GASKILL ARCHITECTS, INC.
2080 PEABODY AVE.
MEMPHIS, TENNESSEE 38104

DRAWING NO. 5-9
DWG 9 OF 32
PROJECT NO. 614-007

APPROVED: PROJECT DIRECTOR

VETERANS ADMINISTRATION

LOCATION: VAH, MEMPHIS, TENNESSEE

WILLIAM H. GASKILL — REGISTERED ARCHITECT — AGRICULTURE — TENNESSEE — No. 3843 — STATE OF TENNESSEE

THREE INCHES EQUALS ONE FOOT | ONE AND ONE HALF INCH EQUALS ONE FOOT | ONE INCH EQUALS ONE FOOT | THREE FOURTHS INCH EQUALS ONE FOOT | ONE HALF INCH EQUALS ONE FOOT | THREE EIGHTS INCH EQUALS ONE FOOT | ONE FOURTH INCH EQUALS ONE FOOT | ONE EIGHTH INCH EQUALS ONE FOOT