


one eighth inch = one foot
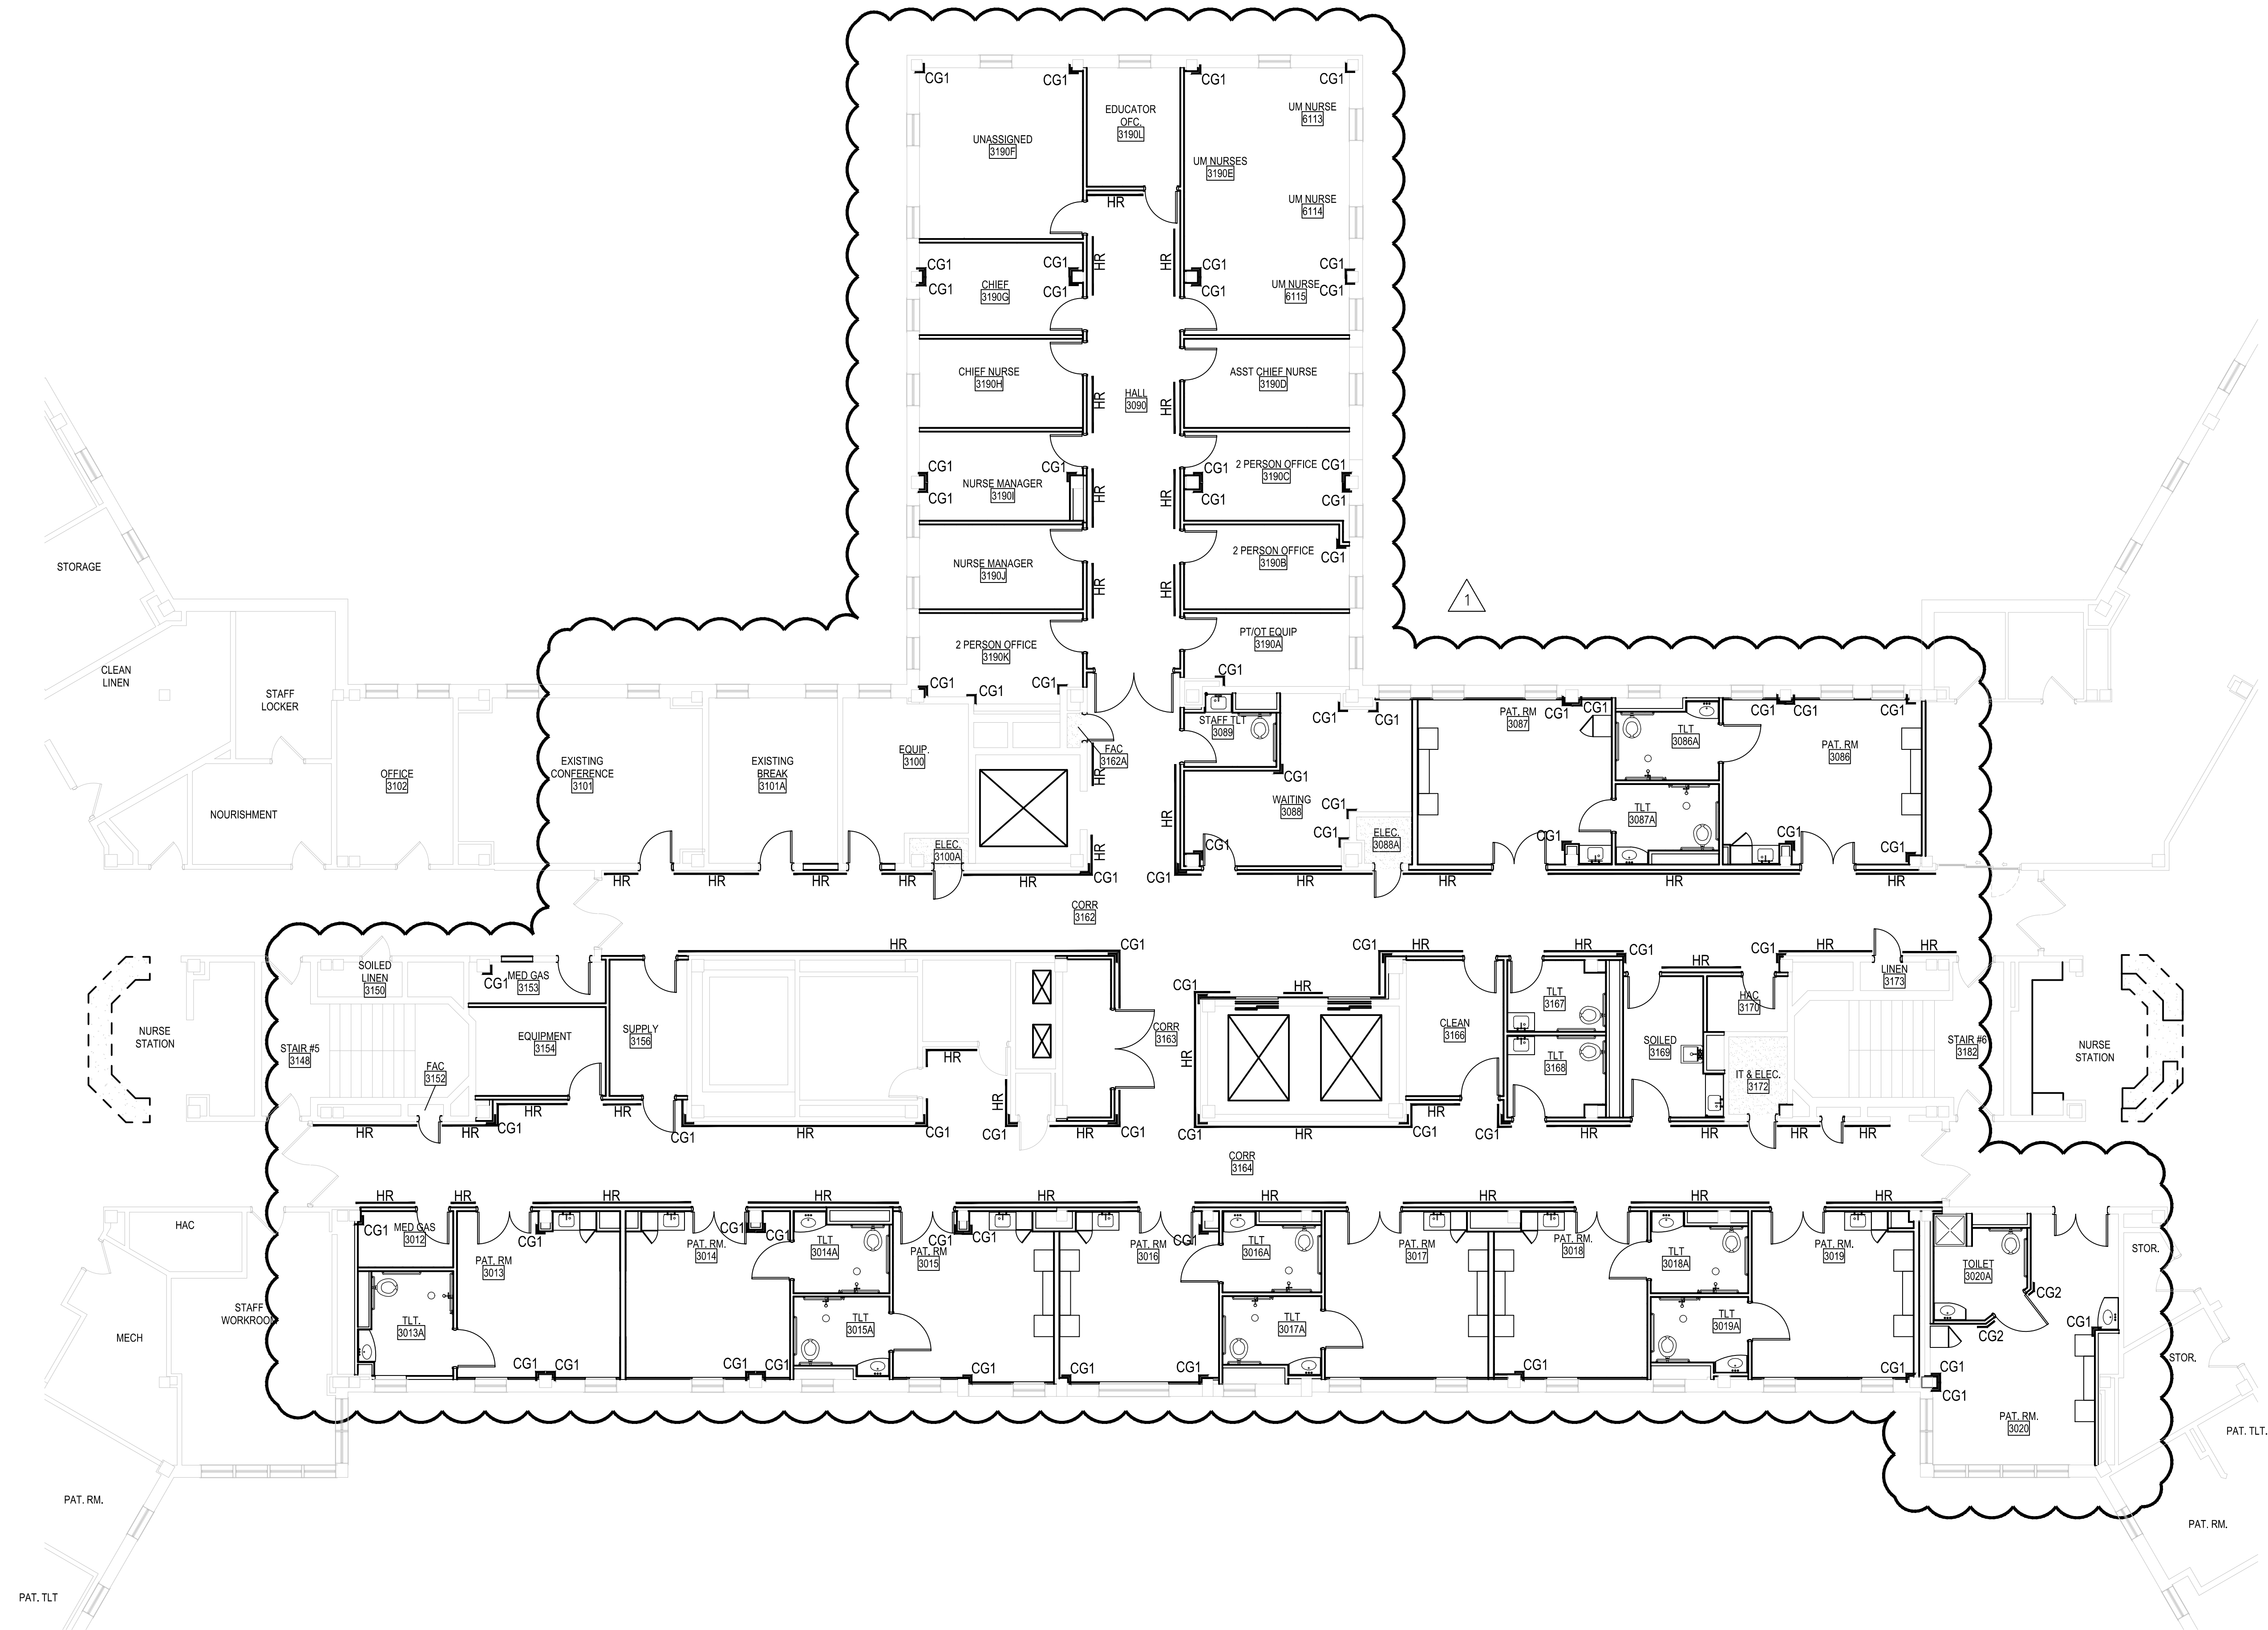


WALL PROTECTION PLAN LEGEND

- HR HANDRAIL LOCATIONS
- CG# CORNER GUARD LOCATIONS

GENERAL NOTES

- REFERENCE FINISH SCHEDULE ON IN601.
- ALL OUTSIDE CORNERS TO RECEIVE CORNER GUARDS. REFER TO FINISH SCHEDULE FOR COLOR AND MANUFACTURER.
- PROVIDE AND INSTALL APPROXIMATELY 500 +/- LINEAR FEET OF HAND RAIL PER MANUFACTURER'S INSTRUCTIONS. REFERENCE FINISH SCHEDULE FOR MANUFACTURER AND MODEL. ACTUAL LENGTH OF HAND RAIL TO BE FIELD VERIFIED PRIOR TO ORDERING AND INSTALLATION.
- HAND RAIL LOCATIONS SHOWN ON THIS PLAN ARE FOR GRAPHICAL REFERENCE ONLY. DO NOT TAKE MEASUREMENTS FROM PLAN. ALL HAND RAIL LOCATIONS AND MEASUREMENTS ARE TO BE FIELD VERIFIED AFTER CONSTRUCTION OF NEW WALLS AND INSTALLATION OF NEW DOOR FRAMES.
- TERMINATION POINTS OF HAND RAILS TO BE DETERMINED BY INSTALLER. DO NOT INSTALL HAND RAIL IN AREAS BEHIND DOOR SWING.
- DO NOT INSTALL HAND RAILS ON WALLS 24" OR LESS IN LENGTH UNLESS PART OF A CONTINUANCE OF A LONGER SECTION OF HAND RAIL THAT EXTENDS AROUND CORNER.
- INSTALL CORNER GUARDS PER MANUFACTURER'S INSTRUCTIONS. REFERENCE FINISH SCHEDULE FOR MANUFACTURER AND MODEL.
- ANGLED WALLS TO RECEIVE CORNER GUARD (CG2) AT TOILET ROOM 3020A TO BE VERIFIED IN FIELD PRIOR TO ORDERING AND INSTALLATION.

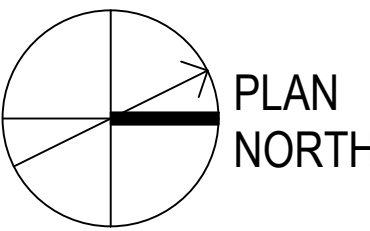

FINAL CONSTRUCTION DRAWINGS - FULLY SPRINKLERED

CONSULTANTS: FreemanWhite 8845 RED OAK BLVD. CHARLOTTE, NC 28217-5593 PHONE: 704.523.2230 FAX: 704.523.2235 www.freemanwhite.com LeGrand Engineering, Inc. 215 PARK AVE SE AKEN, SC 29801 PHONE: 803.502.0657 FAX: 803.540.4648 www.legrandengineering.com LAURENCE, RICKNER & SORRELL, INC. 8701 RED OAK BLVD, SUITE 300 CHARLOTTE, NC 28217-5593 PHONE: 704.522.0495 FAX: 704.522.0499 www.lrspc.net		SEAL 6361 6/19/2018	ARCHITECT/ENGINEERS: Atriax GROUP Atriax, pllc 102 3rd Avenue, NE PO Box 1629, Hickory, NC 28603 T: 828.315.9962 F: 828.315.9964 www.atriaxgroup.com NC Engineering License No.: P-0214 NC Architectural License No.: 51254	Drawing Title INTERIOR WALL PROTECTION PLAN Approved Project Director -	Project Title RENOVATE BUILDING 2 FOR MEDICAL SURGICAL MODERNIZATION Location W.G. HEFNER VAMC SALISBURY, NC Date MAY 1, 2018 Checked EHH Drawn MM	Project Number 659-17-101 Building Number 2 Drawing Number IN103 Dwg. 3 of 6	Office of Construction and Facilities Management Department of Veterans Affairs
---	--	---------------------------------------------	---	---	---	---	---