


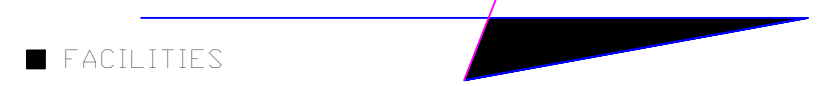

NEED ALL ROOM NAMES AND NUMBERS

FULLY SPRINKLERED
INDUSTRIAL OCCUPANCY

BUILDING 2&10



9013-118