
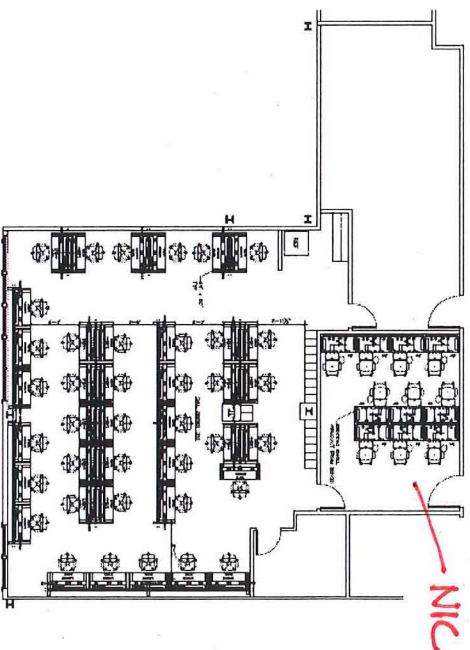


Note: Existing Furniture moved to training room by in-house installers. Not part of the Scope of work.

----- Access via Main Hallway Building 11, Basement Room BB103 -----

Scope of Work for Benching and ~~Privacy Sound Screens~~ ONLY

Within one large open room consisting of 39 Bench Stations.

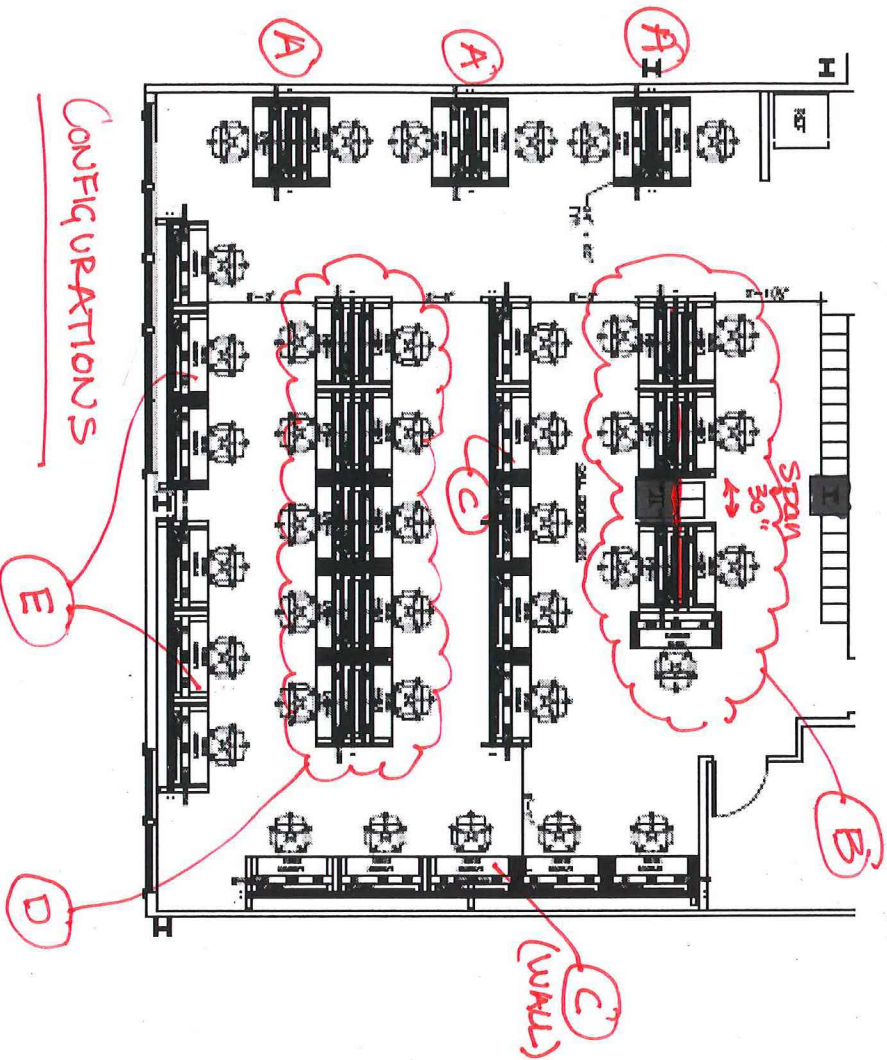

HAS
CALL CENTER

Attachment B

5/18/18