TRSF#	BLDG. & MANUFACTURER	TYPE	KVA	NOTES
TR16-1	B-16 PAD - G.E.	4W-3Ø	112.5	120/208 VOLT
TR17-1	B-17 VAULT-VANTRAN	4W-3Ø	225	120/208 VOLT
TR74-1	B-74 PAD - SPOKANE	4W-3Ø	500	120/208 VOLT
TR75-1	B-75 PAD - G.E.	4W-3Ø	500	120/208 VOLT
TR76-1	B-76 PAD - G.E.	4W-3Ø	300	120/208 VOLT
TR77-1	B-77 PAD - G.E.	4W-3Ø	500	120/208 VOLT
	B-130 VAULT- VANTRAN	4W-3Ø	125	120/208 VOLT
	UNDER HILL VAULT - VANTRAN	4W-3Ø	125	120/208 VOLT

TRSF#	BLDG. & MANUFACTURER	TYPE	KVA	NOTES
TR1-1	B-1 PAD - SPOKANE	4W-3Ø	300	120/208 VOLT
TR2-1	B-2 PAD - G.E.	4W-3Ø	500	277/480 VOLT
TR2A-1	B-2A PAD - R.T.E.	4W-3Ø	500	120/208 VOLT
TR2A-2	B-2A PAD - STANDARD	4W-3Ø	500	277/480 VOLT
TR4-1	B-4 PAD - STANDARD	4W-3Ø	500	120/208 VOLT
TR4-2	B-4 PAD - STANDARD	4W-3Ø	500	120/208 VOLT
TR5-1	B-5 PAD - WESTINGHOUSE	4W-3Ø	225	120/208 VOLT
TR7-1	B-7 PAD - G.E.	4W-3Ø	300	277/480 VOLT
TR8-1	B-8 PAD - G.E.	4W-3Ø	500	120/208 VOLT
TR9-1	B-9 PAD - G.E.	4W-3Ø	300	120/208 VOLT
TR10-1	B-10 PAD - FAYTRAN	4W-3Ø	500	120/208 VOLT
TR11-1	B-11 PAD - G.E.	4W-3Ø	300	120/208 VOLT
TR12-1	B-12 PAD - FAYTRAN	4W-3Ø	500	120/208 VOLT
TR13-1	B-13 PAD - BOULDER	4W-3Ø	225	120/208 VOLT
TR14-1	B-14 PAD - G.E.	4W-3Ø	300	120/208 VOLT
TR15-1	B-15 PAD - G.E.	4W-3Ø	112.5	120/208 VOLT

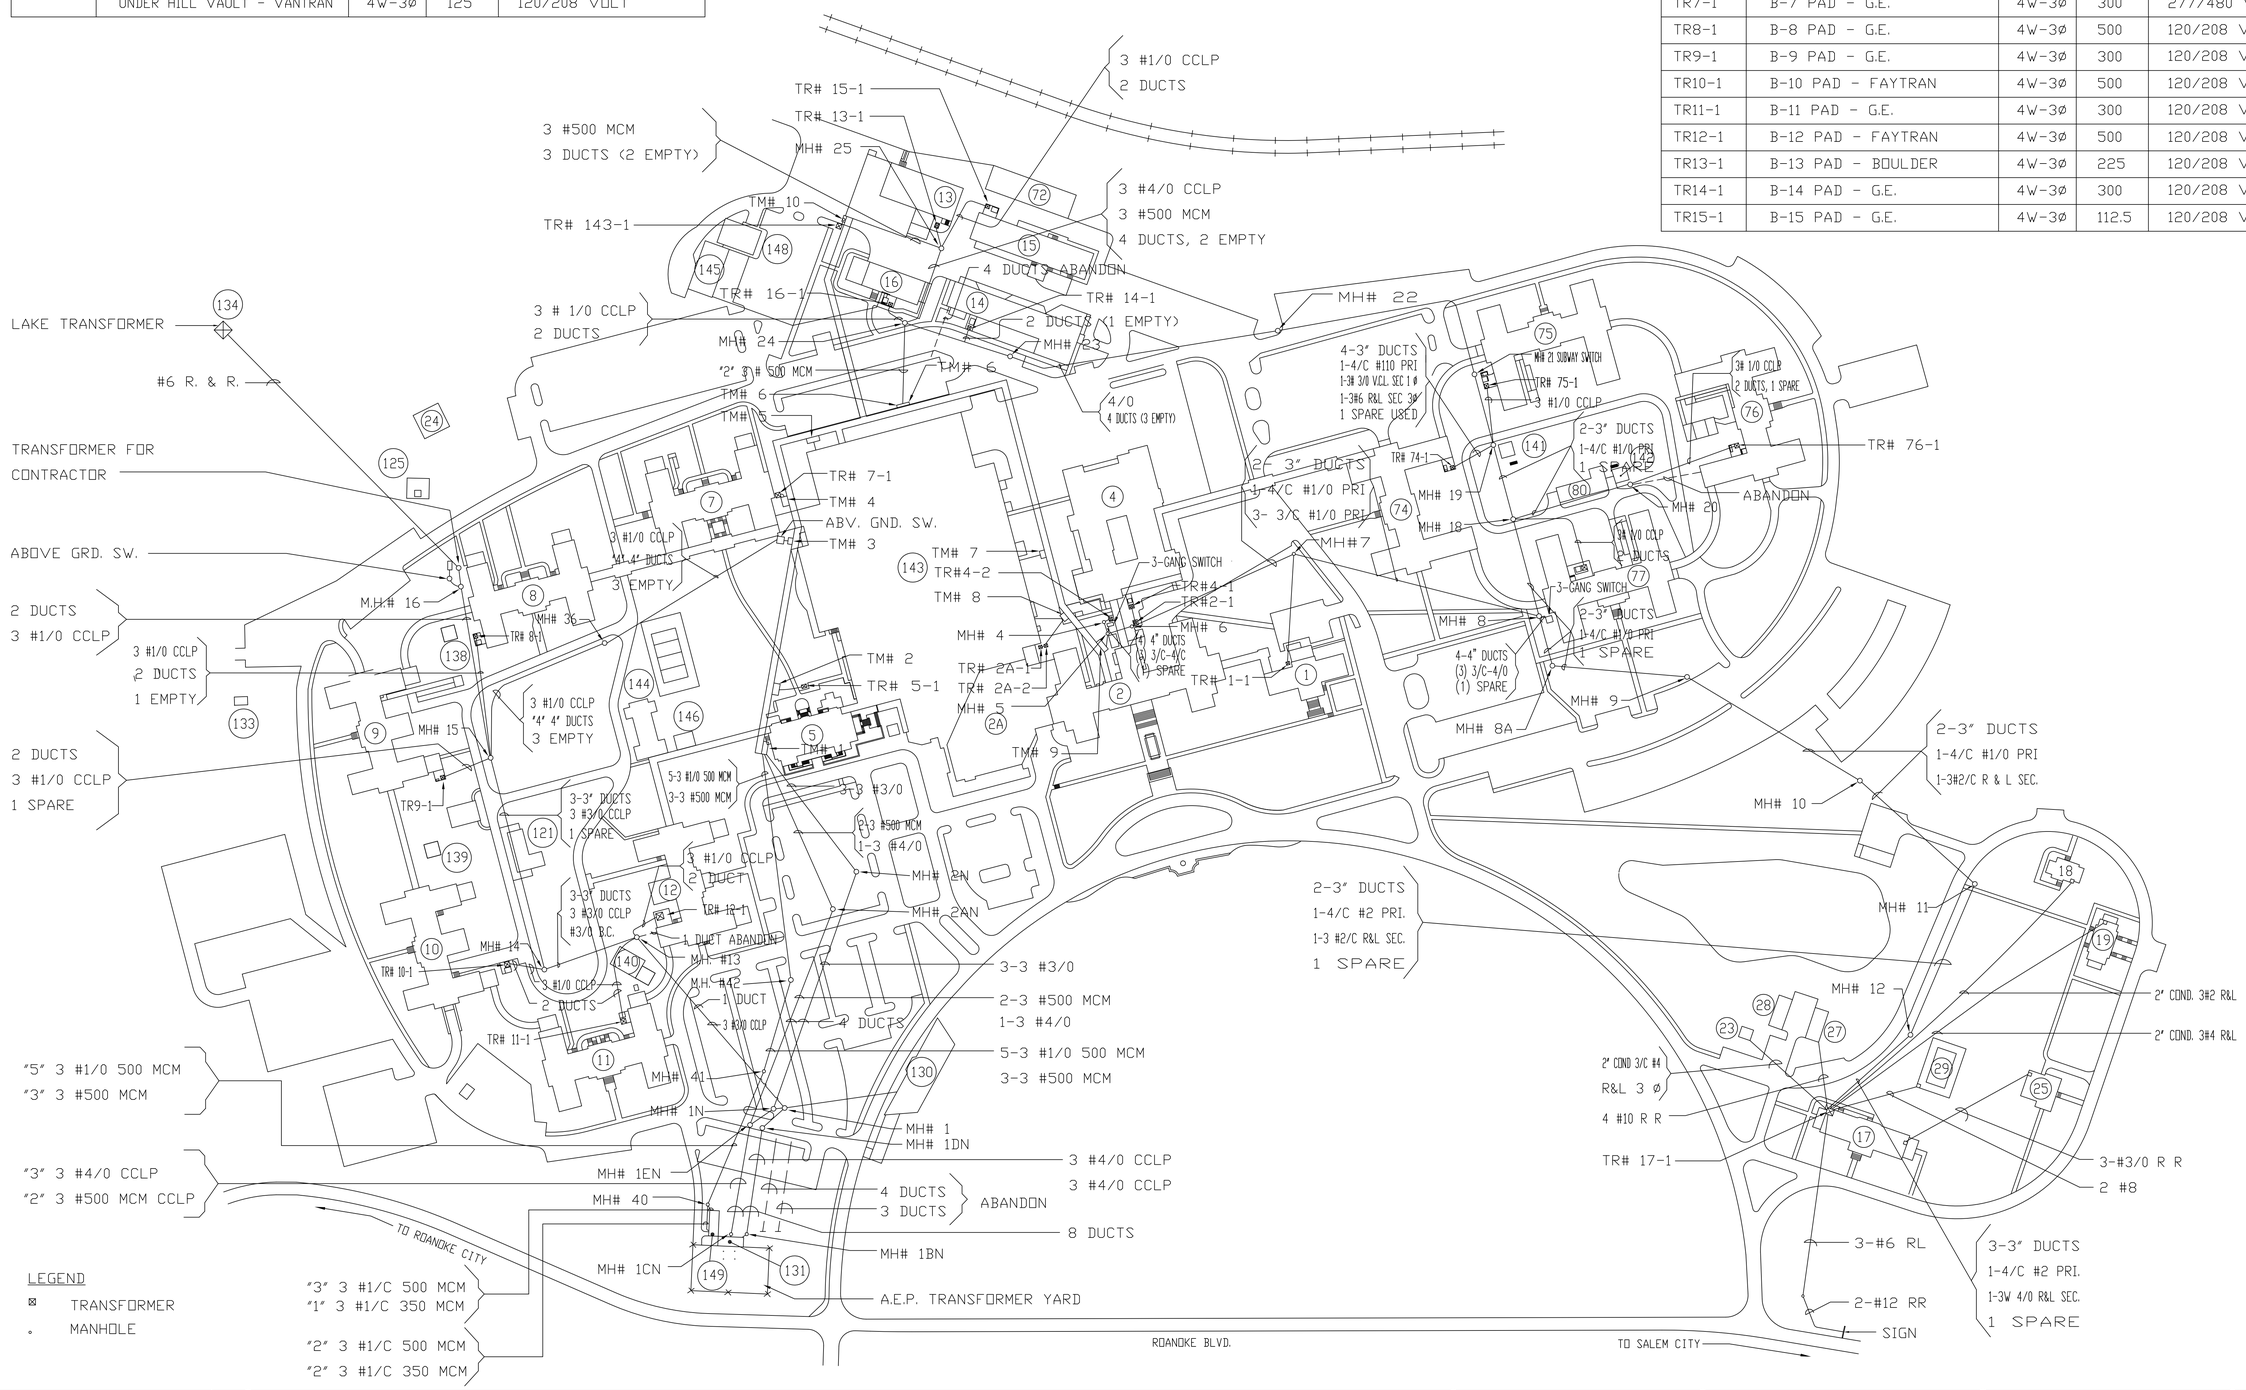

Revisions	Date
4 CHANGED VOLTAGE ON TR2-1 & TR7-1 J.B.	9-25-00
3 M.H. #1, 1DN, 8A, 16 & TM #3	8-16-00
2 ELEC. SHOP FOREMAN CHANGES	6-5-00
1 (2) 3-GANG SWITCHES & M.H. 8A J.B.	4-4-00

SCALE: 1"=100'

Approved: Associate Director

Approved: Chief of Engineering

Approved: Medical Center Director

Drawing Title: PRIMARY DISTRIBUTION PLAN (4.16KV)

Project Title

Building Number: N/A | Checked: J.R. | Drawn: J.B.

Location: VA MEDICAL CENTER, SALEM, VA 24153

Date: 11-17-98

Project No.

DRAWING NO. Dwg. 1 Of 1

Veterans Administration