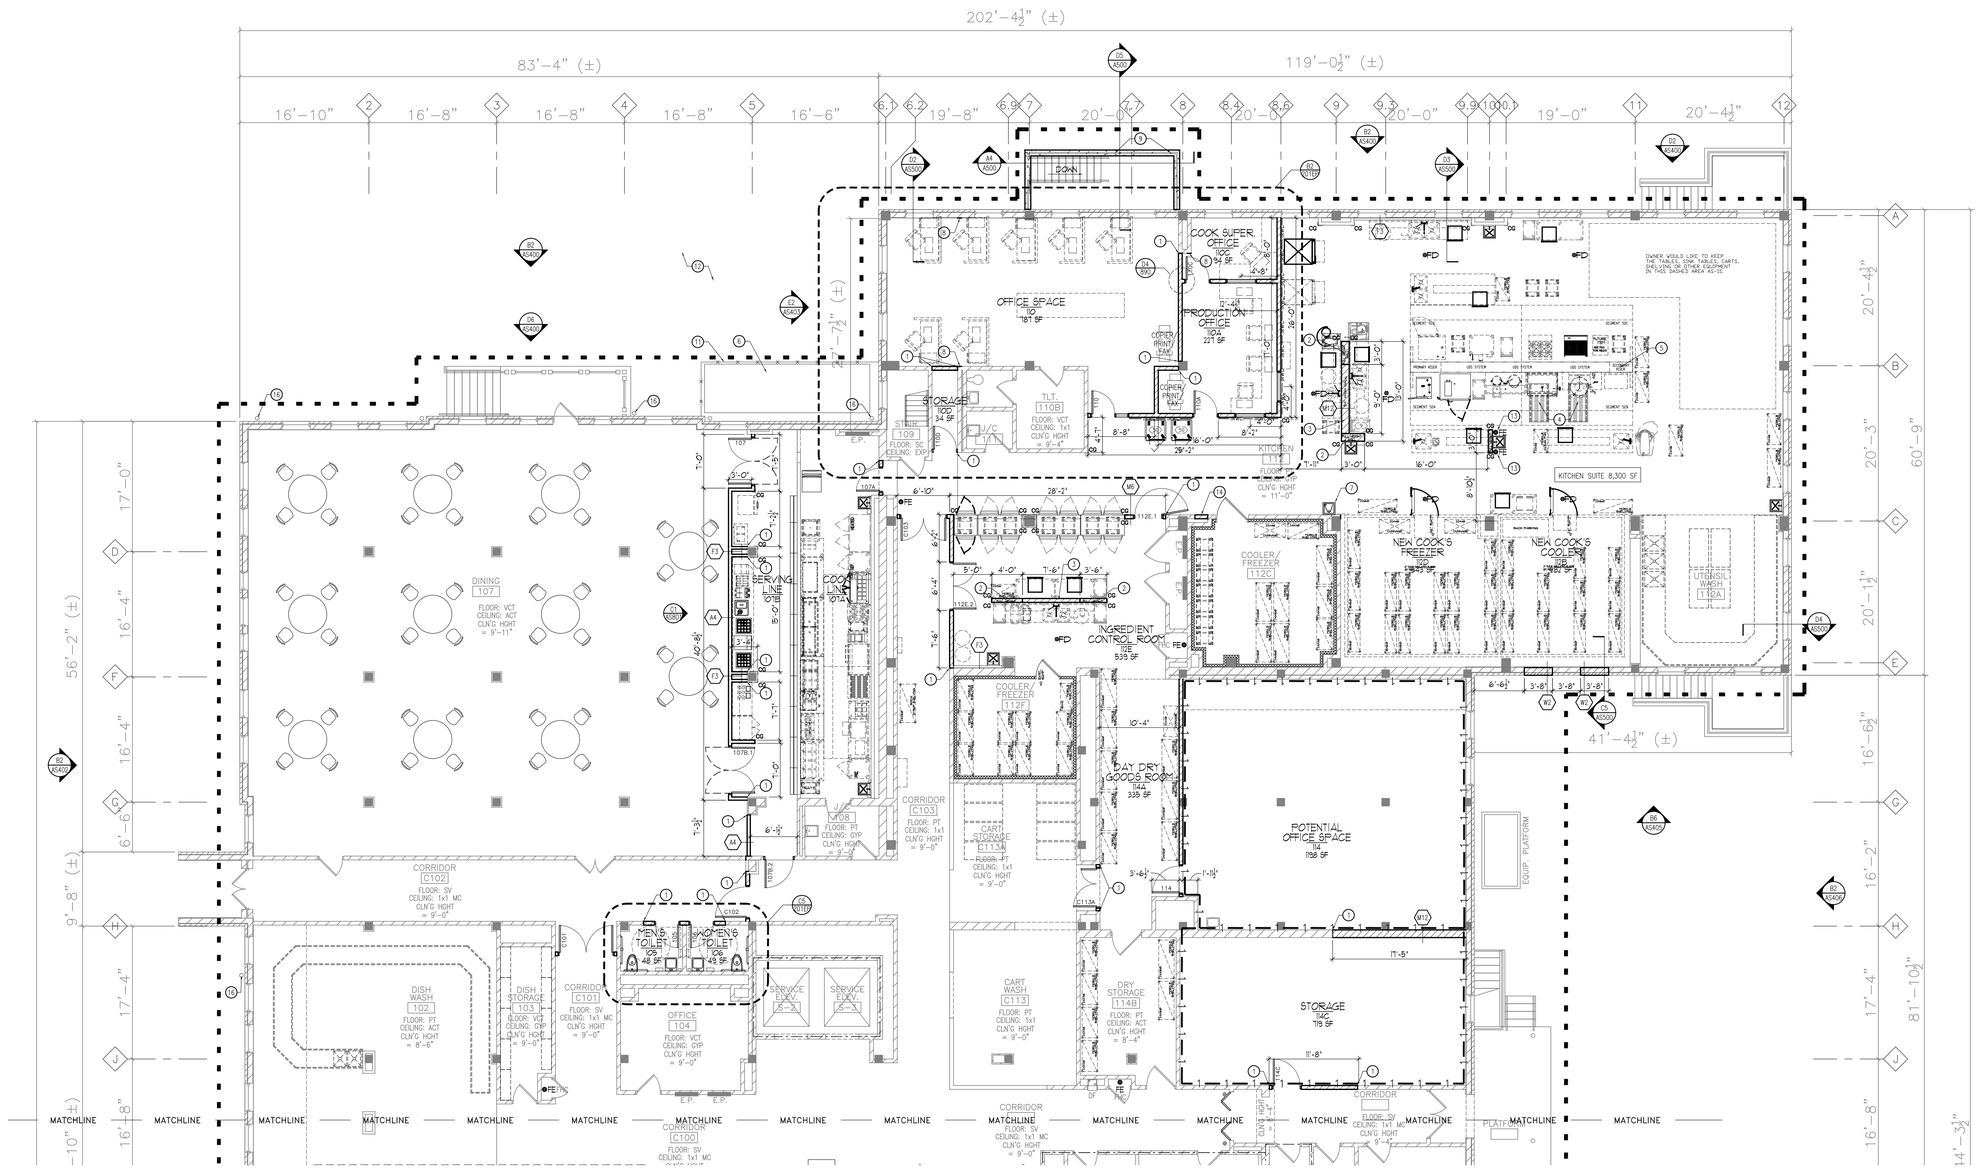

FLOOR PLAN - SYMBOLS LEGEND

NEW WALL / PARTITION	EXISTING WALLS TO REMAIN
NEW DOOR AND FRAME	EXISTING DOOR AND FRAME TO REMAIN
SECTION REFERENCE	DETAIL REFERENCE
INTERIOR ELEVATION	BORROWED LITE, REFER TO DETAILS ON SHEET A5-890
KEYNOTE / WALL TYPE / PARTITION TYPE	PLAN NOTE
CONSTRUCTION LIMITS - ARCHITECTURAL	CORNER GUARD (REFER TO DETAIL C3/A5-900)
ONE HOUR FIRE RESISTIVE CONSTRUCTION	FIRE EXTINGUISHER

FLOOR PLAN - GENERAL NOTES

A. DIMENSIONS ON FLOOR PLAN ARE BASED ON FACE OF FINISHED WALL TO FACE OF FINISHED WALL (NOMINAL).

B. VERIFY ALL DIMENSIONS AND CONDITIONS AT JOB SITE. PORTIONS OF EXISTING CONSTRUCTION MAY HAVE BEEN REMOVED BY FHCC.

C. MAINTAIN CONTINUOUS UTILITY SERVICE TO ALL SPACES IN THE BUILDING NOT AFFECTED BY THIS WORK. COORDINATE WITH FHCC ANY DISRUPTION IN SERVICES REQUIRED TO PERFORM WORK OR TO MODIFY EXISTING PIPING, DUCTWORK OR ANY ASSOCIATED EQUIPMENT.

D. REFER TO PROJECT MANUAL FOR ROOM FINISH SCHEDULE AND NOTES.

E. REFER TO SHEET B90 FOR DOOR SCHEDULES, DOOR TYPES, AND NOTES.

FLOOR PLAN NOTES

1. ALIGN
2. PORTION OF WALL TO BE FULL HEIGHT.
3. PARTIAL HEIGHT WALL. REFER TO DETAIL B6/A5-900.
4. RECESSED FLOOR SLAB IN THESE AREAS.
5. UDC WALL SYSTEM. REFER TO FOOD SERVICE DRAWINGS.
6. NEW CONCRETE SLAB. REFER TO DETAIL D3/A6-00.
7. NEW DRINKING FOUNTAIN. REFER TO ELEVATION A6/A5801.
8. PATCH WALL TO MATCH EXISTING.
9. REMOVABLE SECTION OF RAILING. REFER TO DETAIL B6/6-00.
10. PROVIDE 3 ½" HIGH CONCRETE HOUSEKEEPING PADS UNDER EQUIPMENT.
11. NEW CHAIN LINK FENCE.
12. NEW GRASS SEED IN THIS AREA.
13. EXISTING RELOCATED FIRE EXTINGUISHER.
14. PATCH WALL TO MATCH EXISTING.
15. PROVIDE AND INSTALL ¾" PLYWOOD ON ALL WALLS OF FROM FLOOR TO 96" A.F.F. PLYWOOD TO BE PAINTED ON ALL 6 SIDES WITH (2) COATS OF FIRE RETARDANT PAINT.
16. DOWNSPOUT AND SPLASHBLOCK.
17. NEW MECHANICAL LOUVER. REFER TO DETAILS C1 AND D1/A5-600

GYPSUM BOARD PARTITION SCHEDULE

INTERIOR STEEL STUD PARTITION

(M4) 3⅝" STEEL STUDS @ 16" OC WITH 3" SOUND ATTENUATION INSULATION AND ONE LAYER ⅝" GYPSUM BOARD @ EACH FACE. PROVIDE 1 HR RATED UL #U465 DESIGN WHERE 1 HR CONSTRUCTION IS INDICATED ON PLANS.

INTERIOR FURRING PARTITION

(F3) 2½" STEEL STUDS @ 16" OC WITH ONE LAYER ⅝" GYPSUM BOARD. (REFER TO DETAIL C5/A5900)

(F4) 3⅝" STEEL STUDS @ 16" OC WITH ONE LAYER ⅝" GYPSUM BOARD.

GYPSUM BOARD PARTITION GENERAL NOTES

ALL GYPSUM BOARD PARTITIONS SHALL BE (M4) UNLESS OTHERWISE NOTED ON FLOOR PLAN.

GYPSUM BOARD PARTITION DIMENSIONS ON FLOOR PLAN ARE BASED ON FACE OF FINISHED PARTITION TO FACE OF FINISHED PARTITION (NOMINAL).

REFER TO GYPSUM BOARD SPECIFICATION FOR LOCATIONS & TYPE(S) OF GYPSUM BOARD MATERIAL REQUIRED.

PROVIDE TYPE "X" FIRE RATED GYPSUM BOARD AT ALL FIRE RATED PARTITIONS.

SEAL ALL WALL PENETRATIONS AT PERIMETER AND FIRESTOP ALL FIRE RATED PARTITIONS.

EXTEND ALL GYPSUM BOARD PARTITIONS FULL HEIGHT TO UNDERSIDE OF STEEL DECK ABOVE. AT METAL DECK CONSTRUCTION ABOVE PROVIDE SLIP JOINT BETWEEN TOP OF PARTITION AND UNDERSIDE OF METAL DECK / STRUCTURAL STEEL MEMBER ABOVE. REFER TO DETAIL C6/A5900.

MASONRY PARTITION SCHEDULE

INTERIOR MASONRY PARTITION

(M6) 6" CONCRETE BLOCK.

(M12) 12" CONCRETE BLOCK.

MASONRY PARTITION GENERAL NOTES

MASONRY PARTITIONS INDICATED WITH THE FOLLOWING HATCH PATTERN:

ALL MASONRY PARTITIONS SHALL BE 6" CONCRETE BLOCK UNLESS OTHERWISE NOTED OR DIMENSIONED. REFER TO FLOOR PLAN FOR PARTITION THICKNESSES.

PROVIDE UL FIRE RATED CONCRETE BLOCK AT ALL FIRE RATED PARTITIONS.

SEAL ALL WALL PENETRATIONS AT PERIMETER AND FIRESTOP ALL RATED PARTITIONS.

EXTEND CONCRETE BLOCK PARTITIONS FULL HEIGHT TO UNDERSIDE OF STEEL DECK ABOVE (OR PRECAST PLANK ABOVE IF APPLICABLE). REFER TO DETAIL C4/A5-900. PROVIDE HORIZONTAL MASONRY JOINT REINFORCEMENT AT 16" OC VERTICALLY. REFER TO STRUCTURAL DRAWINGS FOR VERTICAL REINFORCEMENT REQUIREMENTS.

KEYPLAN

GRAPHIC SCALE 0 4' 8' 16'

PARTIAL FIRST FLOOR PLAN - NORTH
FINISHED FLOOR = 100'-0" 1/8"=1'-0"

FINAL BID DOCUMENTS

Revisions:	Date
FINAL BID DOCUMENTS	06-26-12
90% CONSTRUCTION DOCUMENTS SUBMISSION	05-17-12
50% CONSTRUCTION DOCUMENTS SUBMISSION	04-06-12
35% DOCUMENTS SUBMISSION	02-22-12
SCHEMATIC DESIGN SUBMISSION	11-21-11

Federal Health Care Center
U.S. Department of Veterans Affairs | U.S. Department of Defense

Captain James A. Lovell
Federal Health Care Center
3001 Green Bay Road
North Chicago, IL, 60064

CONSULTANTS:
ARNOLD & O'SHERIDAN Consulting Engineers
CHEQUAMEGON BAY ENGINEERING, INC.
MACKESEY AND ASSOCIATES, LLC

PROJECT LEADER:
Plunkett Raysich Architects LLP
11000 West Park Place • Milwaukee WI 53224 • Tel 414 359-3060 • Fax 414 359-3070
Intelligent Designs Inspired Results
www.prarch.com
PRA Job No. 110172-01

Drawing Title: Partial First Floor Plan - North	Project Title: AE SCIP for Building 6 FHCC		Project Number: 556-11-119
			Building Number: 6
Approved: Project Director	Location: North Chicago, IL		Drawing Number: AS-201N
	Date: June 26, 2012	Checked By: PRA	Drawn By: RLS

Office of Facilities Management
Department of Veterans Affairs

VA FORM 08-6231, OCT 1978