



AD SQ
LEV= 468.44
CONC IE= 466.50
PVC IE= 464.34
PVC IE= 464.29
= 463.39

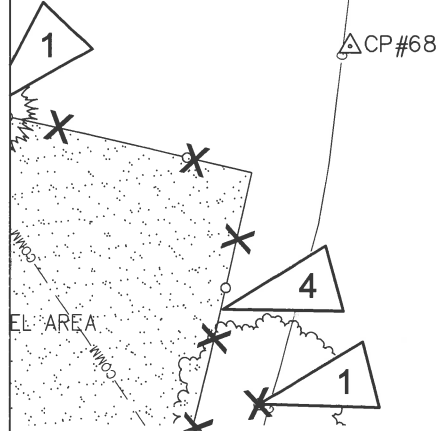

**BALZHISER
& HUBBARD
ENGINEERS**

MECHANICAL
•
ELECTRICAL
•
CIVIL
SURVEYORS

100 WEST 13TH AVENUE
EUGENE, OR 97401
P: 541-686-8478
F: 541-345-5303

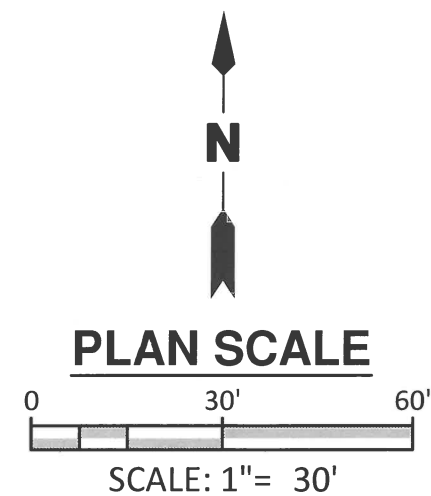

CONSTRUCTION NOTES

13. REMOVE EX IRRIGATION CONTROLLER AND DELIVER TO VA AS SPARE PARTS.
14. APPROXIMATE LOCATION OF EX 2"IRR TO BE ABANDONED IN PLACE. CUT AND CAP AT RELOCATION POINT. REFER TO LANDSCAPE DRAWINGS FOR RELOCATED IRR. LOCATION OF EX 2"IRR PROVIDED BY THE VA IN A SKETCH DATED 8/13/12.
15. APPROXIMATE LOCATION OF EX 2"IRR TO BE RELOCATED. REFER TO LANDSCAPE DRAWINGS FOR RELOCATED IRR. LOCATION OF EX 2"IRR PROVIDED BY THE VA IN A SKETCH DATED 8/13/12.



Tina Fly architect
2915 Wingate Street / Eugene, OR 97408
541-521-2477 / TinaFly@comcast.net



VA Project Number

653-322

**SEISMIC REPLACEMENT BLDG 2
PHASE 1 MINOR
ACUTE PSYCHIATRIC WARD, B86
ROSEBURG, OREGON**

Revision Title

Addendum 2

Revision Date

16 AUG 12

Drawing Reference

GD-100

Sketch Number

SK-C03