


GRAND ISLAND VAMC  
2201 NORTH BROADWELL AVENUE  
GRAND ISLAND, NEBRASKA 68803

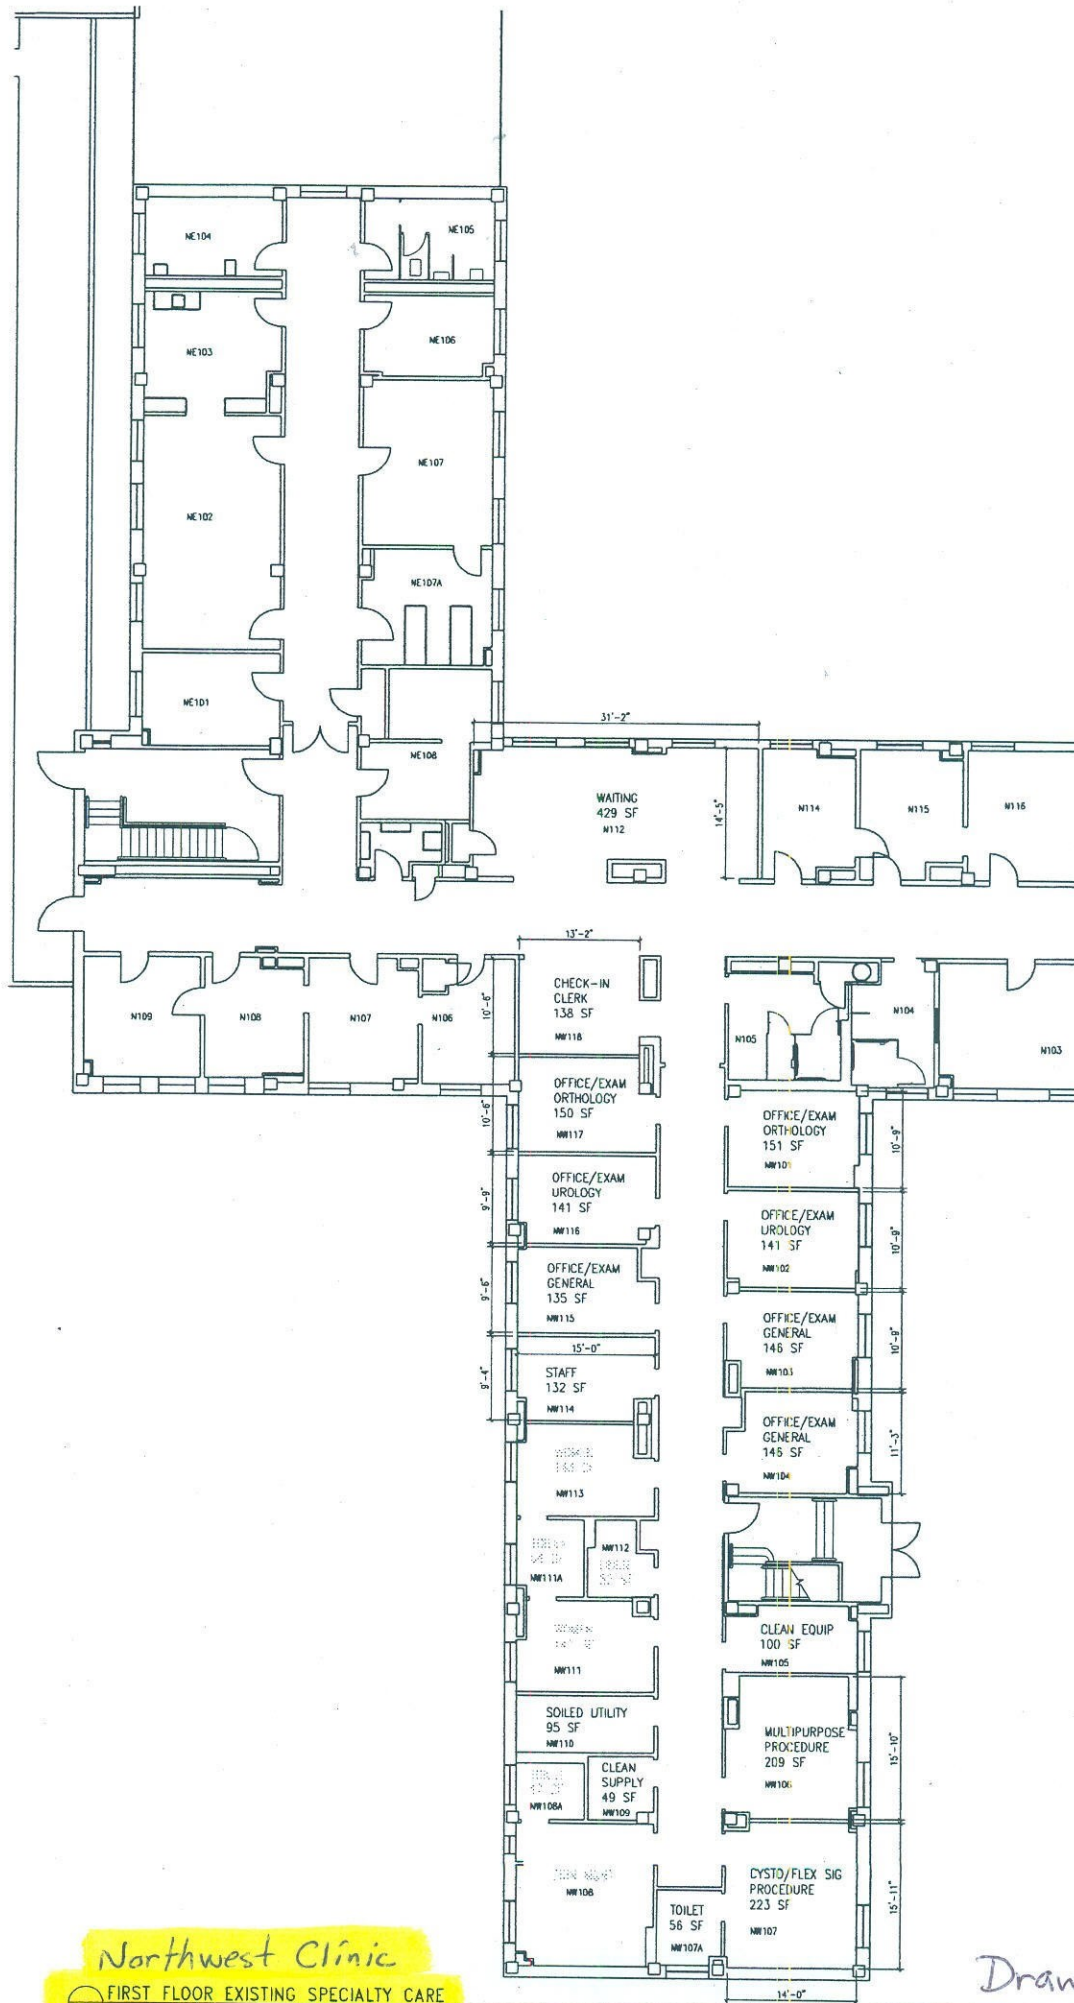

Drawing #1






**Project Scope:** Work located in Northwest corridor on 1<sup>st</sup> floor of Building 1. Rooms to receive new flooring are NW106, NW107, NW107A (Bathroom off of NW107), NW108, NW108A (Bathroom off of NW108), NW111, NW111A (Bathroom shared between NW111 & NW113), and NW113. Work includes removal and disposal of existing floor covering, preparation and leveling of concrete floor under, and installation of new wood sheet vinyl, Manufacturer LG, Naturelife, color NLA5306 Brazilian Cherry [REDACTED]

[REDACTED] Vinyl seams to be heat welded. Vinyl coved 6" up the wall with metal cap and inside corners welded. Contractor will provide and install a new transition where new vinyl meets existing vinyl composition tile in the adjoining corridor. Contractor is responsible to remove and replace all room furnishing as necessary to complete the flooring replacement.

[REDACTED]

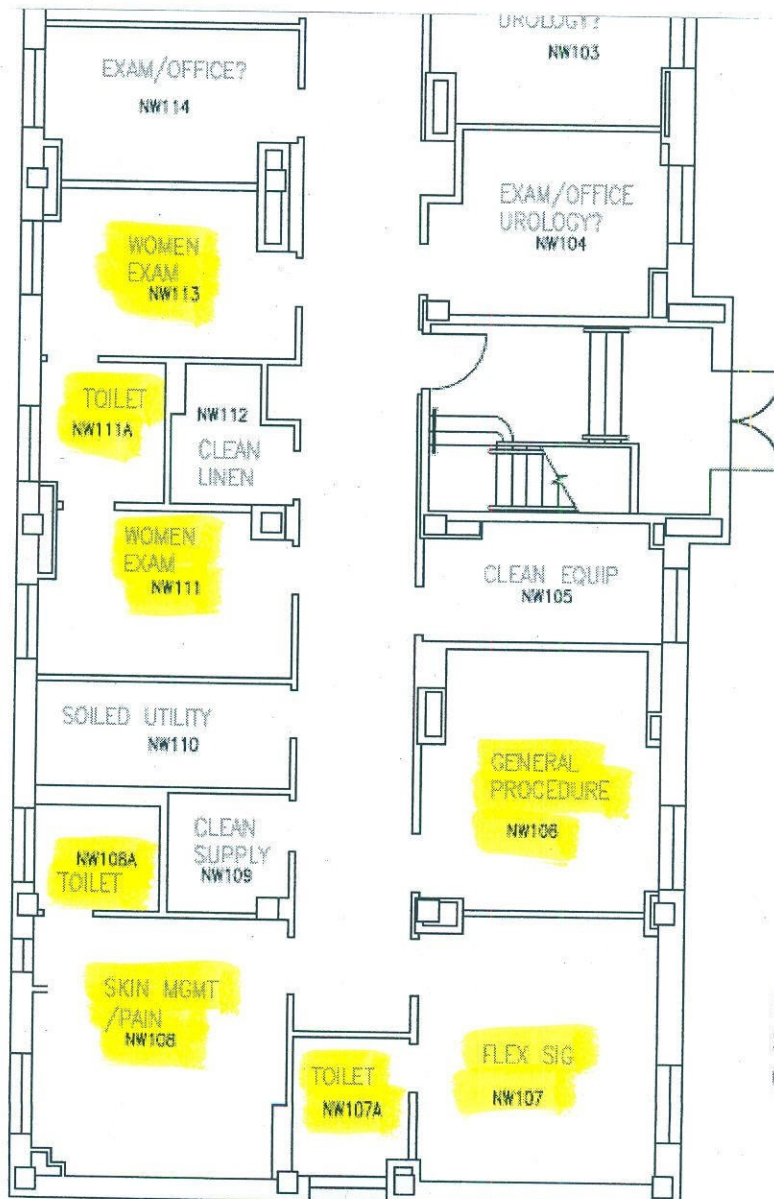

EXISTING FIRST FLOOR  
SPECIALTY CARE  
01/17/2012

Drawing #3