

EOCS-BALTIMORE VAMC - LARGE (HOLE) OPENING REPORT

30432 Baltimore VAMC OTF / Baltimore VAMC / 00.0 Basement

Date Created	Created By	EOCS ID #	Full Plan View	Room Number	Item	Type	Wall Material	Fire Rating	Comments	Width (ft.)	Height (ft.)	Sides	Status
9/5/17	DP	463890	30432 Baltimore VAMC OTF / Baltimore VAMC / 00.0 Basement	BA105D	Large Opening	Sections of walls missing	Gypsum	1 Hour	wall does not continue above ceiling tiles 15'x60'x2	60	15	2	Open
9/5/17	SO	463869	30432 Baltimore VAMC OTF / Baltimore VAMC / 00.0 Basement	Nutrition	Large Opening	Sections of walls missing	Gypsum	1 Hour Fire Smoke Barrier	Wall Needs Built to Deck. 12ft. by 16ft.	16	12	1	Open
9/6/17	DP	465164	30432 Baltimore VAMC OTF / Baltimore VAMC / 00.0 Basement	BB100A	Large Opening	Sections of walls missing	Concrete	1 Hour	Section of wall missing roughly 3'x1'	1	3	1	Open
9/16/17	KA	470402	30432 Baltimore VAMC OTF / Baltimore VAMC / 00.0 Basement	BB137	Large Opening	Sections of walls missing	Gypsum	1 Hour	Section of wall missing that is 24"x24".	2	2	1	Open

Item Count: 4

30432 Baltimore VAMC OTF / Baltimore VAMC / 1.0 1st Floor

Date Created	Created By	EOCS ID #	Full Plan View	Room Number	Item	Type	Wall Material	Fire Rating	Comments	Width (ft.)	Height (ft.)	Sides	Status
8/10/17	DP	451006	30432 Baltimore VAMC OTF / Baltimore VAMC / 1.0 1st Floor	Soiled Utility	Large Opening	Sections of walls missing	Gypsum	2 Hour Fire Smoke Barrier	12"x12"	1	1	1	Open
9/8/17	SO	465910	30432 Baltimore VAMC OTF / Baltimore VAMC / 1.0 1st Floor	Double Doors	Large Opening	Sections of walls missing	Gypsum	1 Hour Fire Smoke Barrier	Wall Needs Built to Deck. 3ft by 9ft.	9	3	1	Open
9/8/17	DP	466087	30432 Baltimore VAMC OTF / Baltimore VAMC / 1.0 1st Floor	1B-125	Large Opening	Sections of walls missing	Gypsum	1 Hour Fire Smoke Barrier	2 large penetrations 1)roughly 12"x12" 2)roughly 24"x18"	3	3	1	Open
9/16/17	KA	470448	30432 Baltimore VAMC OTF / Baltimore VAMC / 1.0 1st Floor	1B-166	Large Opening	Sections of walls missing	Gypsum	1 Hour	Firewall is not built to deck. Dimensions are 9'x3'.	9	3	1	Open

Item Count: 4

30432 Baltimore VAMC OTF / Baltimore VAMC / 2.0 2nd Floor

Date Created	Created By	EOCS ID #	Full Plan View	Room Number	Item	Type	Wall Material	Fire Rating	Comments	Width (ft.)	Height (ft.)	Sides	Status
8/20/17	JF	455953	30432 Baltimore VAMC OTF / Baltimore VAMC / 2.0 2nd Floor	2B-118C	Large Opening	Sections of walls missing	Concrete	1 Hour Fire Smoke Barrier	Section of wall missing. 8"x14'	14	1	1	Open
9/4/17	DP	463004	30432 Baltimore VAMC OTF / Baltimore VAMC / 2.0 2nd Floor	2B-111	Large Opening	Sections of walls missing	Gypsum	1 Hour	large opening roughly 6"x48"	4	1	1	Open
9/12/17	KA	467524	30432 Baltimore VAMC OTF / Baltimore VAMC / 2.0 2nd Floor	Kitchen	Large Opening	Sections of walls missing	Gypsum	1 Hour Fire Smoke Barrier	Section of wall missing 12" high and 13" wide	1	1	1	Open

Item Count: 3

30432 Baltimore VAMC OTF / Baltimore VAMC / 3.0 3rd Floor

Date Created	Created By	EOCS ID #	Full Plan View	Room Number	Item	Type	Wall Material	Fire Rating	Comments	Width (ft.)	Height (ft.)	Sides	Status
9/5/17	SO	463536	30432 Baltimore VAMC OTF / Baltimore VAMC / 3.0 3rd Floor	Outside 3A 129	Large Opening	Through Penetrations	Gypsum	1 Hour Fire Smoke Barrier	Section of Wall Missing With Metallic Pipe Penetrating Through. 2ft by 2ft.	2	2	1	Pending Final

EOC Solutions, LLC

117 Apple Brook Way

Manchester, NH 03109

Item Count: 1

30432 Baltimore VAMC OTF / Baltimore VAMC / 4.0 4th Floor

Date Created	Created By	EOCS ID #	Full Plan View	Room Number	Item	Type	Wall Material	Fire Rating	Comments	Width (ft.)	Height (ft.)	Sides	Status
8/20/17	DP	455799	30432 Baltimore VAMC OTF / Baltimore VAMC / 4.0 4th Floor	4B-182	Large Opening	Sections of walls missing	Gypsum	1 Hour Fire Smoke Barrier	12"x14" large opening	1	1	1	Open
8/20/17	DP	455836	30432 Baltimore VAMC OTF / Baltimore VAMC / 4.0 4th Floor	4A-133C	Large Opening	Sections of walls missing	Concrete	1 Hour Fire Smoke Barrier	12"x12"	1	1	1	Open
8/21/17	DP	456977	30432 Baltimore VAMC OTF / Baltimore VAMC / 4.0 4th Floor	Elevator	Large Opening	Sections of walls missing	Gypsum	1 Hour Fire Smoke Barrier	8X18 large opening	2	1	1	Open
8/21/17	JF	456735	30432 Baltimore VAMC OTF / Baltimore VAMC / 4.0 4th Floor	Double Doors	Large Opening	z-other	Gypsum	1 Hour Fire Smoke Barrier	Scab Patch. 14"x16"	1	2	1	Open
8/21/17	DP	456986	30432 Baltimore VAMC OTF / Baltimore VAMC / 4.0 4th Floor	Double doors	Large Opening	z-other	Gypsum	2 Hour Fire Smoke Barrier	12X12	1	1	1	Open
9/1/17	JF	462288	30432 Baltimore VAMC OTF / Baltimore VAMC / 4.0 4th Floor	4A-102	Large Opening	Through Penetrations	Gypsum	1 Hour Fire Smoke Barrier	Section of wall missing 8"x20" with metallic pipe penetration	2	1	1	Open

Item Count: 6

30432 Baltimore VAMC OTF / Baltimore VAMC / 6th Floor 2017.8

Date Created	Created By	EOCS ID #	Full Plan View	Room Number	Item	Type	Wall Material	Fire Rating	Comments	Width (ft.)	Height (ft.)	Sides	Status
8/1/17	DP	446740	30432 Baltimore VAMC OTF / Baltimore VAMC / 6th Floor 2017.8	6D-158	Large Opening	Large wall with penetrations	Concrete	1 Hour Fire Smoke Barrier	large opening in floor, roughly 48X42.	4	4	1	Open
8/2/17	DP	447769	30432 Baltimore VAMC OTF / Baltimore VAMC / 6th Floor 2017.8	6C-49	Large Opening	Sections of walls missing	Gypsum	1 Hour Fire Smoke Barrier	Section of wall missing roughly 6'X1'	6	1	1	Open
8/2/17	DP	447775	30432 Baltimore VAMC OTF / Baltimore VAMC / 6th Floor 2017.8	Over double Doors	Large Opening	Sections of walls missing	Gypsum	1 Hour	Large section of wall missing over double Doors, roughly 6'X1'	6	1	1	Open
8/3/17	KC	448349	30432 Baltimore VAMC OTF / Baltimore VAMC / 6th Floor 2017.8	6B-129	Large Opening	Large wall with penetrations	Gypsum	1 Hour Fire Smoke Barrier	1.5x1.5' opening under duct.	2	2	2	Open
8/4/17	JF	448948	30432 Baltimore VAMC OTF / Baltimore VAMC / 6th Floor 2017.8	Across 6A-156	Large Opening	Sections of walls missing	Gypsum	1 Hour Fire Smoke Barrier	12"x12" Section of wall missing with penetration	1	1	1	Open

Item Count: 5

30432 Baltimore VAMC OTF / Baltimore VAMC / 7.0 7th Floor

Date Created	Created By	EOCS ID #	Full Plan View	Room Number	Item	Type	Wall Material	Fire Rating	Comments	Width (ft.)	Height (ft.)	Sides	Status
9/7/17	SO	465109	30432 Baltimore VAMC OTF / Baltimore VAMC / 7.0 7th Floor	7D 102	Large Opening	Sections of walls missing	Gypsum	1 Hour Fire Smoke Barrier	Wall Needs Built to Deck. 3ft by 100ft.	100	3	1	Open

Item Count: 1

EOC Solutions, LLC

117 Apple Brook Way

Manchester, NH 03109

EOCS-BALTIMORE VAMC - LARGE (HOLE) OPENING REPORT







30432 Baltimore VAMC OTF / Baltimore VAMC / 00.0 Basement



EOC Solutions, LLC

117 Apple Brook Way

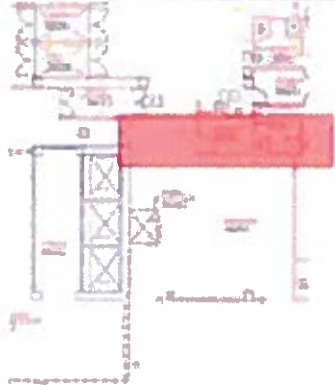Manchester, NH 03109

Date Created	Created By	EOCS ID #	Full Plan View	Room Number	Item	Type	Wall Material	Fire Rating	Comments	Width (ft.)	Height (ft.)	Sides	Status
9/5/17	DP	463890	30432 Baltimore VAMC OTF / Baltimore VAMC / 00.0 Basement	BA105D	Large Opening	Sections of walls missing	Gypsum	1 Hour	wall does not continue above ceiling tiles 15'x60'x2	60	15	2	Open
<div>    </div> <div> <div>9/5/17 04:52 PM</div> <div>9/5/17 04:52 PM</div> <div>9/5/17 04:53 PM</div> </div>													
9/5/17	SO	463869	30432 Baltimore VAMC OTF / Baltimore VAMC / 00.0 Basement	Nutrition	Large Opening	Sections of walls missing	Gypsum	1 Hour Fire Smoke Barrier	Wall Needs Built to Deck. 12ft. by 16ft.	16	12	1	Open
<div>   </div> <div> <div>9/5/17 04:52 PM</div> <div>9/5/17 04:53 PM</div> </div>													
9/6/17	DP	465164	30432 Baltimore VAMC OTF / Baltimore VAMC / 00.0 Basement	BB100A	Large Opening	Sections of walls missing	Concrete	1 Hour	Section of wall missing roughly 3'x1'	1	3	1	Open
<div>  </div> <div> <div>9/6/17 11:01 AM</div> </div>													
9/16/17	KA	470402	30432 Baltimore VAMC OTF / Baltimore VAMC / 00.0 Basement	BB137	Large Opening	Sections of walls missing	Gypsum	1 Hour	Section of wall missing that is 24"x24".	2	2	1	Open

EOC Solutions, LLC

117 Apple Brook Way

Manchester, NH 03109

Date Created	Created By	EOCS ID #	Full Plan View	Room Number	Item	Type	Wall Material	Fire Rating	Comments	Width (ft.)	Height (ft.)	Sides	Status
													
													
			9/16/17 10:46 AM										
			9/16/17 10:47 AM										

Item Count: 4





EOC Solutions, LLC

117 Apple Brook Way

Manchester, NH 03109

30432 Baltimore VAMC OTF / Baltimore VAMC / 1.0 1st Floor






Date Created	Created By	EOCS ID #	Full Plan View	Room Number	Item	Type	Wall Material	Fire Rating	Comments	Width (ft.)	Height (ft.)	Sides	Status
8/10/17	DP	451006	30432 Baltimore VAMC OTF / Baltimore VAMC / 1.0 1st Floor	Soiled Utility	Large Opening	Sections of walls missing	Gypsum	2 Hour Fire Smoke Barrier	12"x12"	1	1	1	Open
 8/10/17 11:19 AM													
9/8/17	SO	465910	30432 Baltimore VAMC OTF / Baltimore VAMC / 1.0 1st Floor	Double Doors	Large Opening	Sections of walls missing	Gypsum	1 Hour Fire Smoke Barrier	Wall Needs Built to Deck. 3ft by 9ft.	9	3	1	Open
 9/8/17 10:37 AM  9/8/17 10:37 AM													
9/8/17	DP	466087	30432 Baltimore VAMC OTF / Baltimore VAMC / 1.0 1st Floor	1B-125	Large Opening	Sections of walls missing	Gypsum	1 Hour Fire Smoke Barrier	2 large penetrations 1)roughly 12"x12" 2)roughly 24"x18"	3	3	1	Open
 9/8/17 12:54 PM													
9/16/17	KA	470448	30432 Baltimore VAMC OTF / Baltimore VAMC / 1.0 1st Floor	1B-166	Large Opening	Sections of walls missing	Gypsum	1 Hour	Firewall is not built to deck. Dimensions are 9'x3'.	9	3	1	Open

EOC Solutions, LLC

117 Apple Brook Way

Manchester, NH 03109

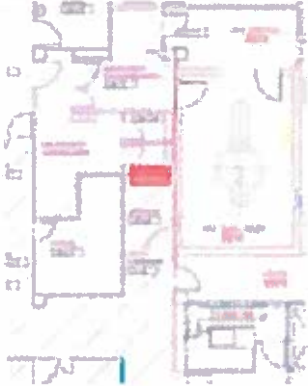Date Created	Created By	EOCS ID #	Full Plan View	Room Number	Item	Type	Wall Material	Fire Rating	Comments	Width (ft.)	Height (ft.)	Sides	Status
													
													
													
			9/16/17 02:54 PM						9/16/17 02:54 PM				
									9/16/17 02:55 PM				

Item Count: 4






30432 Baltimore VAMC OTF / Baltimore VAMC / 2.0 2nd Floor



EOC Solutions, LLC

117 Apple Brook Way

Manchester, NH 03109

Date Created	Created By	EOCS ID #	Full Plan View	Room Number	Item	Type	Wall Material	Fire Rating	Comments	Width (ft.)	Height (ft.)	Sides	Status
8/20/17	JF	455953	30432 Baltimore VAMC OTF / Baltimore VAMC / 2.0 2nd Floor	2B-118C	Large Opening	Sections of walls missing	Concrete	1 Hour Fire Smoke Barrier	Section of wall missing. 8"x14'	14	1	1	Open
													
		8/20/17 02:58 PM		8/20/17 02:58 PM									
9/4/17	DP	463004	30432 Baltimore VAMC OTF / Baltimore VAMC / 2.0 2nd Floor	2B-111	Large Opening	Sections of walls missing	Gypsum	1 Hour	large opening roughly 6"x48"	4	1	1	Open
													
		9/4/17 01:36 PM											
9/12/17	KA	467524	30432 Baltimore VAMC OTF / Baltimore VAMC / 2.0 2nd Floor	Kitchen	Large Opening	Sections of walls missing	Gypsum	1 Hour Fire Smoke Barrier	Section of wall missing 12" high and 13" wide	1	1	1	Open
													
		9/12/17 03:36 PM		9/12/17 03:36 PM									



Item Count: 3

EOC Solutions, LLC


117 Apple Brook Way

Manchester, NH 03109



Date Created	Created By	EOCS ID #	Full Plan View	Room Number	Item	Type	Wall Material	Fire Rating	Comments	Width (ft.)	Height (ft.)	Sides	Status
9/5/17	SO	463536	30432 Baltimore VAMC OTF / Baltimore VAMC / 3.0 3rd Floor	Outside 3A 129	Large Opening	Through Penetrations	Gypsum	1 Hour Fire Smoke Barrier	Section of Wall Missing With Metallic Pipe Penetrating Through. 2ft by 2ft.	2	2	1	Pending Final
<div>   </div> <div> <div>9/5/17 10:31 AM</div> <div>9/5/17 10:31 AM</div> </div>													

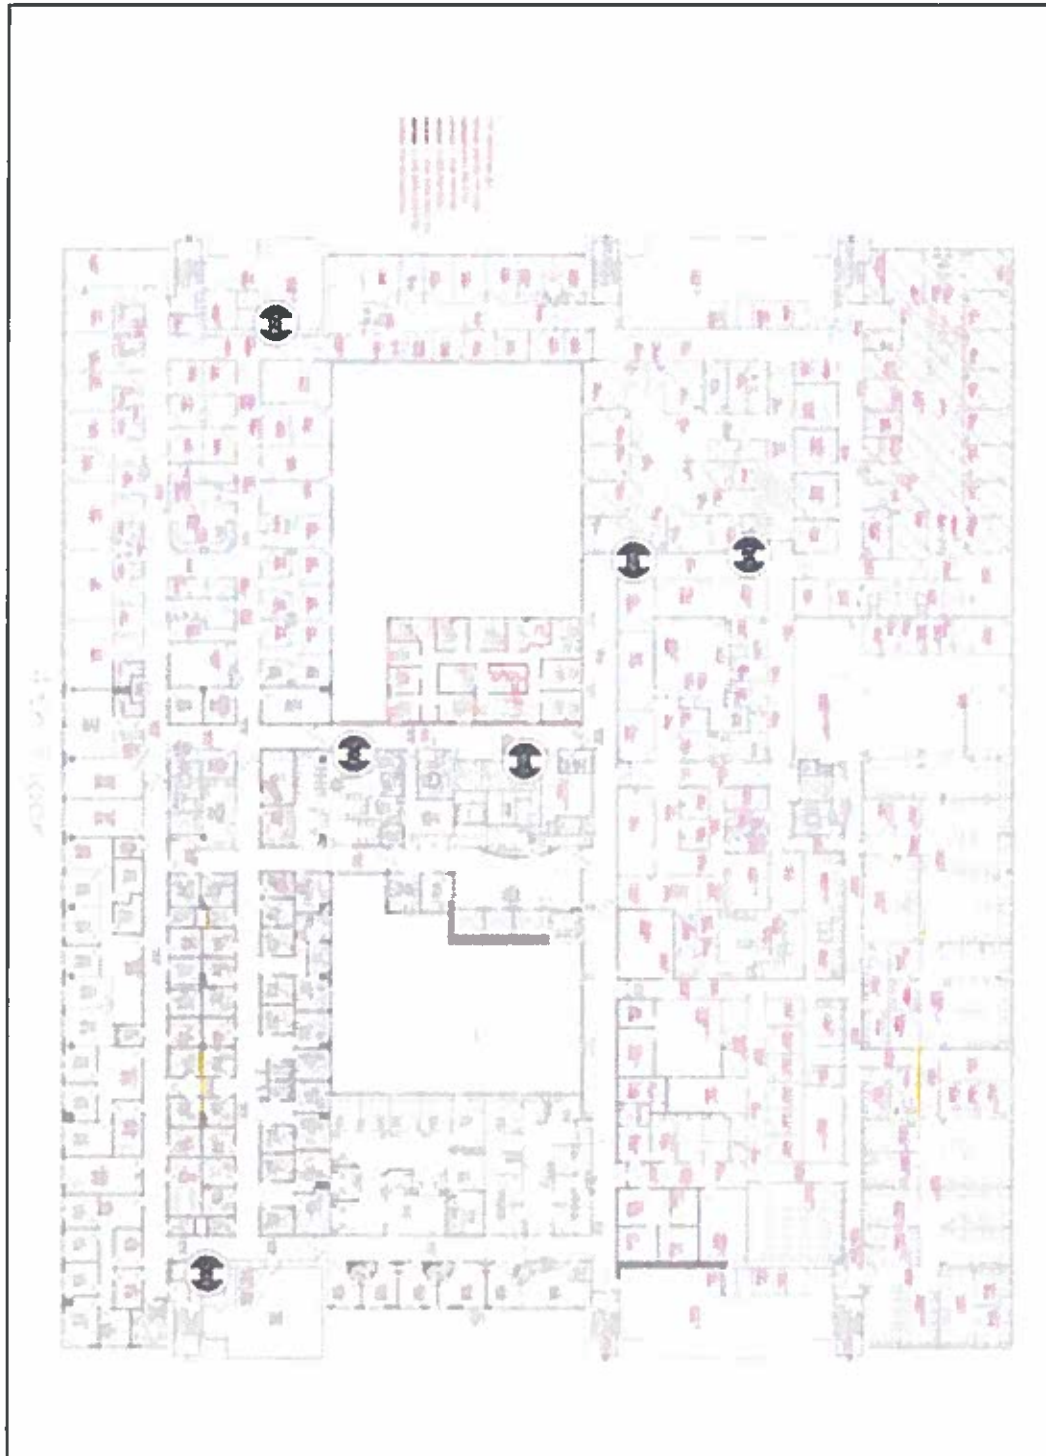


Item Count: 1



EOC Solutions, LLC

117 Apple Brook Way




Manchester, NH 03109

Date Created	Created By	EOCS ID #	Full Plan View	Room Number	Item	Type	Wall Material	Fire Rating	Comments	Width (ft.)	Height (ft.)	Sides	Status
8/20/17	DP	455799	30432 Baltimore VAMC OTF / Baltimore VAMC / 4.0 4th Floor	4B-182	Large Opening	Sections of walls missing	Gypsum	1 Hour Fire Smoke Barrier	12"x14" large opening	1	1	1	Open
 8/20/17 09:25 AM													
8/20/17	DP	455836	30432 Baltimore VAMC OTF / Baltimore VAMC / 4.0 4th Floor	4A-133C	Large Opening	Sections of walls missing	Concrete	1 Hour Fire Smoke Barrier	12"x12"	1	1	1	Open
 8/20/17 10:57 AM													
8/21/17	DP	456977	30432 Baltimore VAMC OTF / Baltimore VAMC / 4.0 4th Floor	Elevator	Large Opening	Sections of walls missing	Gypsum	1 Hour Fire Smoke Barrier	8X18 large opening	2	1	1	Open
8/21/17	JF	456735	30432 Baltimore VAMC OTF / Baltimore VAMC / 4.0 4th Floor	Double Doors	Large Opening	z-other	Gypsum	1 Hour Fire Smoke Barrier	Scab Patch. 14"x16"	1	2	1	Open
 8/21/17 10:39 AM													
8/21/17	DP	456986	30432 Baltimore VAMC OTF / Baltimore VAMC / 4.0 4th Floor	Double doors	Large Opening	z-other	Gypsum	2 Hour Fire Smoke Barrier	12X12	1	1	1	Open

EOC Solutions, LLC

117 Apple Brook Way

Manchester, NH 03109


Date Created	Created By	EOCS ID #	Full Plan View	Room Number	Item	Type	Wall Material	Fire Rating	Comments	Width (ft.)	Height (ft.)	Sides	Status
													
			8/21/17 11:01 AM										
9/1/17	JF	462288	30432 Baltimore VAMC OTF / Baltimore VAMC / 4.0 4th Floor	4A-102	Large Opening	Through Penetrations	Gypsum	1 Hour Fire Smoke Barrier	Section of wall missing 8"x20" with metallic pipe penetration	2	1	1	Open
													
			9/1/17 04:44 PM										
													
			9/1/17 04:45 PM										

Item Count: 6

EOC Solutions, LLC

117 Apple Brook Way

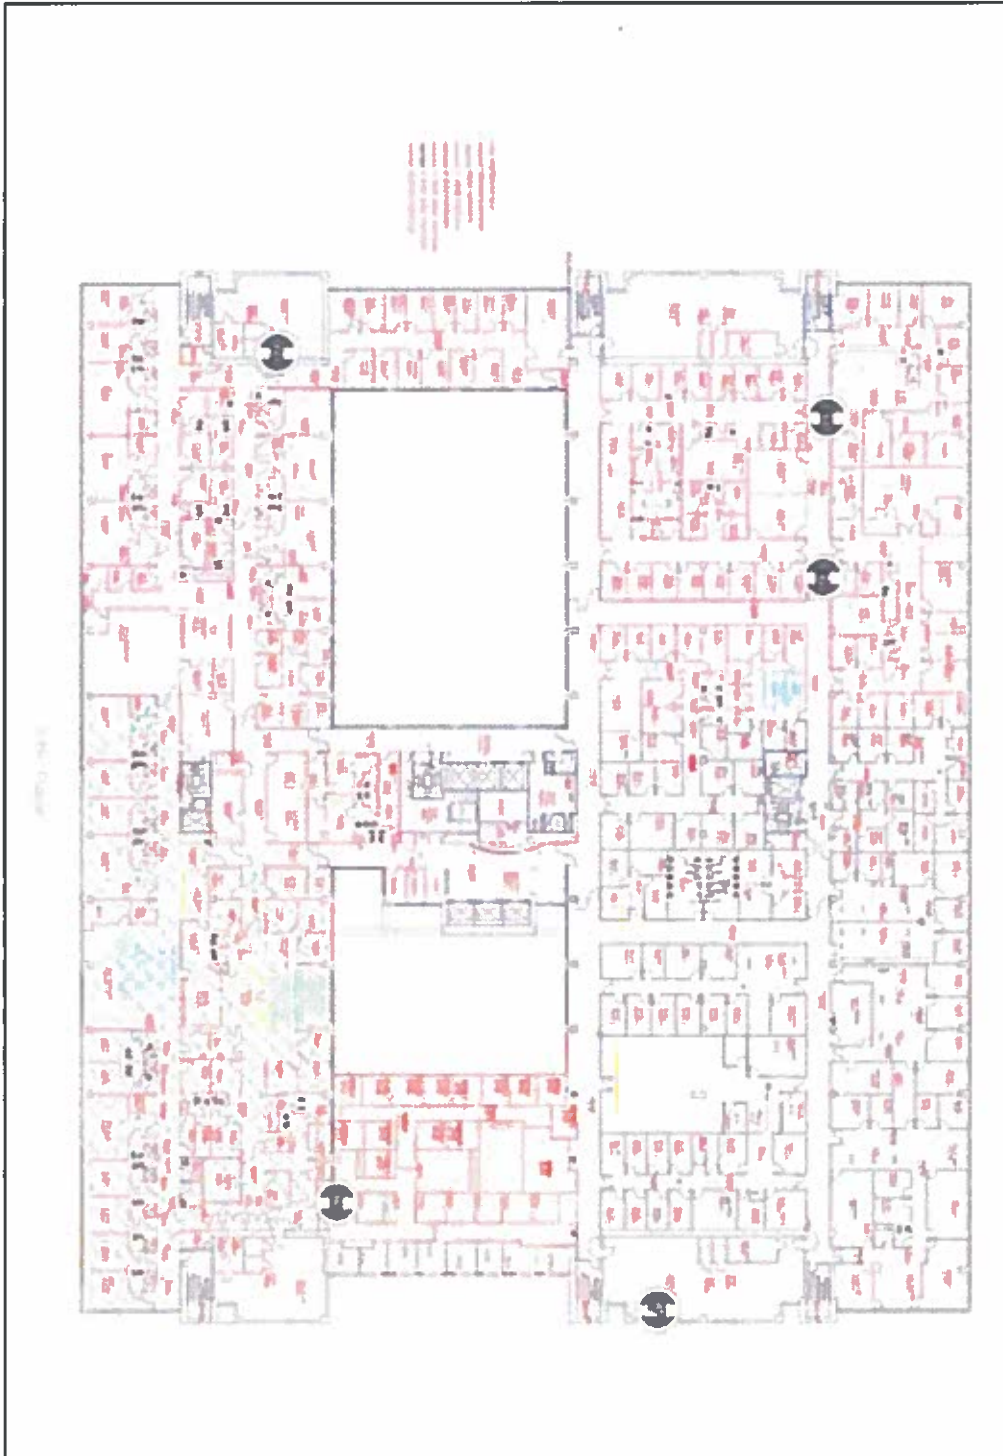


Manchester, NH 03109



EOC Solutions, LLC

117 Apple Brook Way

Manchester, NH 03109

Date Created	Created By	EOCS ID #	Full Plan View	Room Number	Item	Type	Wall Material	Fire Rating	Comments	Width (ft.)	Height (ft.)	Sides	Status
8/1/17	DP	446740	30432 Baltimore VAMC OTF / Baltimore VAMC / 6th Floor 2017.8	6D-158	Large Opening	Large wall with penetrations	Concrete	1 Hour Fire Smoke Barrier	large opening in floor, roughly 48X42.	4	4	1	Open
 8/1/17 12:44 PM													
8/2/17	DP	447769	30432 Baltimore VAMC OTF / Baltimore VAMC / 6th Floor 2017.8	6C-49	Large Opening	Sections of walls missing	Gypsum	1 Hour Fire Smoke Barrier	Section of wall missing roughly 6'X1'	6	1	1	Open
 8/2/17 03:25 PM													
8/2/17	DP	447775	30432 Baltimore VAMC OTF / Baltimore VAMC / 6th Floor 2017.8	Over double Doors	Large Opening	Sections of walls missing	Gypsum	1 Hour	Large section of wall missing over double Doors, roughly 6'X1'	6	1	1	Open
 8/2/17 04:05 PM													
8/3/17	KC	448349	30432 Baltimore VAMC OTF / Baltimore VAMC / 6th Floor 2017.8	6B-129	Large Opening	Large wall with penetrations	Gypsum	1 Hour Fire Smoke Barrier	1.5x1.5' opening under duct.	2	2	2	Open

EOC Solutions, LLC



117 Apple Brook Way

Manchester, NH 03109

Date Created	Created By	EOCS ID #	Full Plan View	Room Number	Item	Type	Wall Material	Fire Rating	Comments	Width (ft.)	Height (ft.)	Sides	Status
													
			8/3/17 03:42 PM										
8/4/17	JF	448948	30432 Baltimore VAMC OTF / Baltimore VAMC / 6th Floor 2017.8	Across 6A- 156	Large Opening	Sections of walls missing	Gypsum	1 Hour Fire Smoke Barrier	12"x12" Section of wall missing with penetration	1	1	1	Open
													
			8/4/17 10:39 AM										

Item Count: 5

EOC Solutions, LLC
117 Apple Brook Way
Manchester, NH 03109

Date Created	Created By	EOCS ID #	Full Plan View	Room Number	Item	Type	Wall Material	Fire Rating	Comments	Width (ft.)	Height (ft.)	Sides	Status
9/7/17	SO	465109	30432 Baltimore VAMC OTF / Baltimore VAMC / 7.0 7th Floor	7D 102	Large Opening	Sections of walls missing	Gypsum	1 Hour Fire Smoke Barrier	Wall Needs Built to Deck. 3ft by 100ft.	100	3	1	Open
<div>   </div> <div> 9/7/17 11:31 AM 9/7/17 11:31 AM </div>													

Item Count: 1

EOC Solutions, LLC

117 Apple Brook Way

Manchester, NH 03109

EOCS-LOCH RAVEN - LARGE (JOINTS) OPENING REPORT

30432 Baltimore VAMC OTF / Loch Raven -Offsite / 2.0 2nd Floor

Date Created	Created By	EOCS ID #	Full Plan View	Room Number	Item	Type	Wall Material	Fire Rating	Comments	Width (in.)	Length (ft.)
9/15/17	JF	469772	30432 Baltimore VAMC OTF / Loch Raven -Offsite / 2.0 2nd Floor	Double Doors	Large Opening	Joints	Gypsum	1 Hour Fire Smoke Barrier	Foreign material needs to be removed. HOW needs to be stuffed and sealed 1.5"x10"x2	1.5	20
9/15/17	SO	469733	30432 Baltimore VAMC OTF / Loch Raven -Offsite / 2.0 2nd Floor	2B-14	Large Opening	Joints	Gypsum	1 Hour Fire Smoke Barrier	HOW needs sealed to ceiling. 1in. by 25ft.	1	25
9/15/17	SO	469742	30432 Baltimore VAMC OTF / Loch Raven -Offsite / 2.0 2nd Floor	Room 2B-16	Large Opening	Joints	Gypsum	1 Hour Fire Smoke Barrier	HOW needs stuffed and sealed to fluted ceiling. 4in. by 24ft.	4	24

Item Count: 3

EOC Solutions, LLC


117 Apple Brook Way

Manchester, NJ 03109

EOCS-LOCH RAVEN - LARGE (JOINTS) OPENING REPORT

30432 Baltimore VAMC OTF / Loch Raven -Offsite / 2.0 2nd Floor



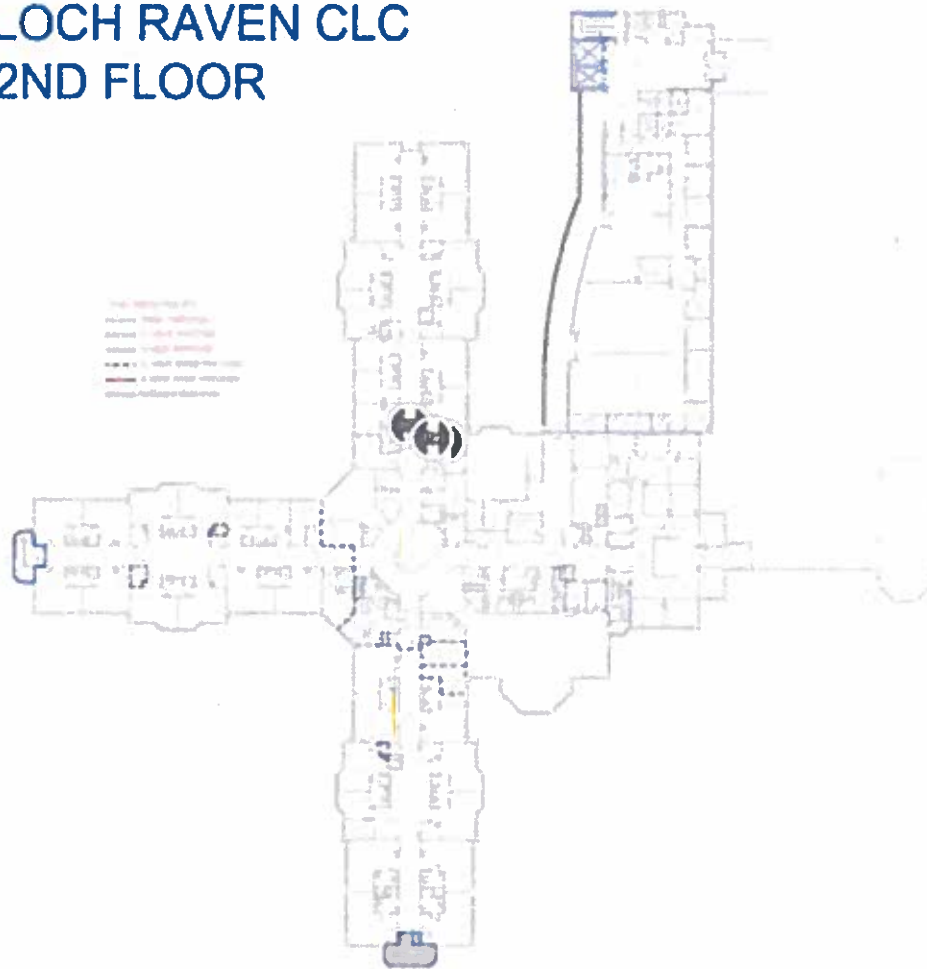




LOCH RAVEN CLC 2ND FLOOR



EOC Solutions, LLC

117 Apple Brook Way

Manchester, NH 03109

Date Created	Created By	EOCS ID #	Full Plan View	Room Number	Item	Type	Wall Material	Fire Rating	Comments	Width (in.)	Length (ft.)
9/15/17	JF	469772	30432 Baltimore VAMC OTF / Loch Raven -Offsite / 2.0 2nd Floor	Double Doors	Large Opening	Joints	Gypsum	1 Hour Fire Smoke Barrier	Foreign material needs to be removed. HOW needs to be stuffed and sealed 1.5"x10'x2	1.5	20
											
			9/15/17 02:26 PM	9/15/17 02:27 PM	9/15/17 02:27 PM						
9/15/17	SO	469733	30432 Baltimore VAMC OTF / Loch Raven -Offsite / 2.0 2nd Floor	2B-14	Large Opening	Joints	Gypsum	1 Hour Fire Smoke Barrier	HOW needs sealed to ceiling. 1in. by 25ft.	1	25
											
			9/15/17 02:32 PM	9/15/17 02:32 PM							
9/15/17	SO	469742	30432 Baltimore VAMC OTF / Loch Raven -Offsite / 2.0 2nd Floor	Room 2B-16	Large Opening	Joints	Gypsum	1 Hour Fire Smoke Barrier	HOW needs stuffed and sealed to fluted ceiling. 4in. by 24ft.	4	24
											
			9/15/17 02:54 PM	9/15/17 02:54 PM							

Item Count: 3

EOC Solutions, LLC

117 Apple Brook Way

Manchester, NH 03109