


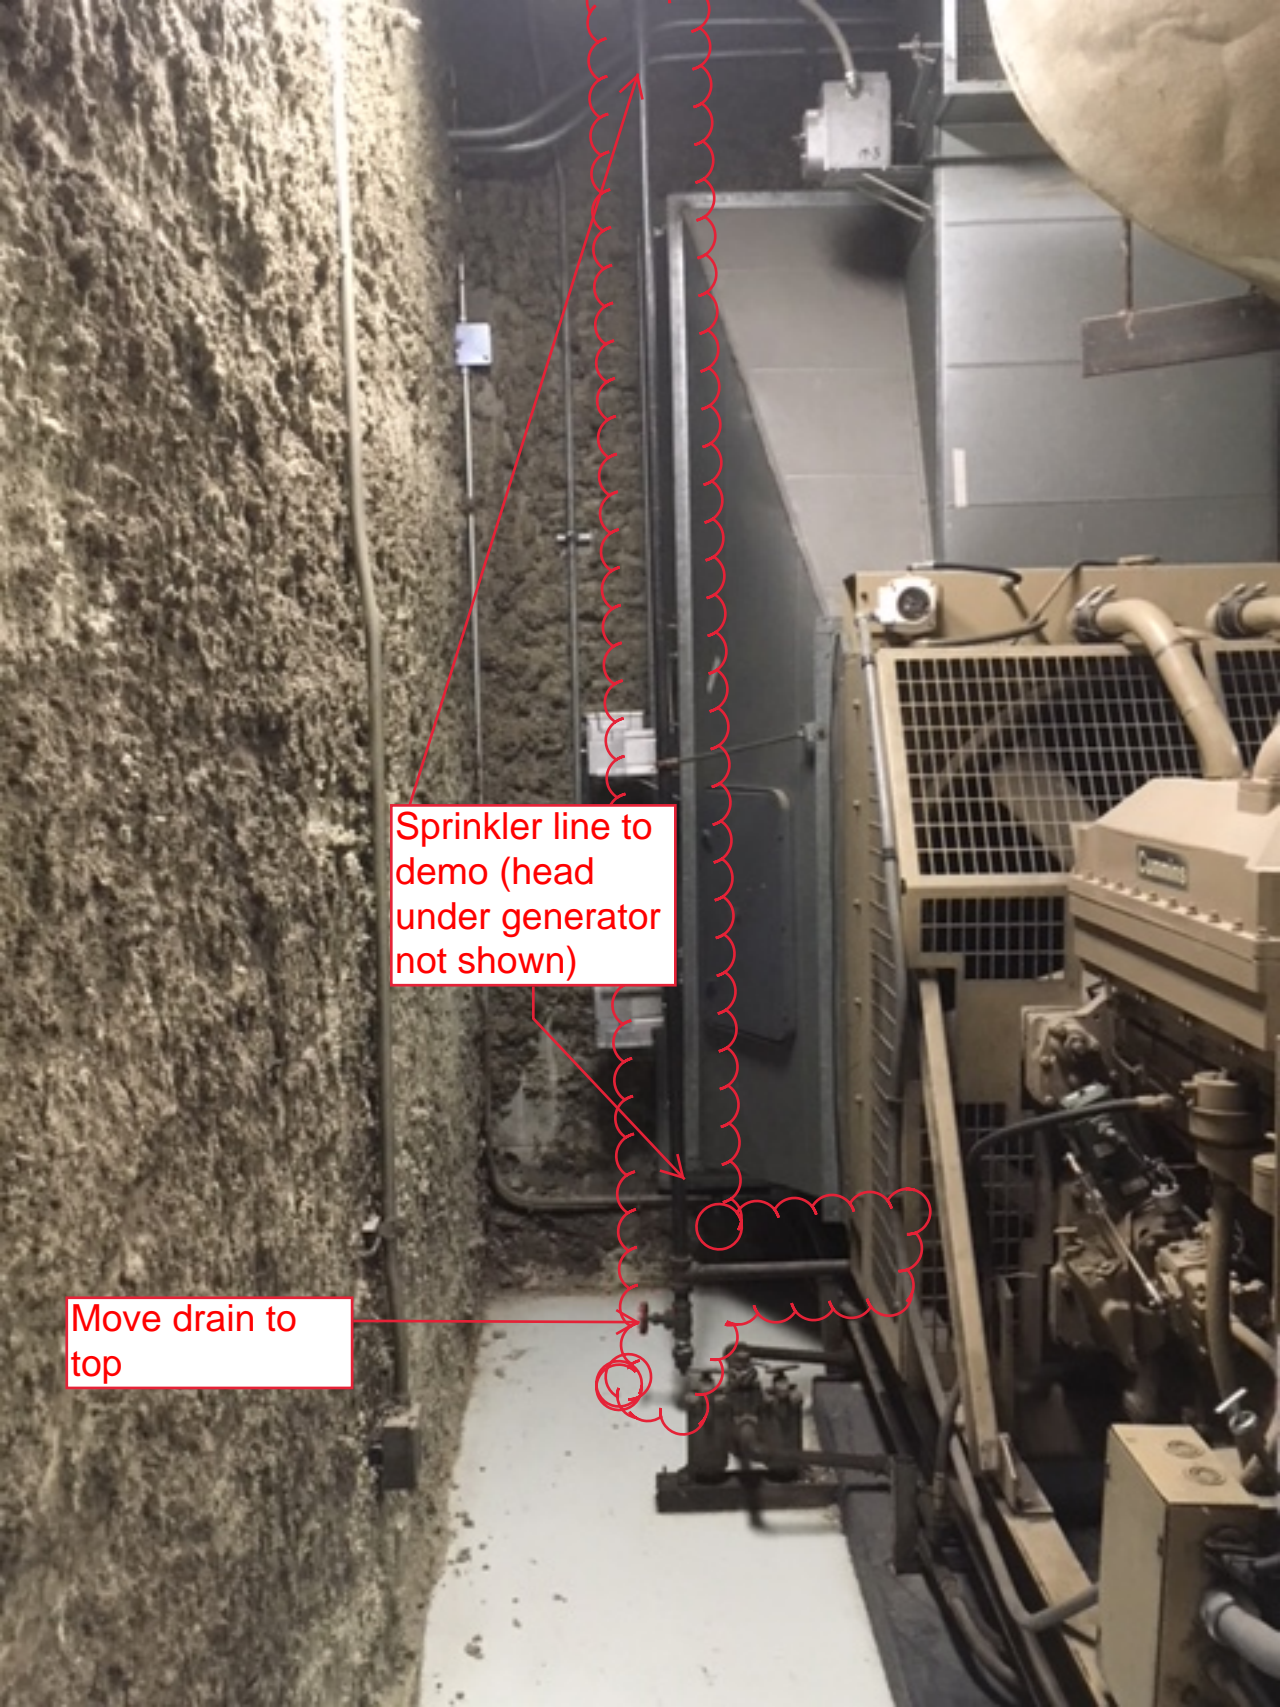

Drain line to
demo



Sprinkler line to
demo (head
under generator
not shown)

Move drain to
top