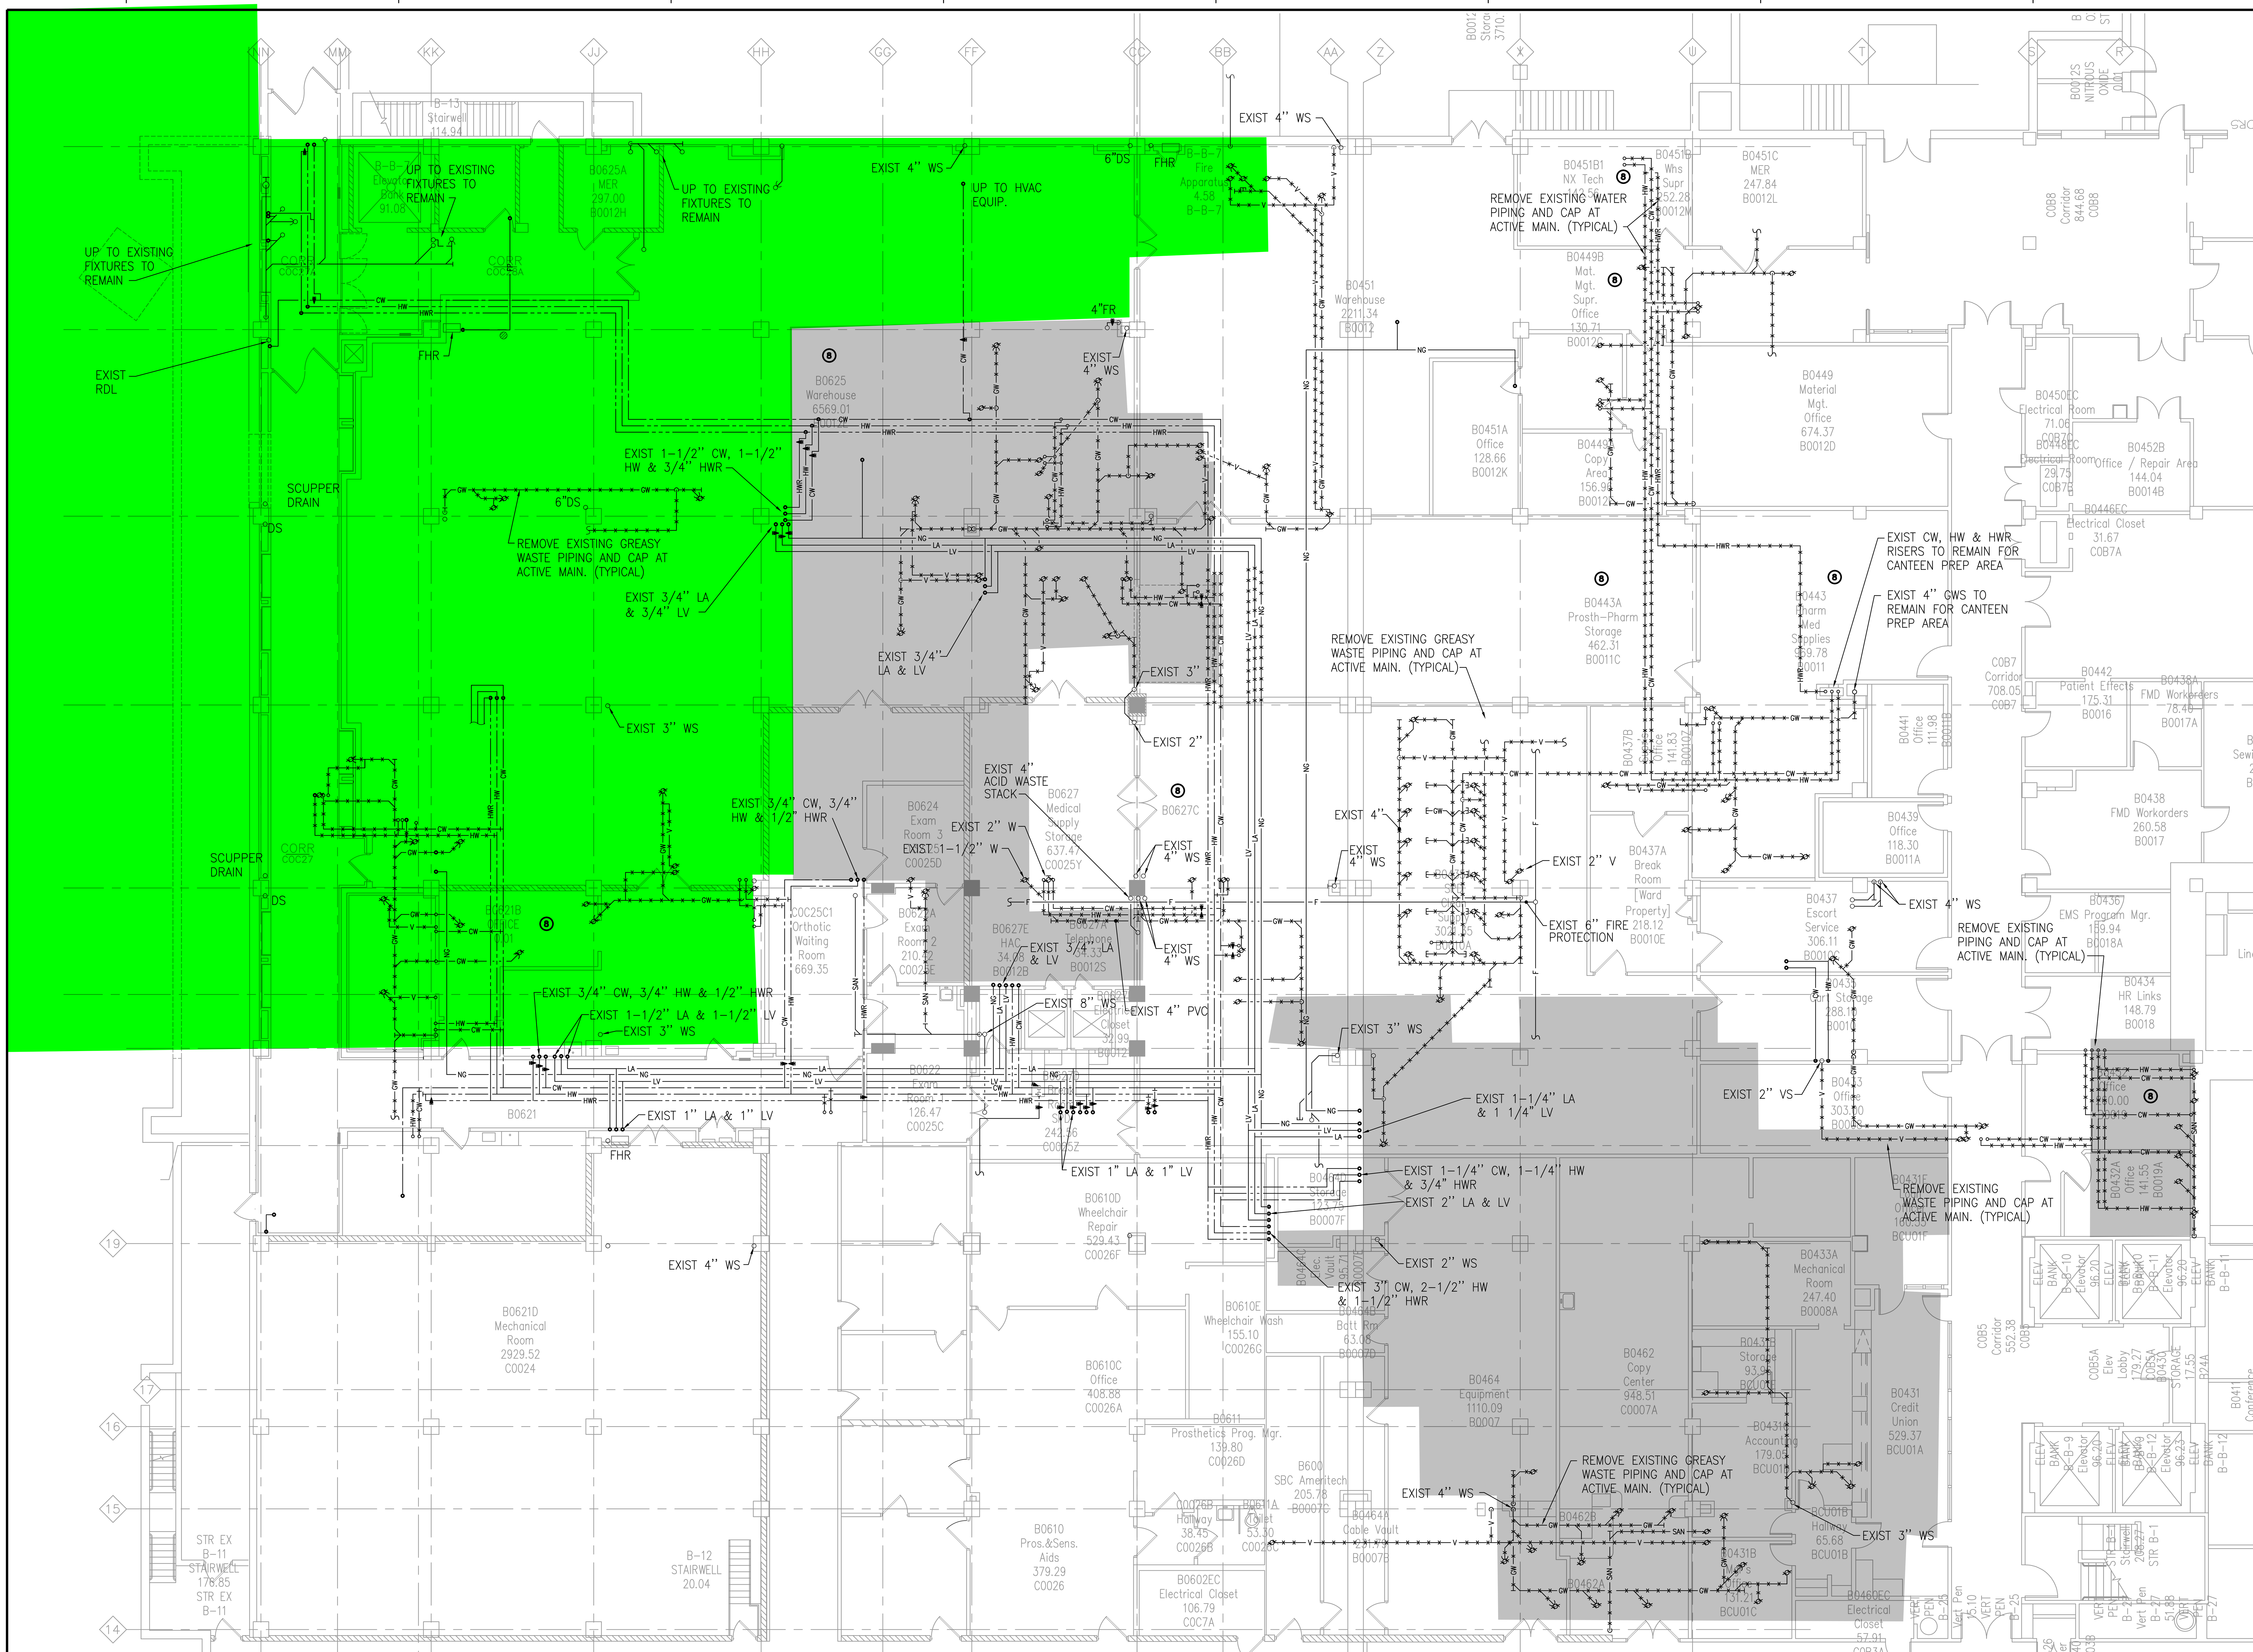

PARTIAL BASEMENT DEMOLITION PLAN

3/32"=1'-0"

ASBESTOS PLAN – GENERAL NOTES

A. SEE SECTION 028211–A FOR ADDITIONAL INFORMATION. VERIFY ALL MATERIALS AND QUANTITIES OF ACM REQUIRING REMOVAL.

B. TILED FLOORS MAY HAVE UP TO TWO INCHES OF LEVELING COMPOUND IN KITCHEN.

ASBESTOS REMOVAL NOTES

1. REMOVE CAULK
2. REMOVE CERAMIC TILE, MORTAR AND GROUT
3. REMOVE FLOOR TILE AND MASTIC
4. REMOVE BUILT–UP ROOF
5. REMOVE TAR AND FLASHING
6. REMOVE TOILET GASKET
7. REMOVE VINYL FLOORING AND MASTIC
8. REMOVE THERMAL SYSTEM FITTINGS ON FIBERGLASS INSULATION
9. REMOVE ELECTRICAL PANEL
10. REMOVE WINDOW PANE GLAZE
11. REMOVE DUCT INSULATION
12. REMOVE PIPE WRAP
13. REMOVE DUCT WRAP (CONTAINS AMOSITE)
14. POTENTIAL LOCATION OF DIELECTRIC UNIONS(S)

De-Scoped (Not In Contract)

Completed (Not In Contract)

GENERAL NOTE:
"SEE BID SCHEDULE FOR ALTERNATE BID INFORMATION"

GENERAL NOTE:
"REFER TO FOOD SERVICE DRAWINGS AND SPECS FOR SCOPE OF WORK, RELATED WORK AND DETAILS"

CONSTRUCTION SET	10-21-2011
Revisions:	Date

Dept. of Veterans Affairs
Medical Center
5000 W. National Avenue
Milwaukee, WI

KEY PLAN: N — W E

ARCHITECT:

Plunkett Raysich Architects, LLP
11000 West Park Place ▲ Milwaukee WI 53224 ▲ Tel 414 359-3060 ▲ Fax 414 359-3070
Intelligent Designs Inspired Results
www.prarch.com
PRA Job No. 10019

Drawing Title: PARTIAL BASEMENT ASBESTOS REMOVAL PLAN

Approved: Project Director

Project Title: Expand Primary Care / Specialty Clinic and Consolidate Kitchen

Location: VA Medical Center,Milwaukee, WI

Date: 21 October 2011 | Checked: PRA | Drawn: RLS

Project Number: 695-315

Building Number: Building 111

Drawing Number: AS100

Office of Construction and Facilities Management

Department of Veterans Affairs

VA FORM 08-6231

Plunkett Raysich Architects, LLP – October 21, 2011 – 9:55am
I:\Plunkett Raysich\12590 – Kitchen Project\060 CAD\CAD Demo Drawings\AS100 Basement-SubBasement\AS100 Basement-SubBasement Plan_Sigma.dwg [AS100 Demo Plans] pfinn