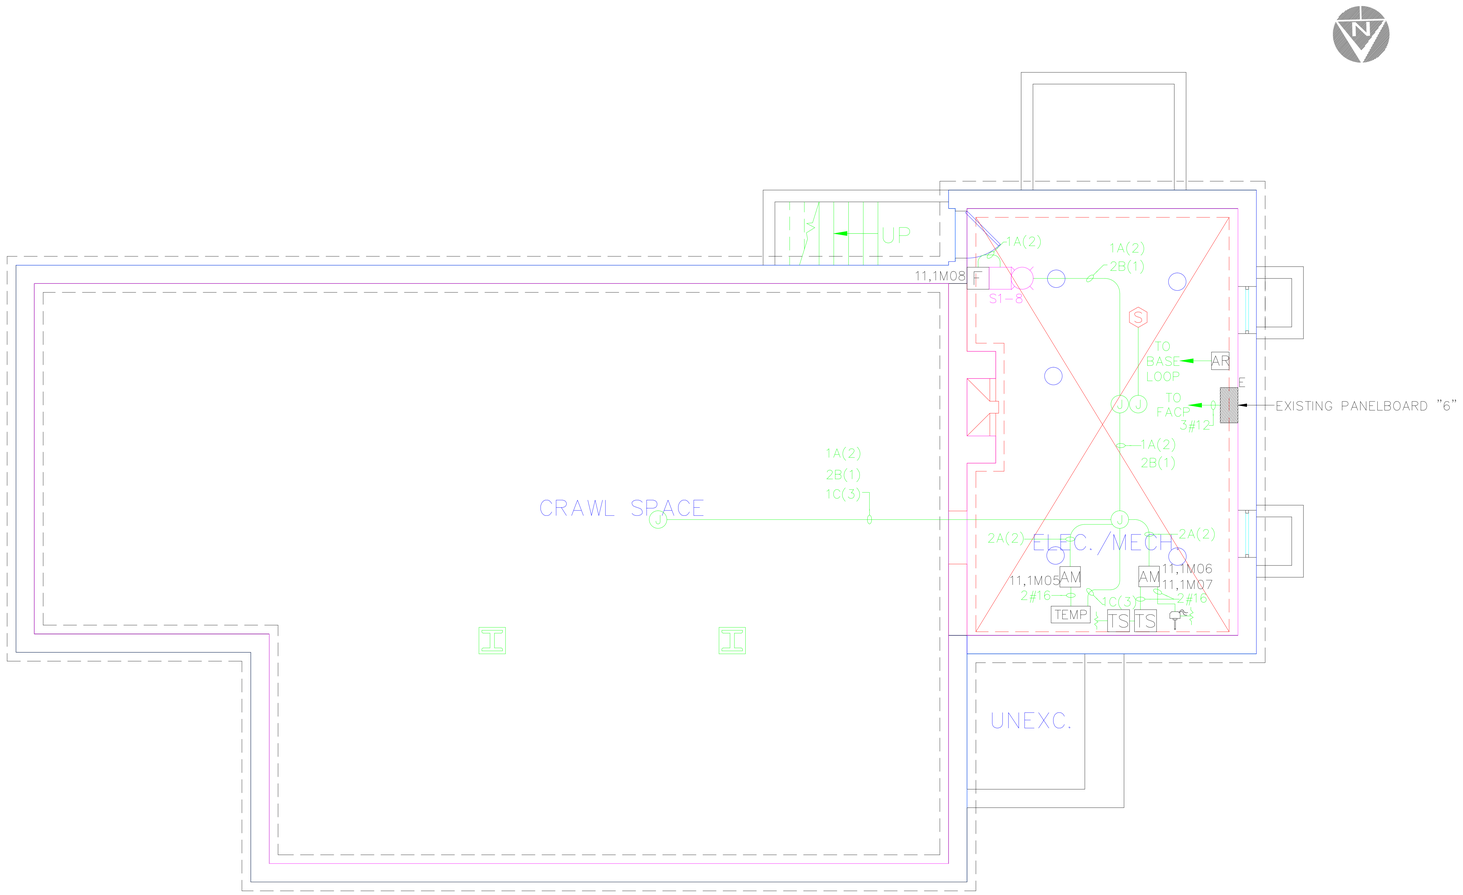

LEGEND

SYMBOLS	DESCRIPTION
	FLOW SWITCH
F	FIRE ALARM PULLSTATION
J	JUNCTION BOX
S	SMOKE DETECTOR
	AUDIO VISUAL ALARM
	END-OF-LINE RESISTOR
AR	AUXILARY ISOLATION RELAY
AM	ADRESSIBLE MONITOR MODULE
	HOME RUN
	480V., 3ø, 3 W-OR 277/480V., 3ø 4W. PANEL BOARD
TS	TAMPER SWITCH

Revisions | Date

Professional Seal

Indus Systems, Inc.
2352, Main Street, Concord MA 01742
Tel: 978-461-0555
www.indus-systems.com

Drawing Title: BASEMENT FLOOR PLAN FIRE PROTECTION

Approved:

Approved:

Project Title: AS-BUILT Drawings

Building Number: 06

Checked | Drawn

Location: VAMC WILMINGTON DELAWARE

Date: 09-18-2009

Project No.

Drawing No. 460-6-B-FP

VAMC, WILMINGTON

Department of Veterans' Affairs

VA FORM 08-6231, OCT 1978

H:\Drawings\Building 6\WL-06-0BFP.dwg, 8/20/2012 3:58:53 PM, 1:1