


GENERAL SHEET NOTES:


- FOR GENERAL STRUCTURAL NOTES SEE DRAWING S-001.
- "PROJECT REFERENCE ELEVATION: THE AVERAGE FINISH FLOOR ELEVATION FOR THE BOILER ROOM WAS ESTABLISHED AS 0.0'. ALL ELEVATIONS SHOWN WITHIN THE CONTRACT DRAWINGS ARE RELATIVE TO THIS ELEVATION."

SHEET KEYNOTES:

- PROVIDE NEW PLATFORM AND RAILINGS. REFER TO DETAIL 6/S-501.
- PROVIDE NEW SHIP LADDER WITH SAFETY CHAIN ACROSS RAILING OPENING.
- PROVIDE NEW LADDER WITH SAFETY CHAIN ACROSS RAILING OPENING. REFER TO DETAIL 1/S-502.
- PROVIDE NEW ANGLE FRAME AND TREAD PLATE COVER FOR PIPE TRENCH. REFER TO DETAIL 10/S-501.
- PROVIDE NEW CONCRETE PIPE TRENCH WITH TREAD PLATE COVER. REFER TO 11/S-501.
- PROVIDE NEW BOILER RAIL. REFER TO 4/S-501.
- PROVIDE NEW BOILER FOUNDATION. REFER TO 1/S-501.
- PROVIDE NEW 42" HIGH RAILING. MATCH EXISTING PROFILE, SHAPES, AND CONNECTIONS.
- PROVIDE NEW DIAGONAL BRACING ON PLATFORM HANGERS. REFER TO DETAIL 8/S-501.
- PROVIDE NEW PLATFORM SUPPORT POSTS. REFER TO DETAIL 9/S-501.
- PROVIDE NEW SUPPLEMENTAL STRUCTURAL STEEL FOR MEP LINES AND EQUIPMENT AS SHOWN.
- PROVIDE NEW GUY WIRE ANCHOR. REFER TO DETAIL MECH DWGS.
- PROVIDE NEW LINTEL AND WALL OPENING FOR PIPE PENETRATION. REFER TO DETAIL 5/S-501.
- PROVIDE NEW SUPPLEMENTAL STEEL FOR EXISTING PLATFORM PENETRATION. REFER TO DETAIL 12/S-501.
- PROVIDE NEW STEAM LINE ANCHOR WITH ANGLE BRACES AS SHOWN IN PLAN. REFER TO DETAIL 8/S-501.

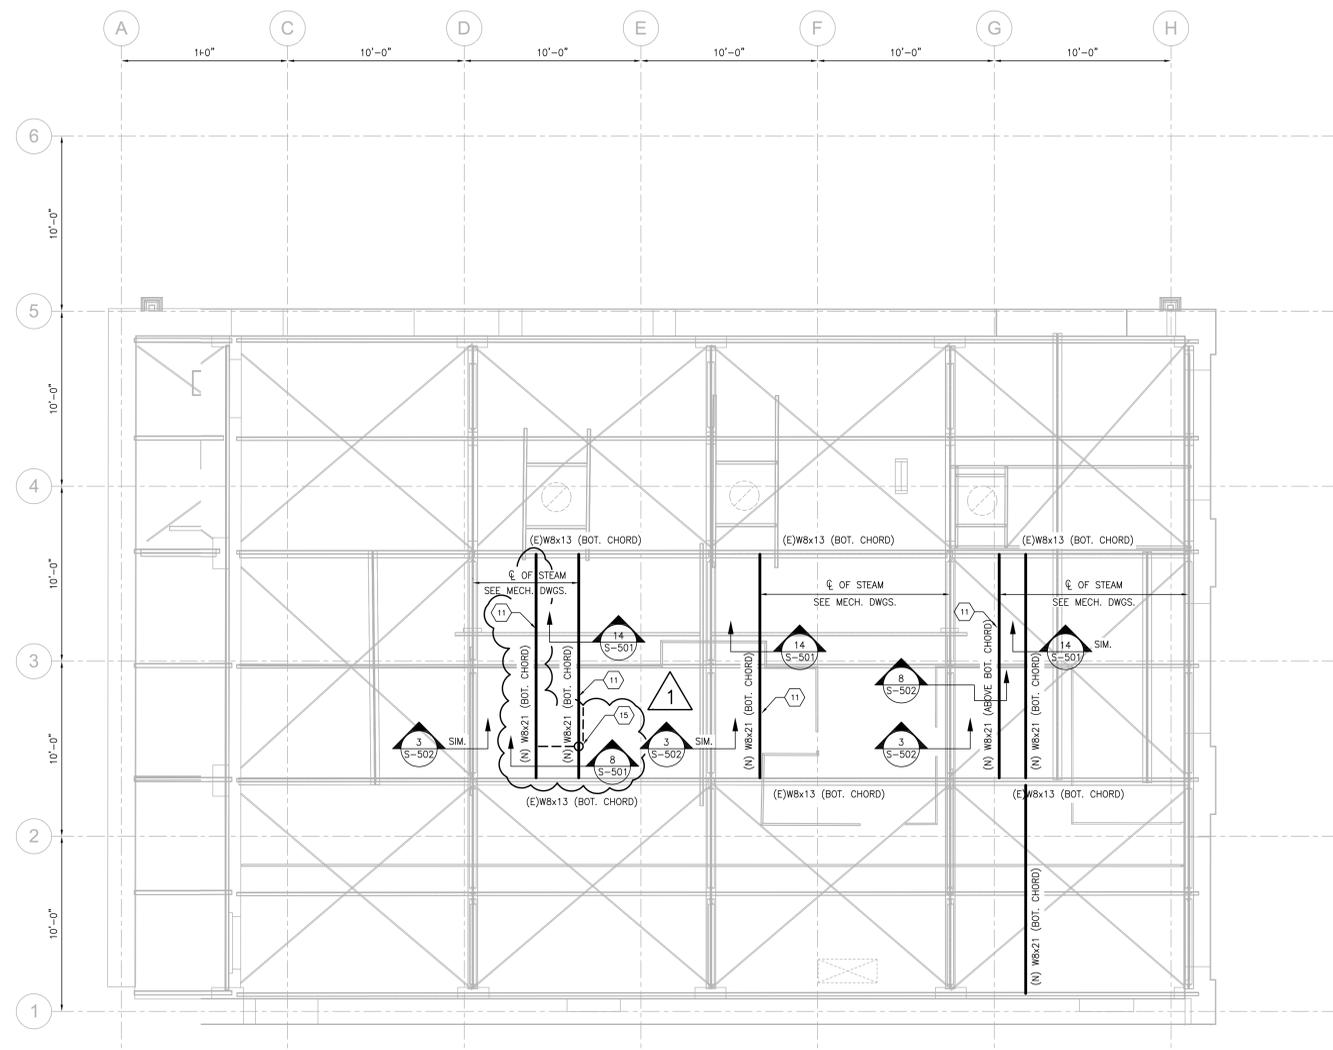

1 PLAN - BOILER ROOM ROOF
SCALE: 1/4" = 1'-0"

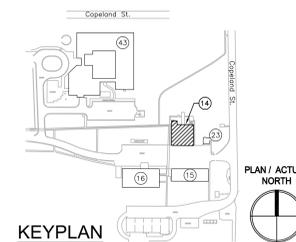

CONSTRUCTION BID DOCUMENTS

PRINTS OF THIS DRAWING SHALL NOT BE USED FOR ANY PURPOSE WHATSOEVER WITHOUT THE SEAL AND SIGNATURE OF THE PROFESSIONAL ENGINEER.

NO.	DESCRIPTION	DATE
1	ADDED BEAM, PIPE ANCHOR & SHEET KEY NOTE	7/13/18

CONSULTANTS:

MILLER-REMICK, LLC
PROFESSIONAL ENGINEER

Miller-Remick LLC
M.E.P. & Structural Engineering
A Service Disabled Veteran Owned Small Business

1010 KINGS HIGHWAY SOUTH
CHERRY HILL, NEW JERSEY 08034
PHONE: (856)429-4000
FAX: (856)429-5002
MR PROJECT NO: 0509-0002

Drawing Title STRUCTURAL PLAN BOILER ROOM ROOF
Approved: Project Director

Project Title REPLACE BOILERS VAMC, MARION, IL
Location 2401 MAIN ST, MARION, IL 62959
Date 03-23-2018

Project Number 657A5-17-107
Building Number 14
Drawing Number SF104

Office of Construction and Facilities Management

Department of Veterans Affairs