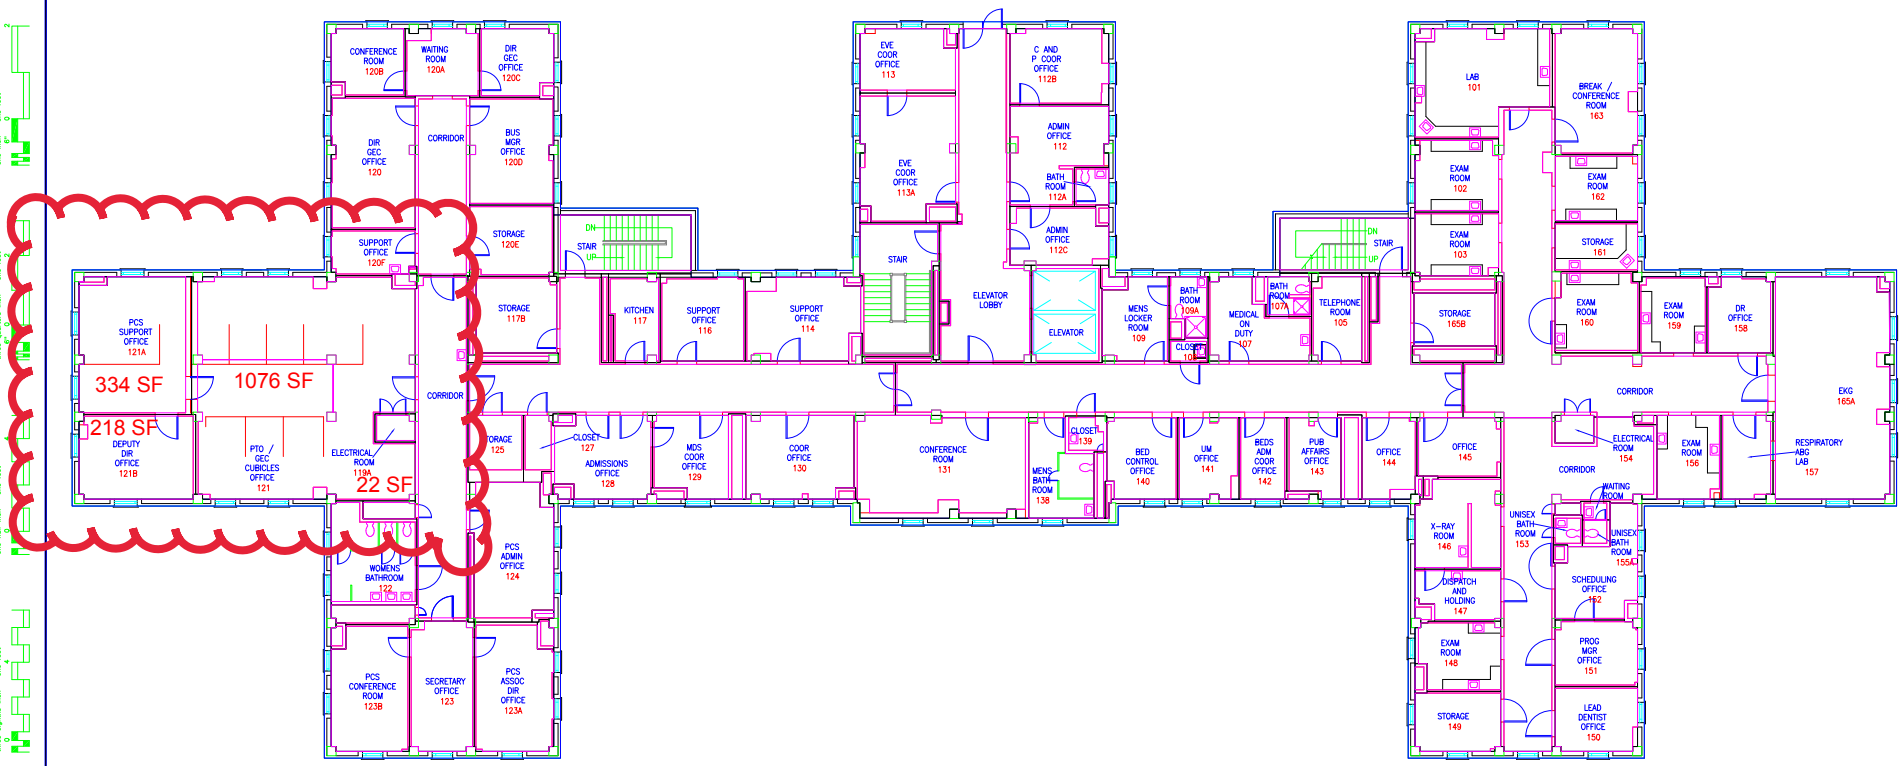

Revisions | Date

Professional Seal

Indus Systems, Inc.
2352, Main Street, Concord MA 01742
Tel: 978-461-0555
www.indus-systems.com

Drawing Title: FIRST FLOOR PLAN ARCHITECTURAL

Approved:

Approved:

Project Title: AS-BUILT Drawings

Building Number: 01 | Checked | Drawn

Location: VAMC COATESVILLE

Date: 11-24-2010

Project No.

Drawing No.

VAMC, COATESVILLE

VA Department of Veterans Affairs

VA FORM 08-6231, OCT 1978