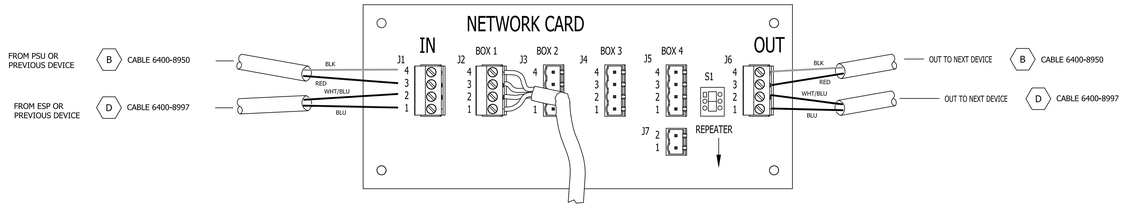

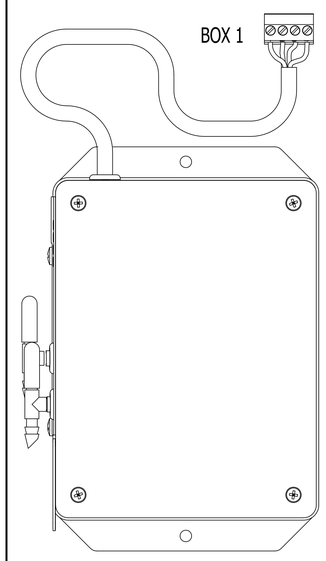

AIR FLOW MODULE

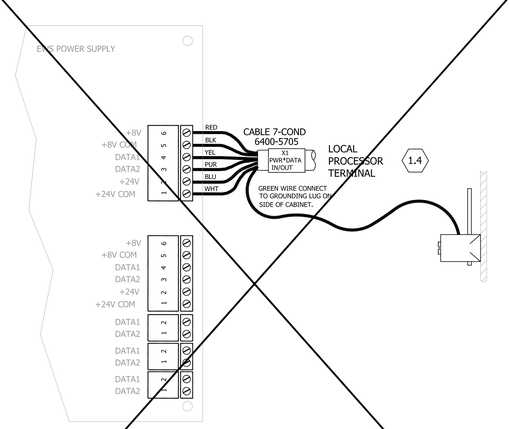

POWER SUPPLY

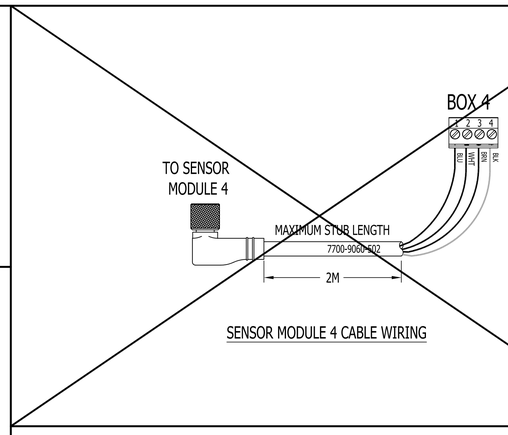

SENSOR MODULE 4 CABLE WIRING

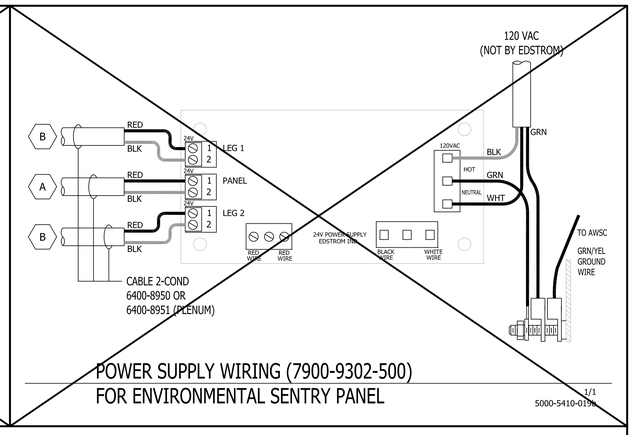

POWER SUPPLY WIRING (7900-9302-500)
FOR ENVIRONMENTAL SENTRY PANEL

1/1
5000-5410-019K

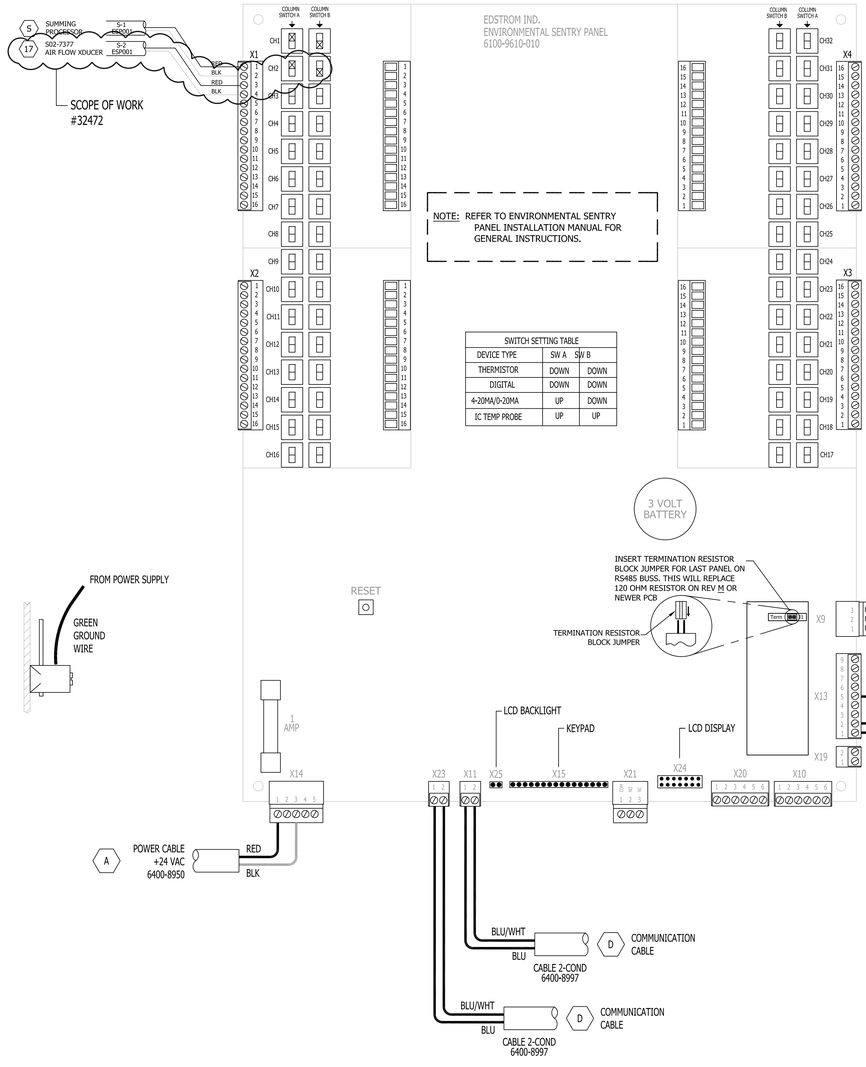

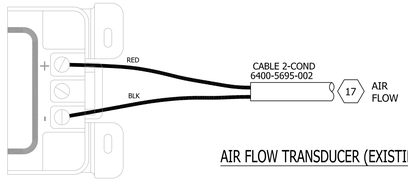

AIR FLOW TRANSDUCER (EXISTING)

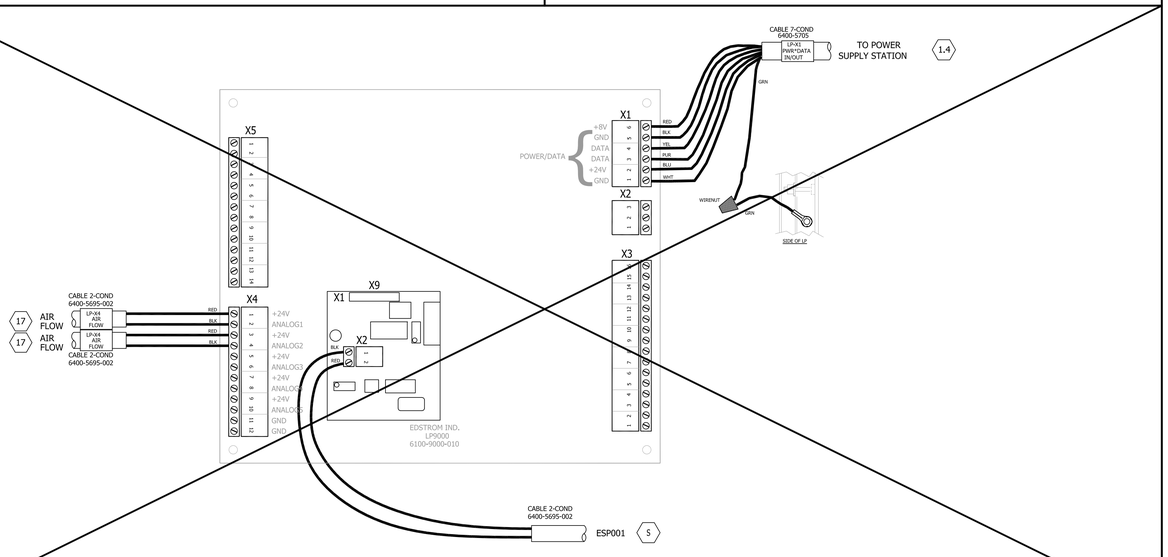

ANALOG SUMMING BOARD

ESP-002

REV.	JOB NO.	REVISION	DRAWN	CHECKED	APPROVED
D	#050-0708	SUBMITTAL: INITIAL DRAWING RELEASE.	GJH-06/30/05	KJH-06/30/05	- / / -
A	#050-0708	AS-BUILT: ADD CONNECTION FOR SUMMING PROCESSOR, AF TRANSDUCER AND PSU.	GJH-04/21/06	KJH-04/4/06	- / / -
B	#32472	SUBMITTAL: UPDATE ESP BOARD AND PSU DETAILS; SHOW THE SCOPE OF WORK DETAILS ONLY; ADDED AIR FLOW XDUCER TO S-3.	KGO-04/25/17	PKS-05/02/17	PEB-05/03/17

REV.	JOB NO.	REVISION	DRAWN	CHECKED	APPROVED
0	#	-	DFT-#KJO/DI/YR	- / /	- / /

REV.	JOB NO.	REVISION	DRAWN	CHECKED	APPROVED
0	#	-	DFT-#KJO/DI/YR	- / /	- / /

REV.	JOB NO.	REVISION	DRAWN	CHECKED	APPROVED
0	#	-	DFT-#KJO/DI/YR	- / /	- / /

When applicable, the detail views on this drawing incorporate third angle projection.

PROPRIETARY DATA-INFORMATION:
Reproduction or disclosure of data or information contained hereon without the explicit consent of Edstrom is forbidden.

Edstrom
819 Bakke Avenue, Waterford, WI 53185
Tel: 262.534.5181 Fax: 262.534.5184

ESP CONTROLLER CABLE CONNECTIONS FOR:
JESSE BROWN V.A. MEDICAL CENTER
BUILDING 11B/7th FLOOR/MEDICAL R&D SERVICE 278
CHICAGO, IL

PLOT SCALE	1 = 1	E BORD	DRAWING NO.	REV.
DRN.BY	GJH	DATE 08-30-05	5110-9156-001	B