


### Existing Floor Plan

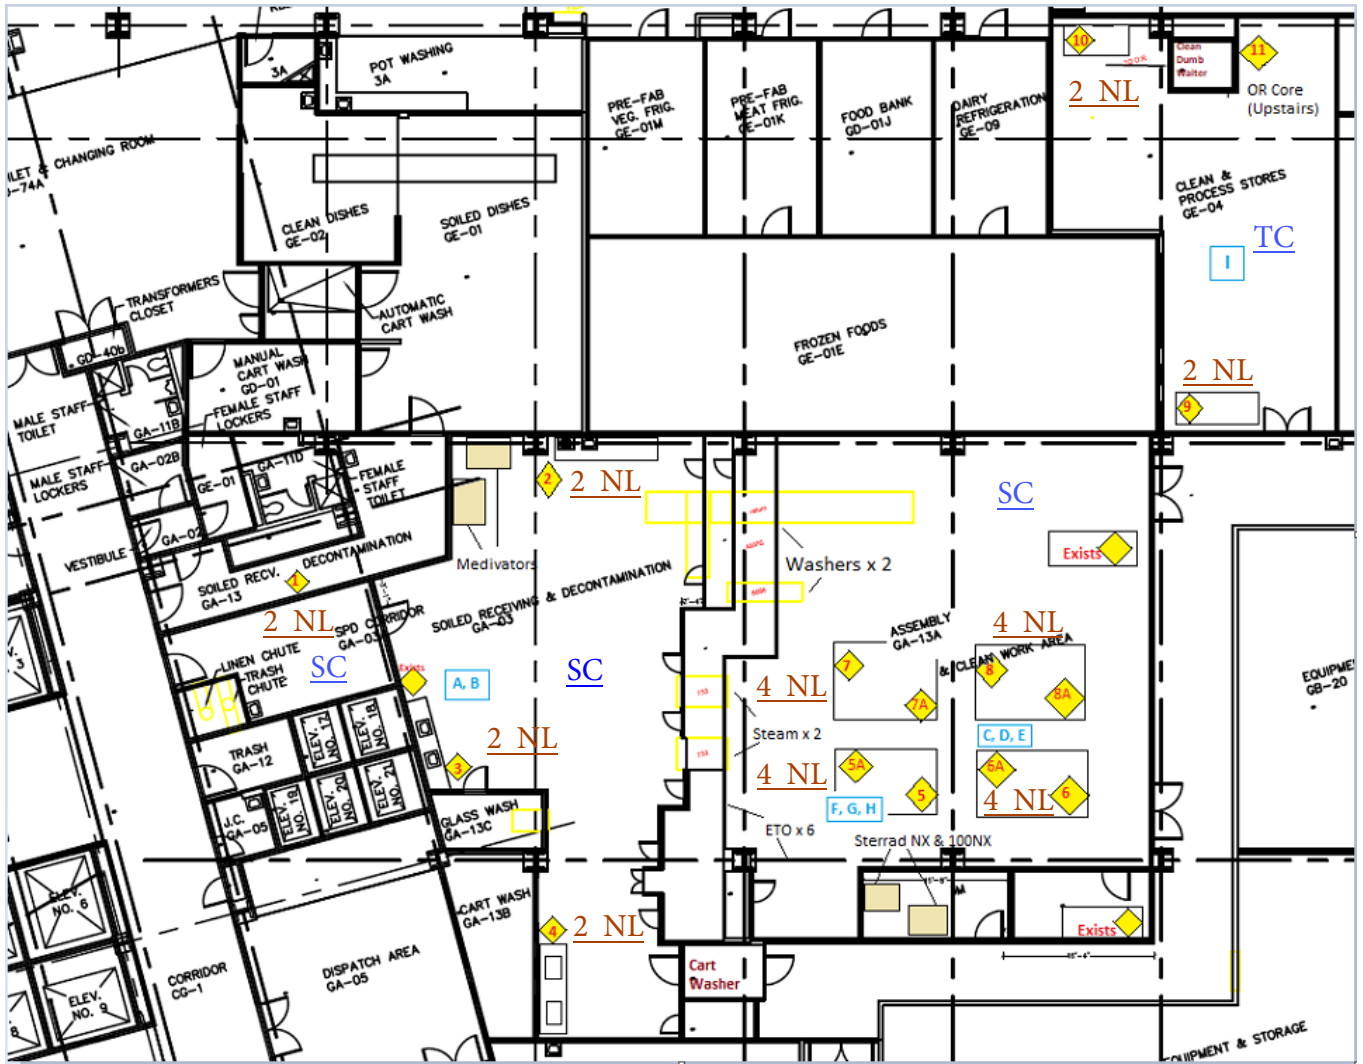

NL = Network Line (CAT 6)

SC = Solid Ceiling

TC = Tiled Ceiling