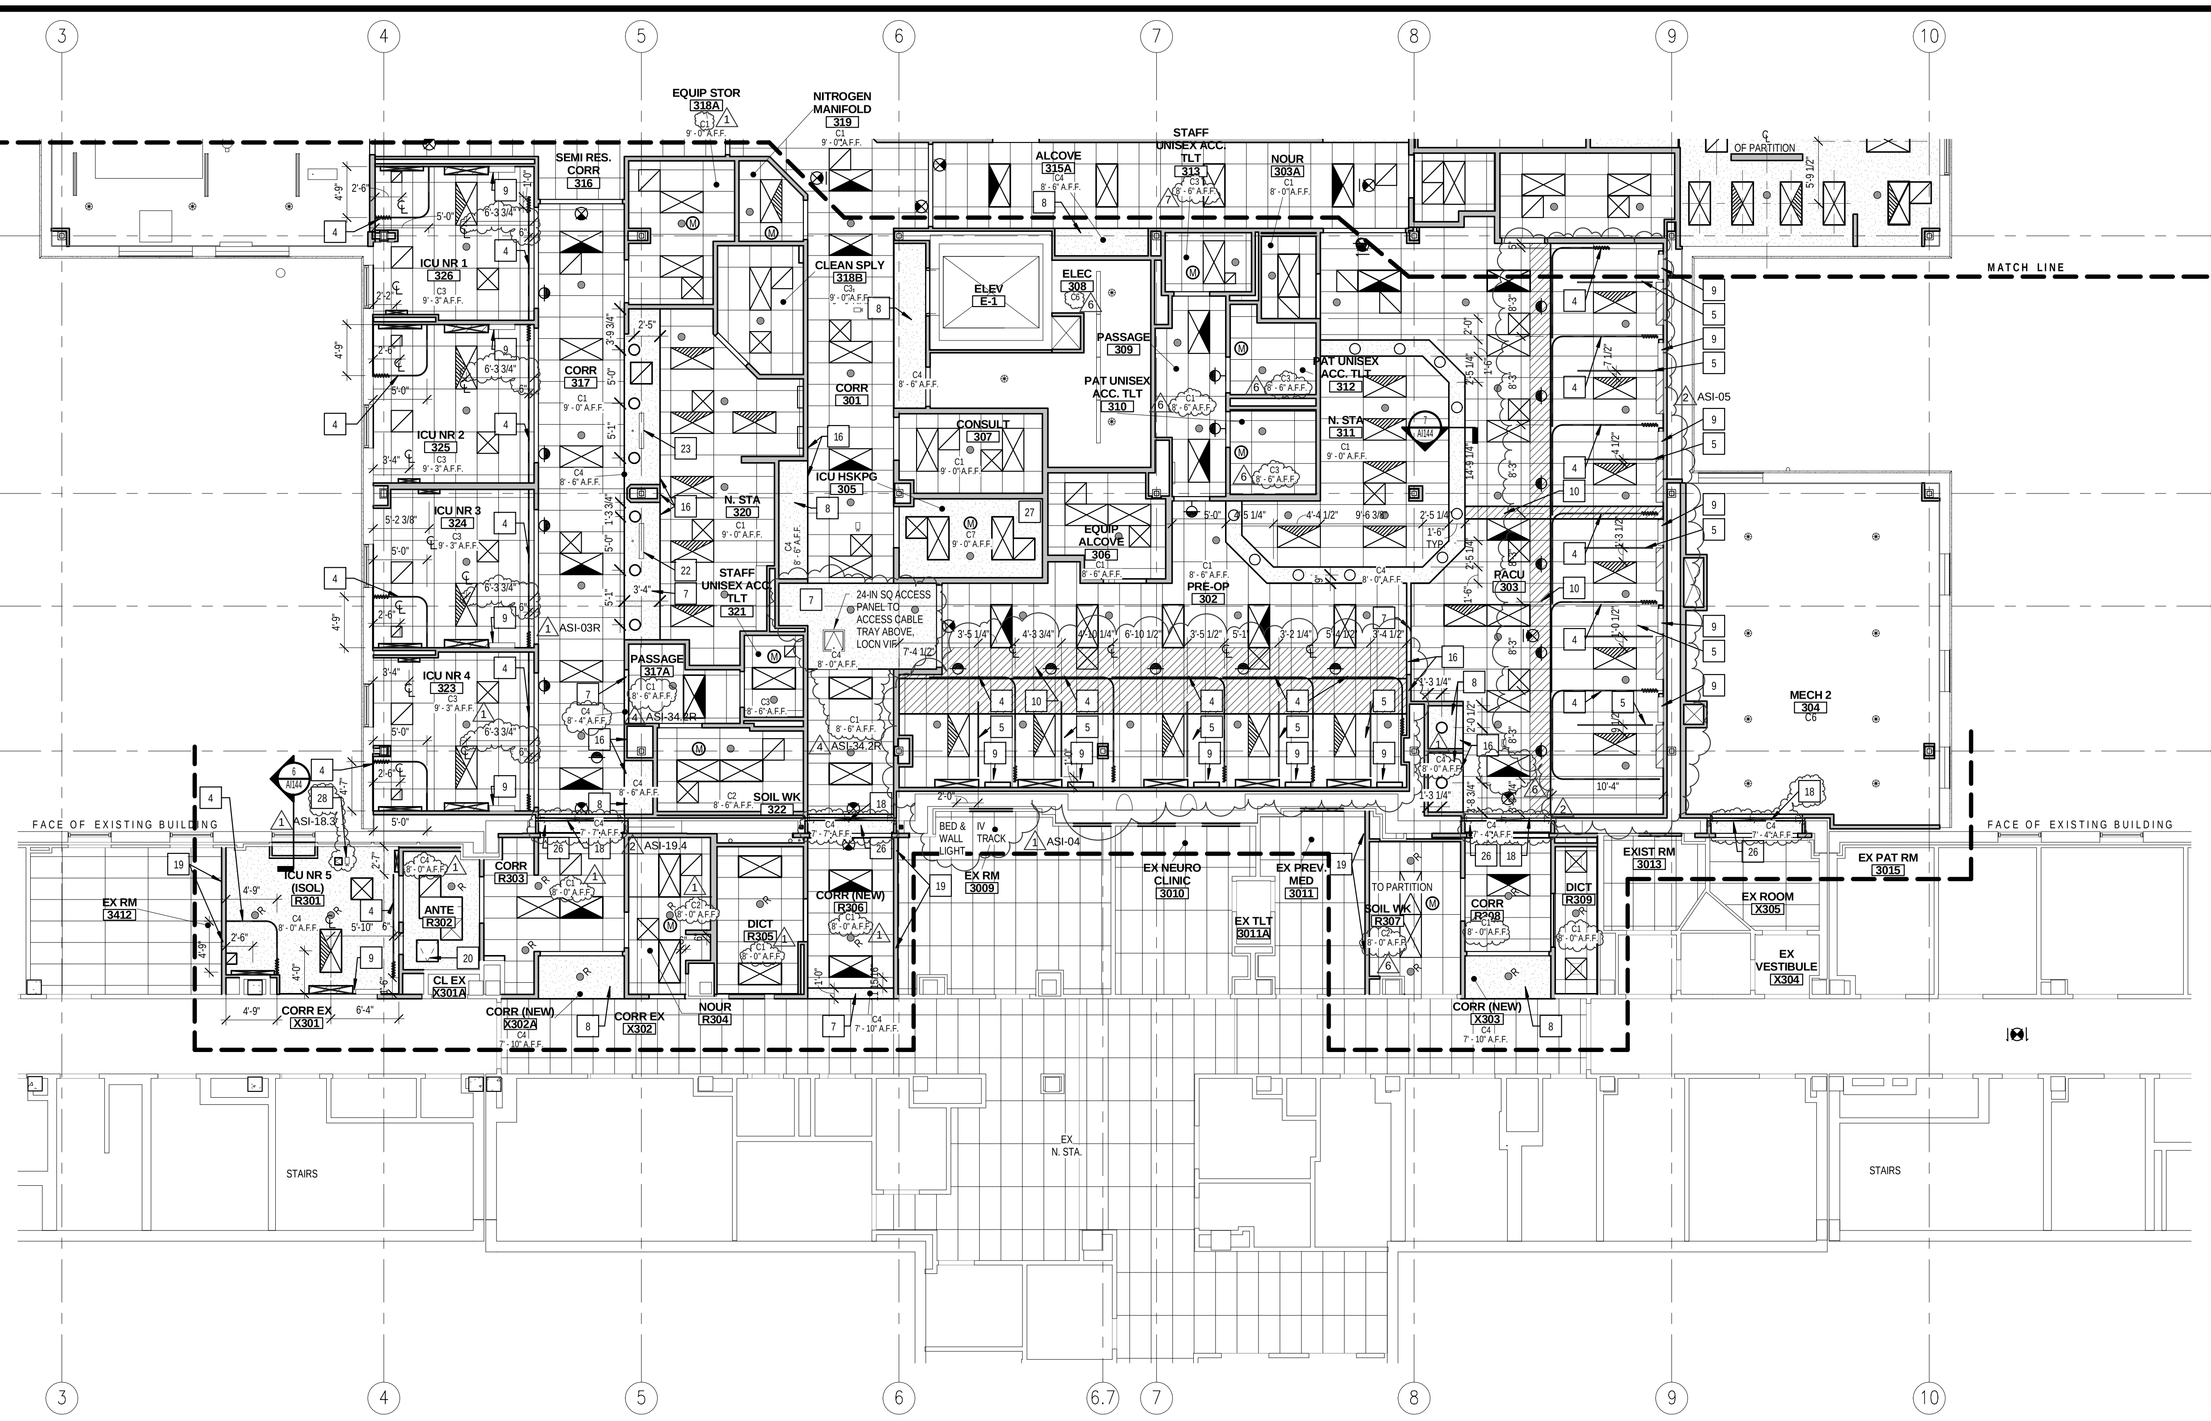

1 PARTIAL THIRD FLOOR REFLECTED CEILING PLAN - SOUTH
1/8" = 1'-0"

REFLECTED CEILING PLAN LEGEND:

ELECTRICAL FIXTURES:

- 2x4 FLUORESCENT LIGHTING FIXTURE, RE: ELEC.
- 2x2 FLUORESCENT LIGHTING FIXTURE, RE: ELEC.
- FLUORESCENT STRIP FIXTURE, RE: ELEC.
- 4' FLUORESCENT WALL MOUNT FIXTURE, RE: ELEC.
- 2' FLUORESCENT WALL MOUNT FIXTURE, RE: ELEC.
- 6" RECESSED DOWNLIGHT, RE: ELEC.
- SECURITY CAMERA DATA LOCATION RE: ELEC
- OCCUPANCY SENSORS RE: ELEC
- CLG MTD DATA OUTLETS RE: ELEC

POWER DESIGNATION:

- STANDARD
- EMERGENCY POWER
- CRITICAL POWER

CLG	WALL	
		EXIT SIGN SINGLE-SIDED FIXTURE DIRECTIONAL ARROWS AS INDICATED, RE: ELEC.
		EXIT SIGN DOUBLE-SIDED FIXTURE DIRECTIONAL ARROWS AS INDICATED, RE: ELEC.
		MOUNTED NURSE CALL DOME LIGHT RE: ELEC.

MECHANICAL:

- RETURN OR EXHAUST GRILLE OR REGISTER, RE: MECH.
- CEILING MOUNTED ACCESS PANEL RE: #8/AI144 & MECH.
- EXHAUST GRILLE, RE: MECH.
- SUPPLY AIR DIFFUSER, REGISTER, OR GRILLE, RE: MECH.
- PERIMETER SUPPLY AIR DIFFUSERS, RE: MECH.

ARCHITECTURAL:

- GWB CEILING
- PLASTER CEILING NOT USED
- 2'x4' SUSPENDED ACOUSTICAL CEILING TILE

FIRE PROTECTION:

- SPRINKLER HEAD, RE: FIRE PROTECTION
- UPRIGHT SPRINKLER HEAD, RE: FIRE PROTECTION
- RELOCATED SPRINKLER HEAD, RE: FIRE PROTECTION

GENERAL NOTES:

1. REFER TO STANDARD CEILING DETAILS ON AI143 & AI144
2. ALL GWB CEILINGS TO BE PAINTED P-7, UNO

CEILING TYPES:

- C1 2x4 ACOUSTICAL CEILING TILE SYSTEM (ACT-1)
- C2 2x4 ACOUSTICAL CEILING TILE SYSTEM (ACT-2), VINYL FACED, CLIPPED DOWN - OMIT CLIPS WHERE ACCESS TO MECH. DAMPERS AND VALVES ARE REQUIRED
- C3 2x4 ACOUSTICAL CEILING TILE SYSTEM (ACT-3), VINYL FACED
- C4 5/8" GYPSUM BOARD OVER SUSPENDED CEILING SYSTEM INSTALLED PER MANUFACTURER'S RECOMMENDATIONS
- C5 NOT USED
- C6 EXPOSED STRUCTURE (DECK) - UNPAINTED
- C7 5/8" MOISTURE RESISTANT GYPSUM BOARD OVER SUSPENDED CEILING SYSTEM INSTALLED PER MANUFACTURER'S RECOMMENDATIONS

KEYED NOTES:

1. NORTH ONLY - CLG-MOUNTED TOILET PARTITIONS WITH BRACING ABOVE
2. NORTH ONLY - COORDINATE BRACING FOR CLG-MOUNTED OWNER-FURNISHED EQUIPMENT
3. NORTH ONLY - ROOF HATCH ABOVE, REFER TO VOLUME 2
4. CLG-MOUNTED CCT, REFER TO DETAIL #5/AI143; COORDINATE WITH BRACING FOR CLG-MOUNTED OWNER-FURNISHED EQUIPMENT
5. CLG-MOUNTED IV TRACK, REFER TO DETAIL #5/AI143; COORDINATE WITH BRACING FOR CLG-MOUNTED OWNER-FURNISHED EQUIPMENT
6. NORTH ONLY - STAINLESS STEEL HOOD, REFER TO DWG MH-123
7. BULKHEAD, REFER TO DETAIL #3/AI143
8. SOFFIT, REFER TO DETAIL #2/AI143
9. SOUTH ONLY - ABOVE CEILING FED WALL MTD PATIENT HEADWALL, RE: EQUIPMENT PLANS
10. SOUTH ONLY - CUT TILE TO ALIGN LIGHTS AS SHOWN
11. NOT USED
12. FRAMING FOR FUTURE EQUIPMENT BOOM, RE: STRUCTURAL (VOLUME 1)
13. NORTH ONLY - CEILING MOUNTED GAS OUTLETS - SEE PLAN FOR TYPE OF OUTLET.
14. NORTH ONLY - CEILING MOUNTED SURGERY LIGHT WITH VIDEO MONITOR RE: EQUIPMENT PLANS
15. NORTH ONLY - RELOCATED CEILING MOUNTED SURGERY LIGHT RE: EQUIPMENT PLANS
16. ALIGN NOTED SURFACES
17. NORTH ONLY - SOFFIT, RE: #4/AI143
18. SOUTH ONLY - CLG/CLG EXPANSION JOINT. SEE DETAIL #/AI511
19. SOUTH ONLY - MODIFY AND/OR INFILL EXISTING 2x4 CEILING GRID AND TILE AS REQUIRED. MATCH EXISTING.
20. MECHANICAL ACCESS PANEL. REFER TO MECHANICAL FOR EXACT LOCATION AND REQUIREMENTS.
21. NORTH ONLY - SOFFIT TO RESIST THE PASSAGE OF SMOKE, REFER TO DETAIL #6/AI143
22. SOUTH ONLY - EXISTING PHYSIO MONITORS CEILING MOUNTED ON TILTING ADJUSTABLE BRACKET
23. SOUTH ONLY - FUTURE PHYSIO MONITORS
24. NORTH ONLY - HOLD CEILING TO JUST BELOW THE FIREPROOFED STRUCTURE IN STAIRWELLS
25. NORTH ONLY - BULKHEAD AROUND ROOF ACCESS STAIR AT 2' BELOW FINISH CEILING, REFER TO DETAIL #3/AI143.
26. SOUTH ONLY - REFER TO DETAIL #8 & #12/AI511 FOR CEILING CONDITION AT NEW OPENINGS.
27. PAINT CEILING P-2 AT NOTED ROOMS
28. SOUTH ONLY - CEILING MOUNTED CAMERA MONITORED AT NURSE STATION 320. REFER TO ELECT., WITH 8-IN BY 8-IN ACCESS PANEL ADJACENT TO CAMERA. REFER TO SPECS.
29. NORTH ONLY - GWB CEILING CONTROL JOINT
30. NORTH ONLY - 2-INCH CEILING TO CEILING EXPANSION JOINT

ASI-32R

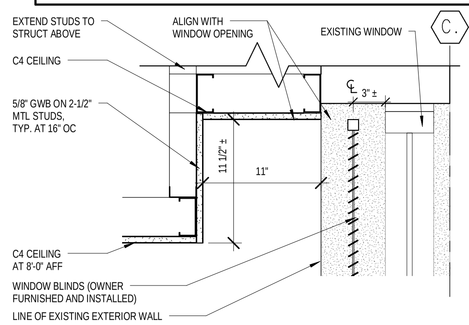

6 DETAIL AT WINDOW POCKET
1 1/2" = 1'-0"

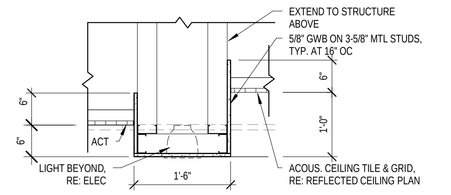

PACU N. STA. BULKHEAD DETAIL
7 3/4" = 1'-0"

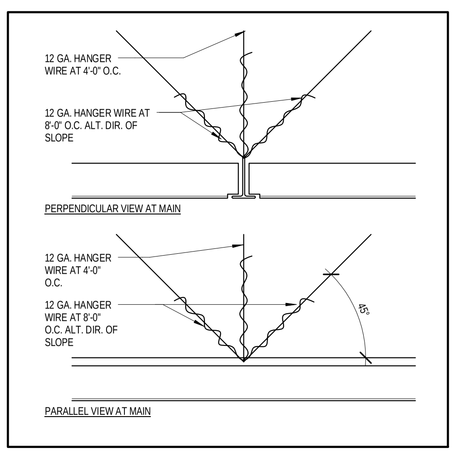

2 TYP. DETAIL AT MAIN RUNNER
1/2" = 1'-0"

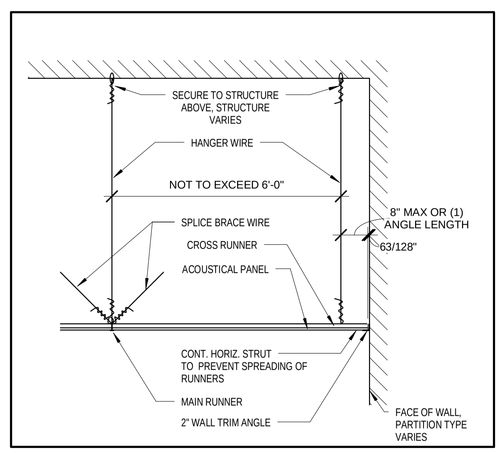

3 TYPICAL SUSPENDED CEILING AT WALL OR BULKHEAD
1/2" = 1'-0"

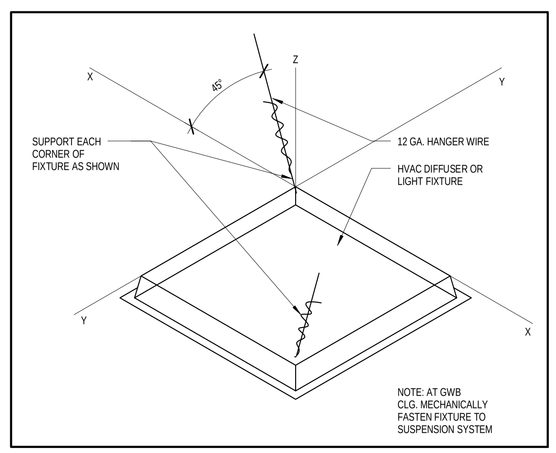

4 TYPICAL HVAC/LIGHT FIXTURE SUPPORT DETAIL
1/2" = 1'-0"

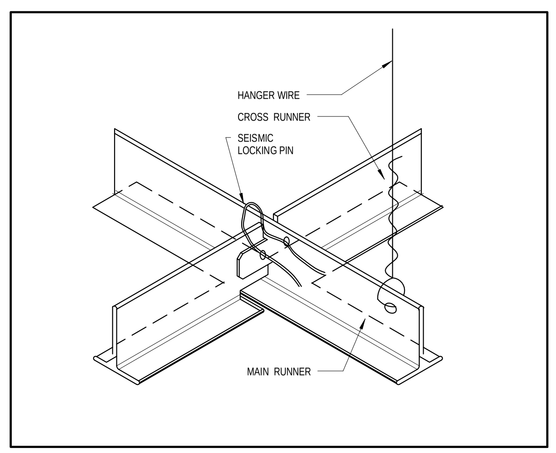

5 TYPICAL LOCKING CLIP TO FASTEN RUNNERS
1/2" = 1'-0"

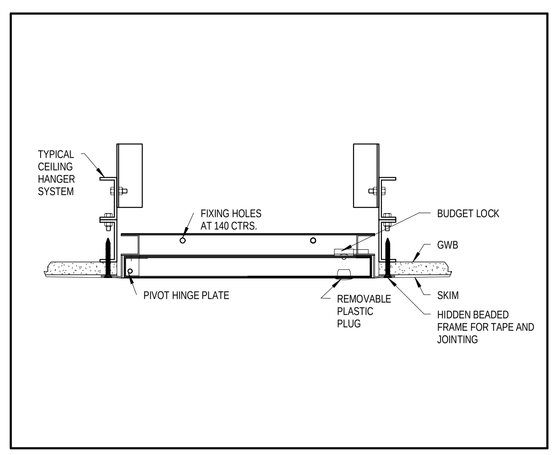

8 TYPICAL ACCESS PANEL DETAIL
3" = 1'-0"

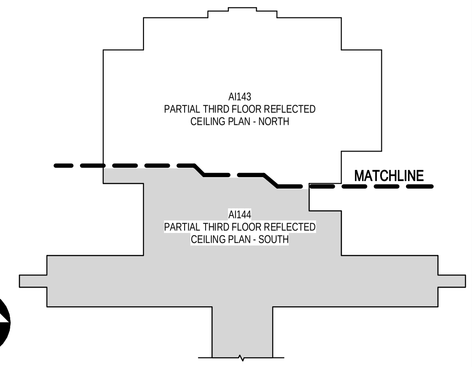

VOL. 3 - REVISED AS-BUILT

	Revisions:	Date:
	OWNER REQUESTED ITEMS NOT YET ACCEPTED	
1	ICU REVISION	12/20/10
2	RATED WALL SEPARATION REVISION	01/07/11
3	MISCELLANEOUS REVISION	01/28/11
4	SURGERY & MISC. REVISION	04/08/11
5	RESPONSE TO RFI's	02/08/11
6	IN-FIELD COORDINATION	03/08/11
7	AS-BUILT CONDITIONS	09/09/2011

CONSULTANTS:

ARCHITECT/ENGINEERS:

NEENAN architruction®
2620 East Prospect Road, Suite 100, Fort Collins, Colorado 80525
(970) 493-8747 Fax: (970) 493-5869

Ross&Baruzzini
6 SOUTH OLD ORCHARD
WEBSTER GROVES, MO 63119
T: 314-918-8383

Drawing Title: PARTIAL THIRD FLOOR REFLECTED CEILING PLAN - SOUTH

Approved: Project Director

Project Title: 3RD FLOOR ADDITION FOR SURGERY CENTER, PACU, SPD & ICU

Location: VETERANS AFFAIRS MEDICAL CENTER, GRAND JUNCTION, CO

Date: 09/09/2011 | Checked: SDM | Drawn: MAW

Project Number: 515-25-005

Building Number: BUILDING NO. 1

Drawing Number: AI144

Office of Construction and Facilities Management
Department of Veterans Affairs

VA FORM 08-6231