


8yd □ 4
 30yd 3
 42yd 1
 40yd 1
 35yd 1

polytrauma
area

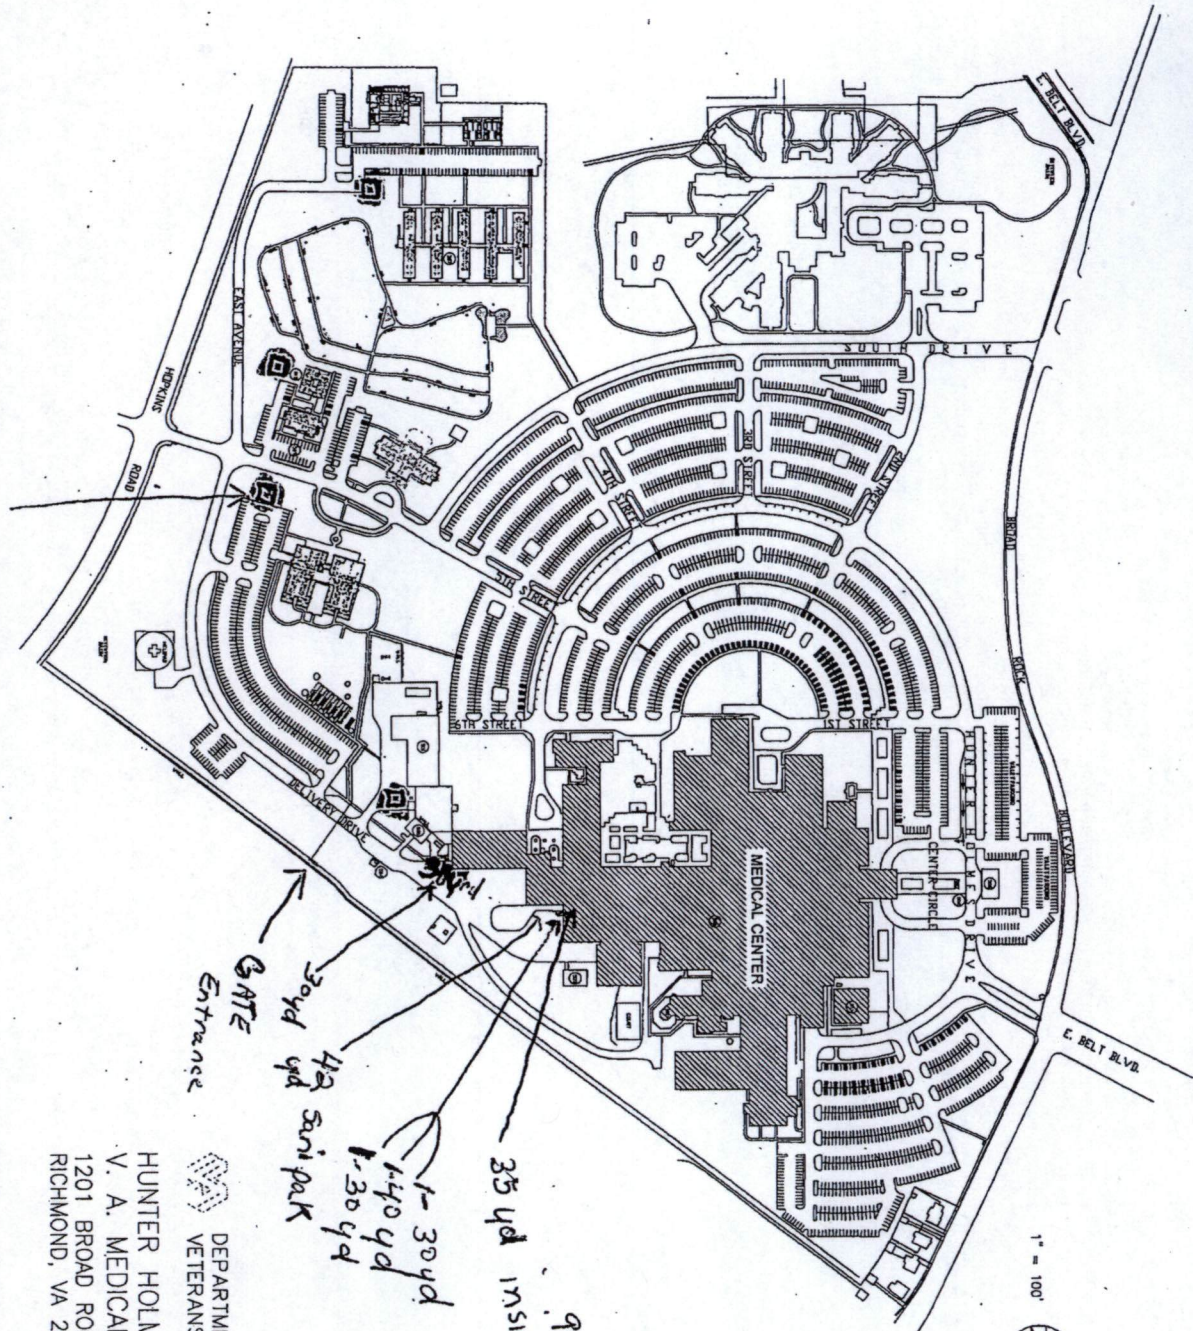

DEPARTMENT OF
 VETERANS AFFAIRS

HUNTER HOLMES MCGUIRE
 V. A. MEDICAL CENTER
 1201 BROAD ROCK BLVD.
 RICHMOND, VA 23249

GATE
 Entrance

1-30yd
 1-40yd
 1-30yd
 35yd
 42yd
 30yd
 Sanit pack

garage doors
 inside bldg

