
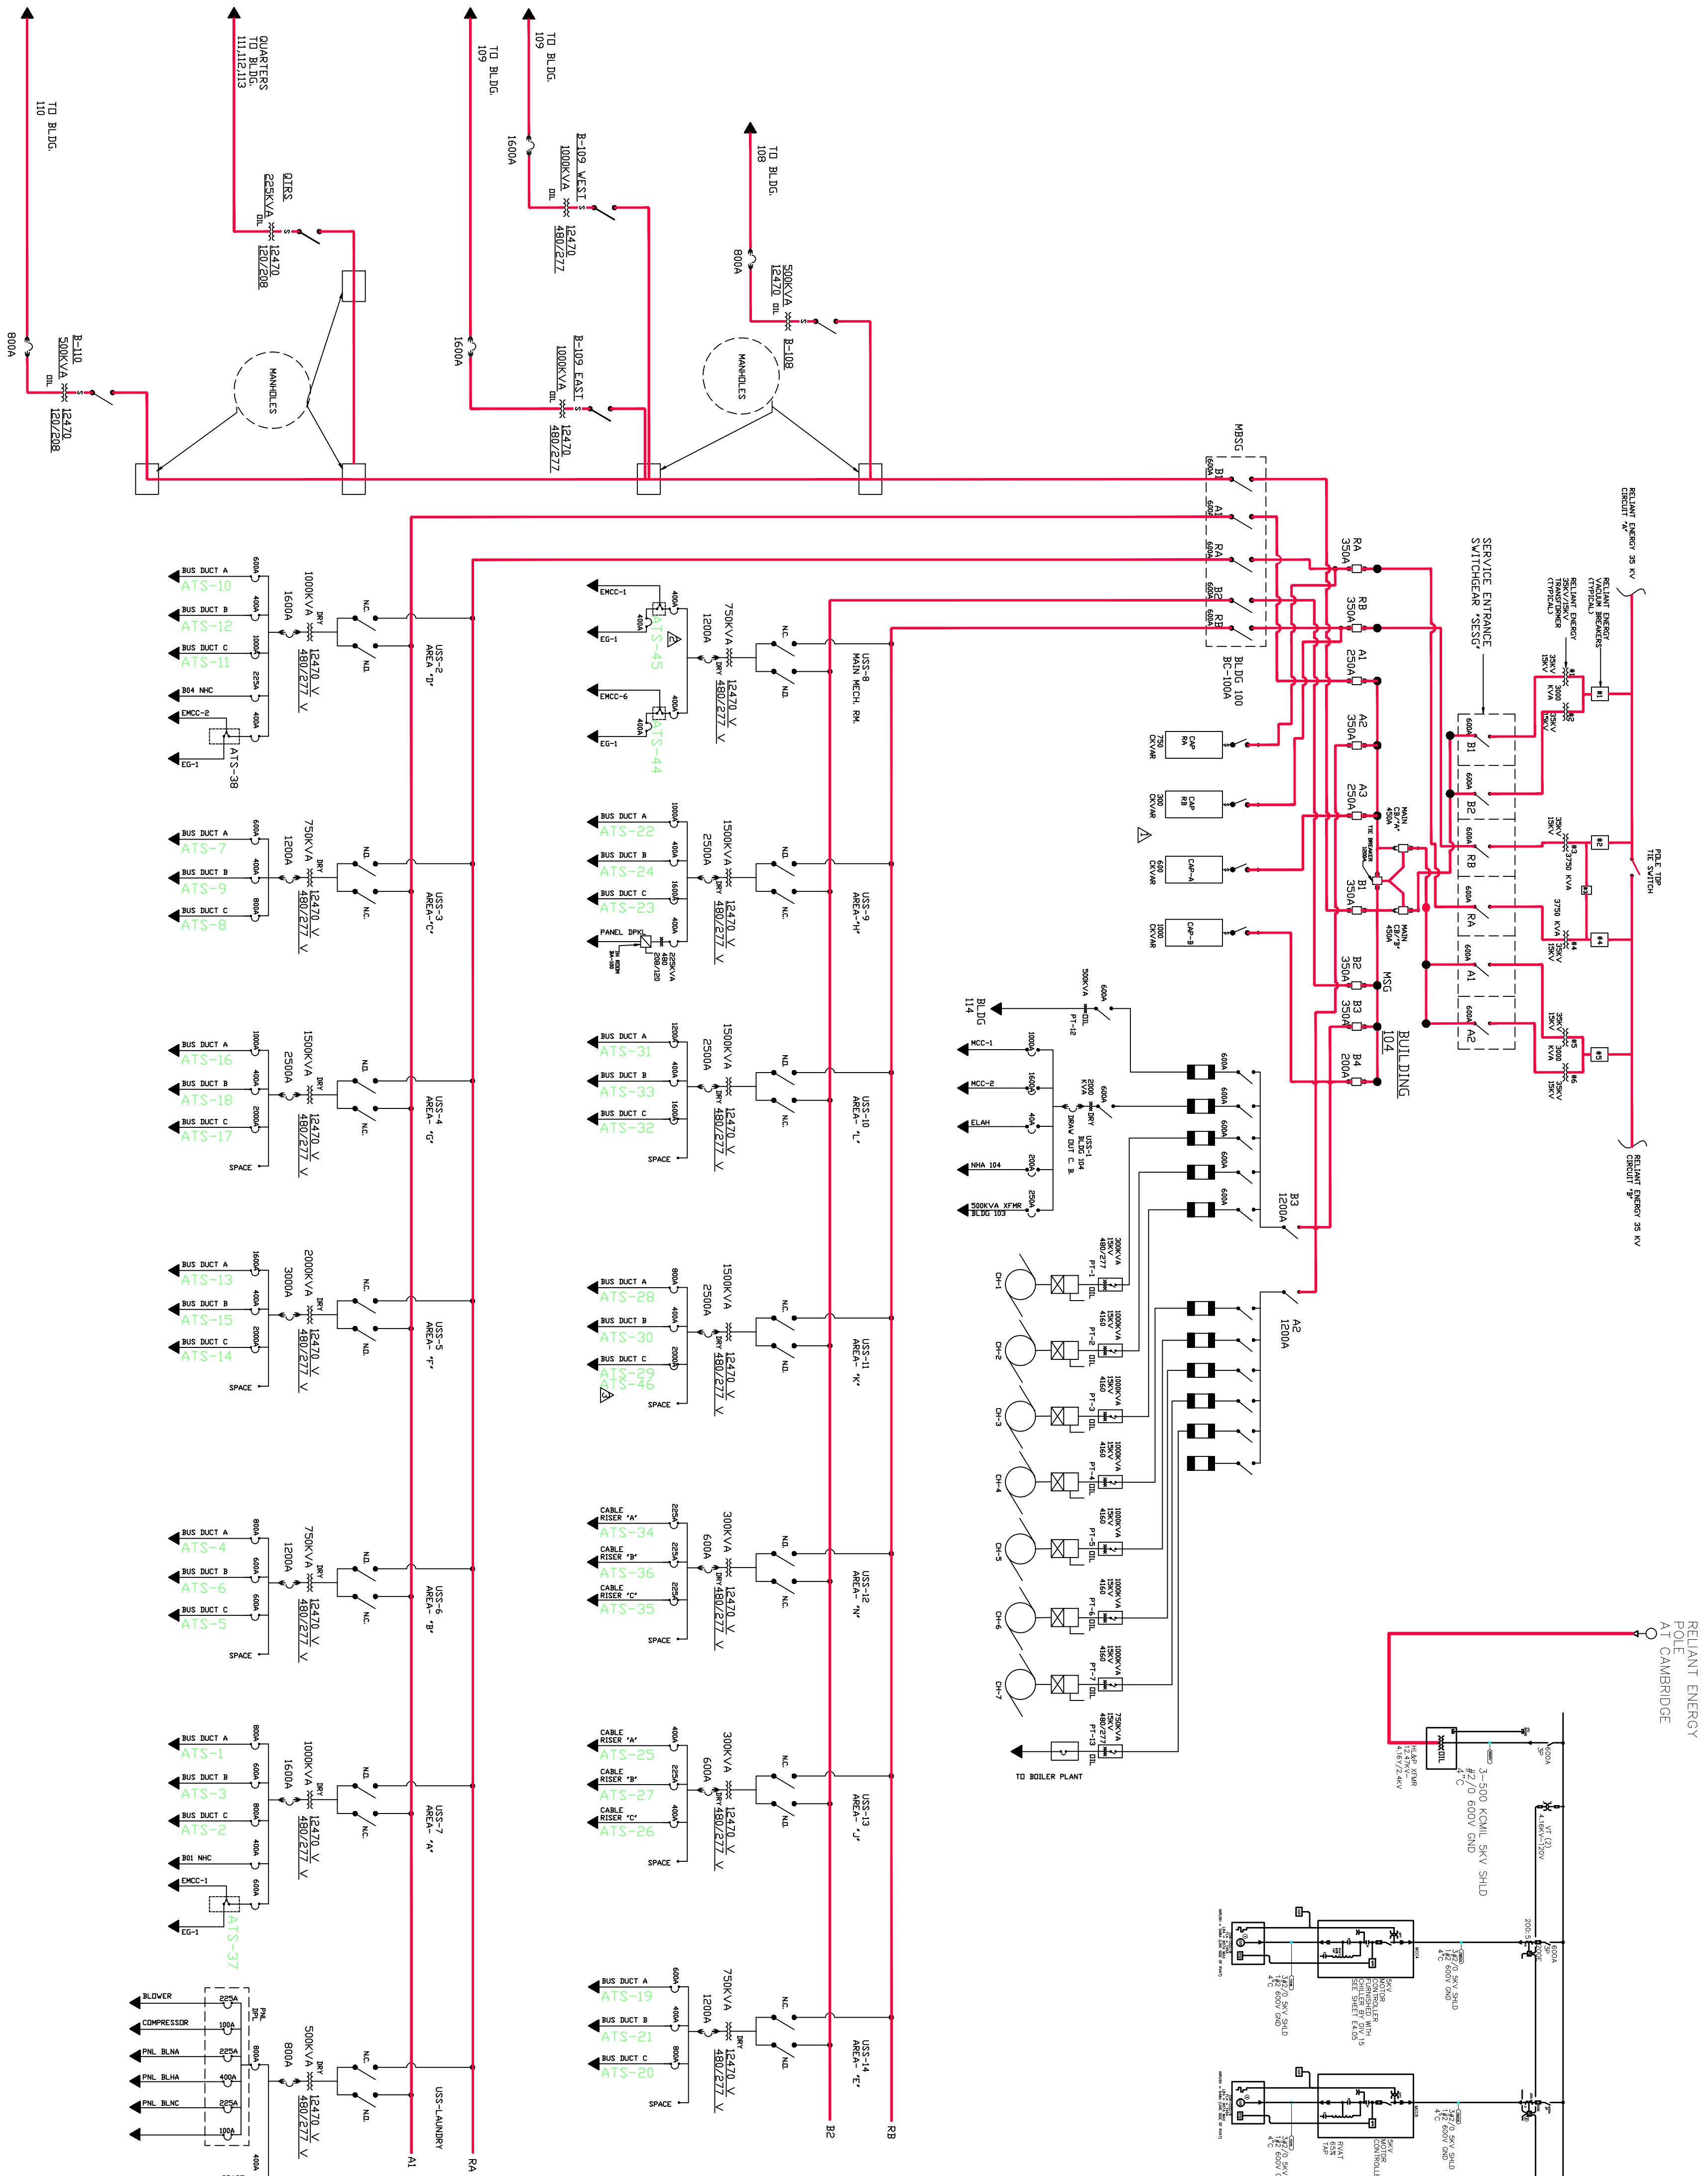


DATE	ITEM	REVISIONS
5/18/04	Δ	CONNECTION MARK
7/13/04	Δ	REDESIGN GAS
11/1/05	Δ	REDESIGN POWER
	Δ	ATS 46 SUBMITTAL

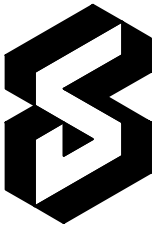

		PROJECT NAME:	
PROJECT NUMBER:		LOCATION: MICHAEL E. DEANEY VAMC	
APPROVED: CHER. CONNELLION MICHAEL E. DEANEY		APPROVED: CHIEF, HOWARD GIBSON	
APPROVED: SERVICE CHIEF		DATE: 11/30/2008	
SCALE: NTS		DRAWN BY: NGF	
		PAGE NO. E-108	