

# LEGEND

- BOLLARD
- WATER VALVE
- MANHOLE
- FIRE HYDRANT
- CLEAN OUT
- VENT PIPE
- WATER LINE PER ACCUMARK MARKOUT
- GAS LINE PER ACCUMARK MARKOUT
- SANITARY SEWER LINE PER ACCUMARK MARKOUT
- FUEL LINE PER ACCUMARK MARKOUT
- STEAM LINE (PER REF. MAP # 1)
- GAS LINE (PER REF. MAP # 3)
- SANITARY SEWER LINE (PER REF. MAP # 3)
- ELECTRIC LINE (PER REF. MAP # 3)
- STORM DRAINAGE LINE (PER REF. MAP # 3)
- WATER LINE (PER REF. MAP # 3)
- FUEL LINE (PER REF. MAP # 3)
- NEW GAS LINE (PER REF. # 2)
- SANITARY SEWER LINE (PER REF. MAP # 2)
- DIESEL FUEL SUPPLY LINE (PER REF. MAP # 2)
- DIESEL FUEL RETURN LINE (PER REF. MAP # 2)
- CONTOUR LINE (MAJOR)
- CONTOUR LINE (MINOR)
- GEOTECH AREA

CP-21  
MAGNAIL SET  
ELEV. 521.69

CP-20  
MAGNAIL SET  
ELEV. 517.62

## GENERAL NOTES:



- NO DETERMINATIONS HAVE BEEN MADE REGARDING HAZARDOUS MATERIAL CONDITIONS.
- NO DETERMINATIONS HAVE BEEN MADE REGARDING FRESHWATER WETLANDS LOCATIONS.
- PLANIMETRIC AND TOPOGRAPHIC FEATURES SHOWN HEREON ARE DRAWN IN ACCORDANCE WITH SURVEY PERFORMED ON THE GROUND BY TAM ASSOCIATES, MAY 17, 2012. HORIZONTAL DATUM IS NORTH AMERICA DATUM (N.A.D. 1983), VERTICAL DATUM IS NORTH AMERICAN VERTICAL DATUM (N.A.V.D. 1985).
- EXISTING UTILITY INFORMATION SHOWN HEREON HAS BEEN COLLECTED FROM A UTILITY MARKOUT PERFORMED BY ACCUMARK, APRIL, 2012 AND IS NOT GUARANTEED AS TO ACCURACY OR COMPLETENESS. THE CONTRACTOR SHALL VERIFY ALL INFORMATION TO HIS SATISFACTION PRIOR TO EXCAVATION. WHERE EXISTING UTILITIES ARE TO BE CROSSED BY PROPOSED CONSTRUCTION, TEST PITS SHALL BE DUG BY THE CONTRACTOR PRIOR TO CONSTRUCTION TO ASCERTAIN EXISTING INVERTS, MATERIALS AND SIZES. TEST PIT INFORMATION SHALL BE GIVEN TO THE ENGINEER PRIOR TO CONSTRUCTION TO PERMIT ADJUSTMENTS AS REQUIRED TO AVOID CONFLICTS.
- THIS PLAN DOES NOT INCLUDE PARKING OR HANDICAPPED PARKING STRIPING.
- PIPES NOTED AS PER ACCUMARK REF. MAP NO. 1 ARE FROM RECORD INFORMATION AND WERE NOT DETECTED IN THE FIELD.

## REFERENCE MAPS:

- UTILITY DESIGNATING FIELD SHEET, VETERAN'S ADMINISTRATION MEDICAL CENTER, BEHIND UTILITY BUILDING, LEBANON, PENNSYLVANIA, PREPARED BY ACCUMARK, SUBSURFACE UTILITY SERVICES, DATED MAY, 2012.
- UTILITY LOCATIONS PROVIDED BY MILLER-REMICK, SITE PLAN, UTILITY LINE LOCATIONS, VETERAN'S AFFAIRS MEDICAL CENTER, LEBANON, PENNSYLVANIA, DATED OCTOBER 10, 1995, REVISED TO JULY 8, 2009.
- PARTIAL SITE PLAN, U.S. VETERAN'S ADMINISTRATION MEDICAL CENTER, AFBC CO-FIRING OF COAL AND HOSPITAL WASTES, SOUTH LEBANON TOWNSHIP, LEBANON COUNTY, PENNSYLVANIA, PREPARED BY SKELLY AND LOY INC., DATED MARCH 15, 1991.

## BENCHMARKS:

- BOX-CUT SET IN CONCRETE BASE OF LIGHTPOLE #91. ELEV. 521.02
- BOX-CUT SET IN CONCRETE BASE OF LIGHTPOLE #100. ELEV. 520.62

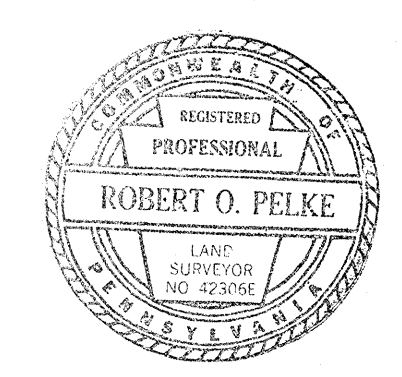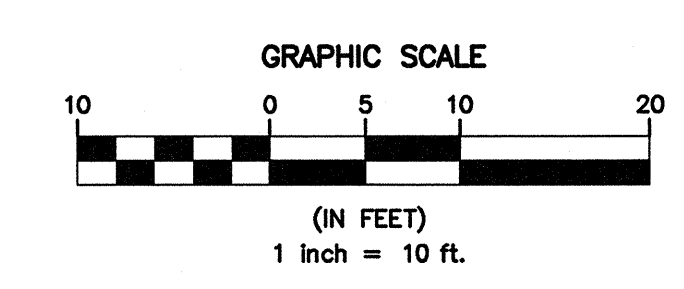

NO.	DATE	REVISIONS	BY	CHECKED
MILLER REMICK, LLC				
VETERANS ADMINISTRATION MEDICAL CENTER LEBANON, PENNSYLVANIA				
TOPOGRAPHIC SURVEY				
ROBERT O. PELKE, P.E., P.L.S.		DRAWING		
531 PLYMOUTH ROAD SUITE 510 PLYMOUTH MEETING, PA 19462 TEL 484-530-1270		DATE 5/4/2012 DESIGNED BY NEZ PROJECT NO. MIRC-00030 DRAWN BY BRM/WS CADD FILE CHECKED BY NEZ/ROP FIELD BKG. MSC-101		
FILE NAME: H:\MIRC\00030\Survey\MIRC30 VAMC BASE.dwg PLOT DATE: May 29, 2012 - 10:39am		SHEET 1 OF 1		

COPYRIGHT 2012, TAM ASSOCIATES - ALL RIGHTS RESERVED. NO PART OF THIS DOCUMENT MAY BE REPRODUCED OR TRANSMITTED IN ANY FORM OR BY ANY MEANS, WITHOUT THE WRITTEN PERMISSION OF TAM ASSOCIATES. IT IS PROHIBITED.