


3A

— WALL PROTECTION LOCATIONS

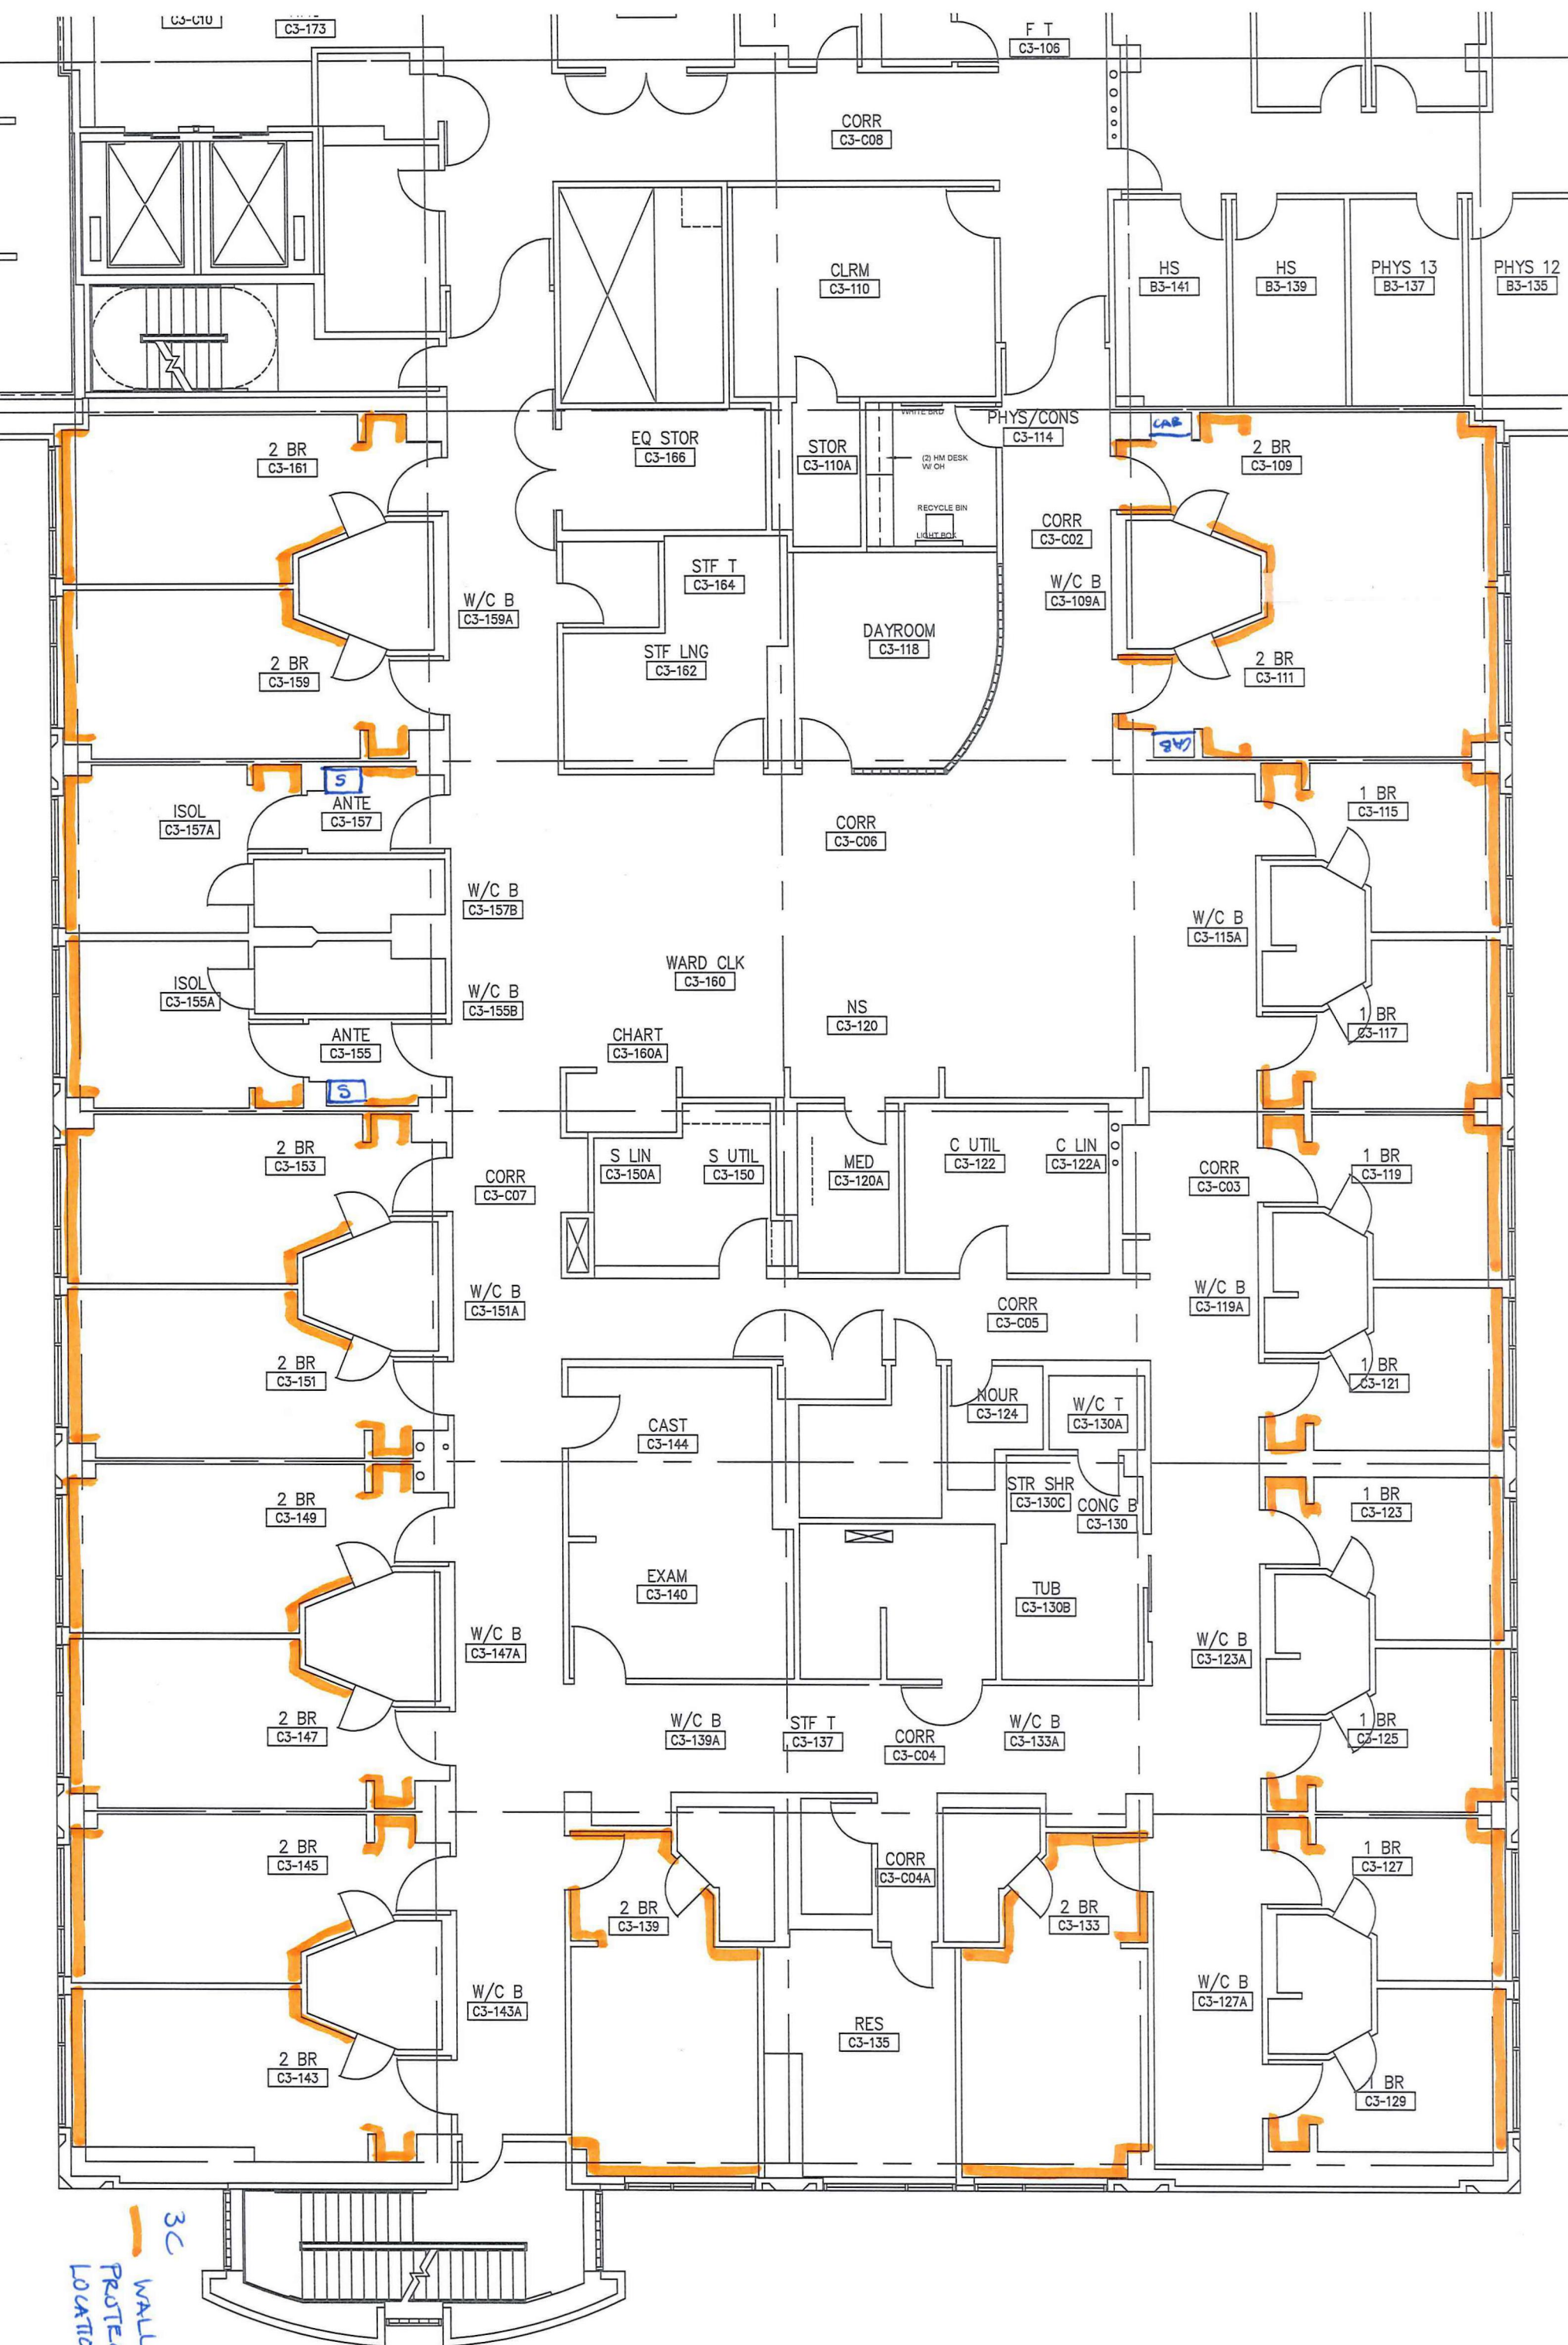

3C
— WALL PROTECTION LOCATIONS