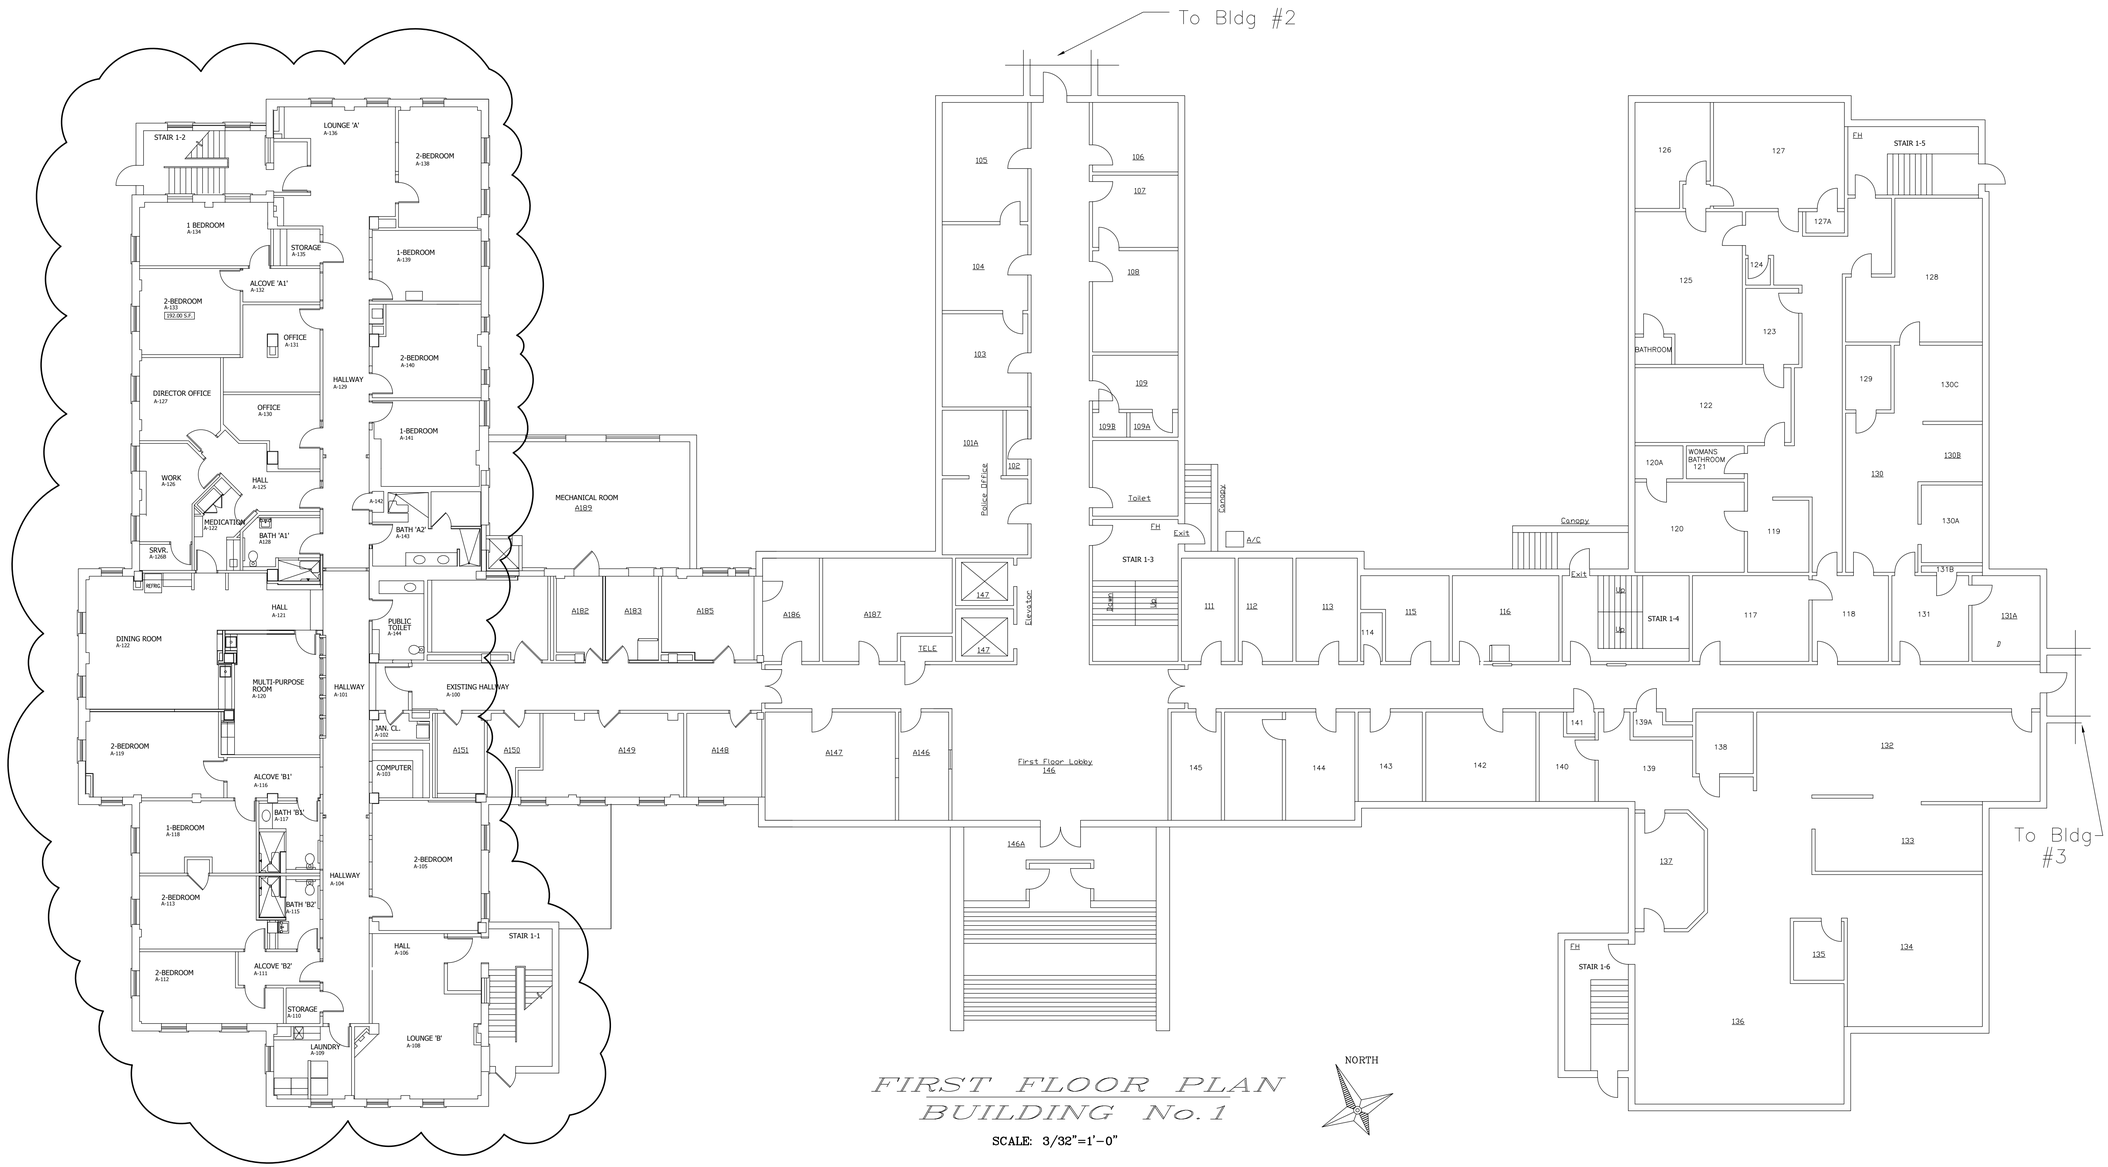

FIRST FLOOR PLAN
BUILDING No.1

SCALE: 3/32"=1'-0"

VETERANS ADMINISTRATION MEDICAL CENTER

222 RICHMOND AVENUE BATAVIA, NEW YORK 14020