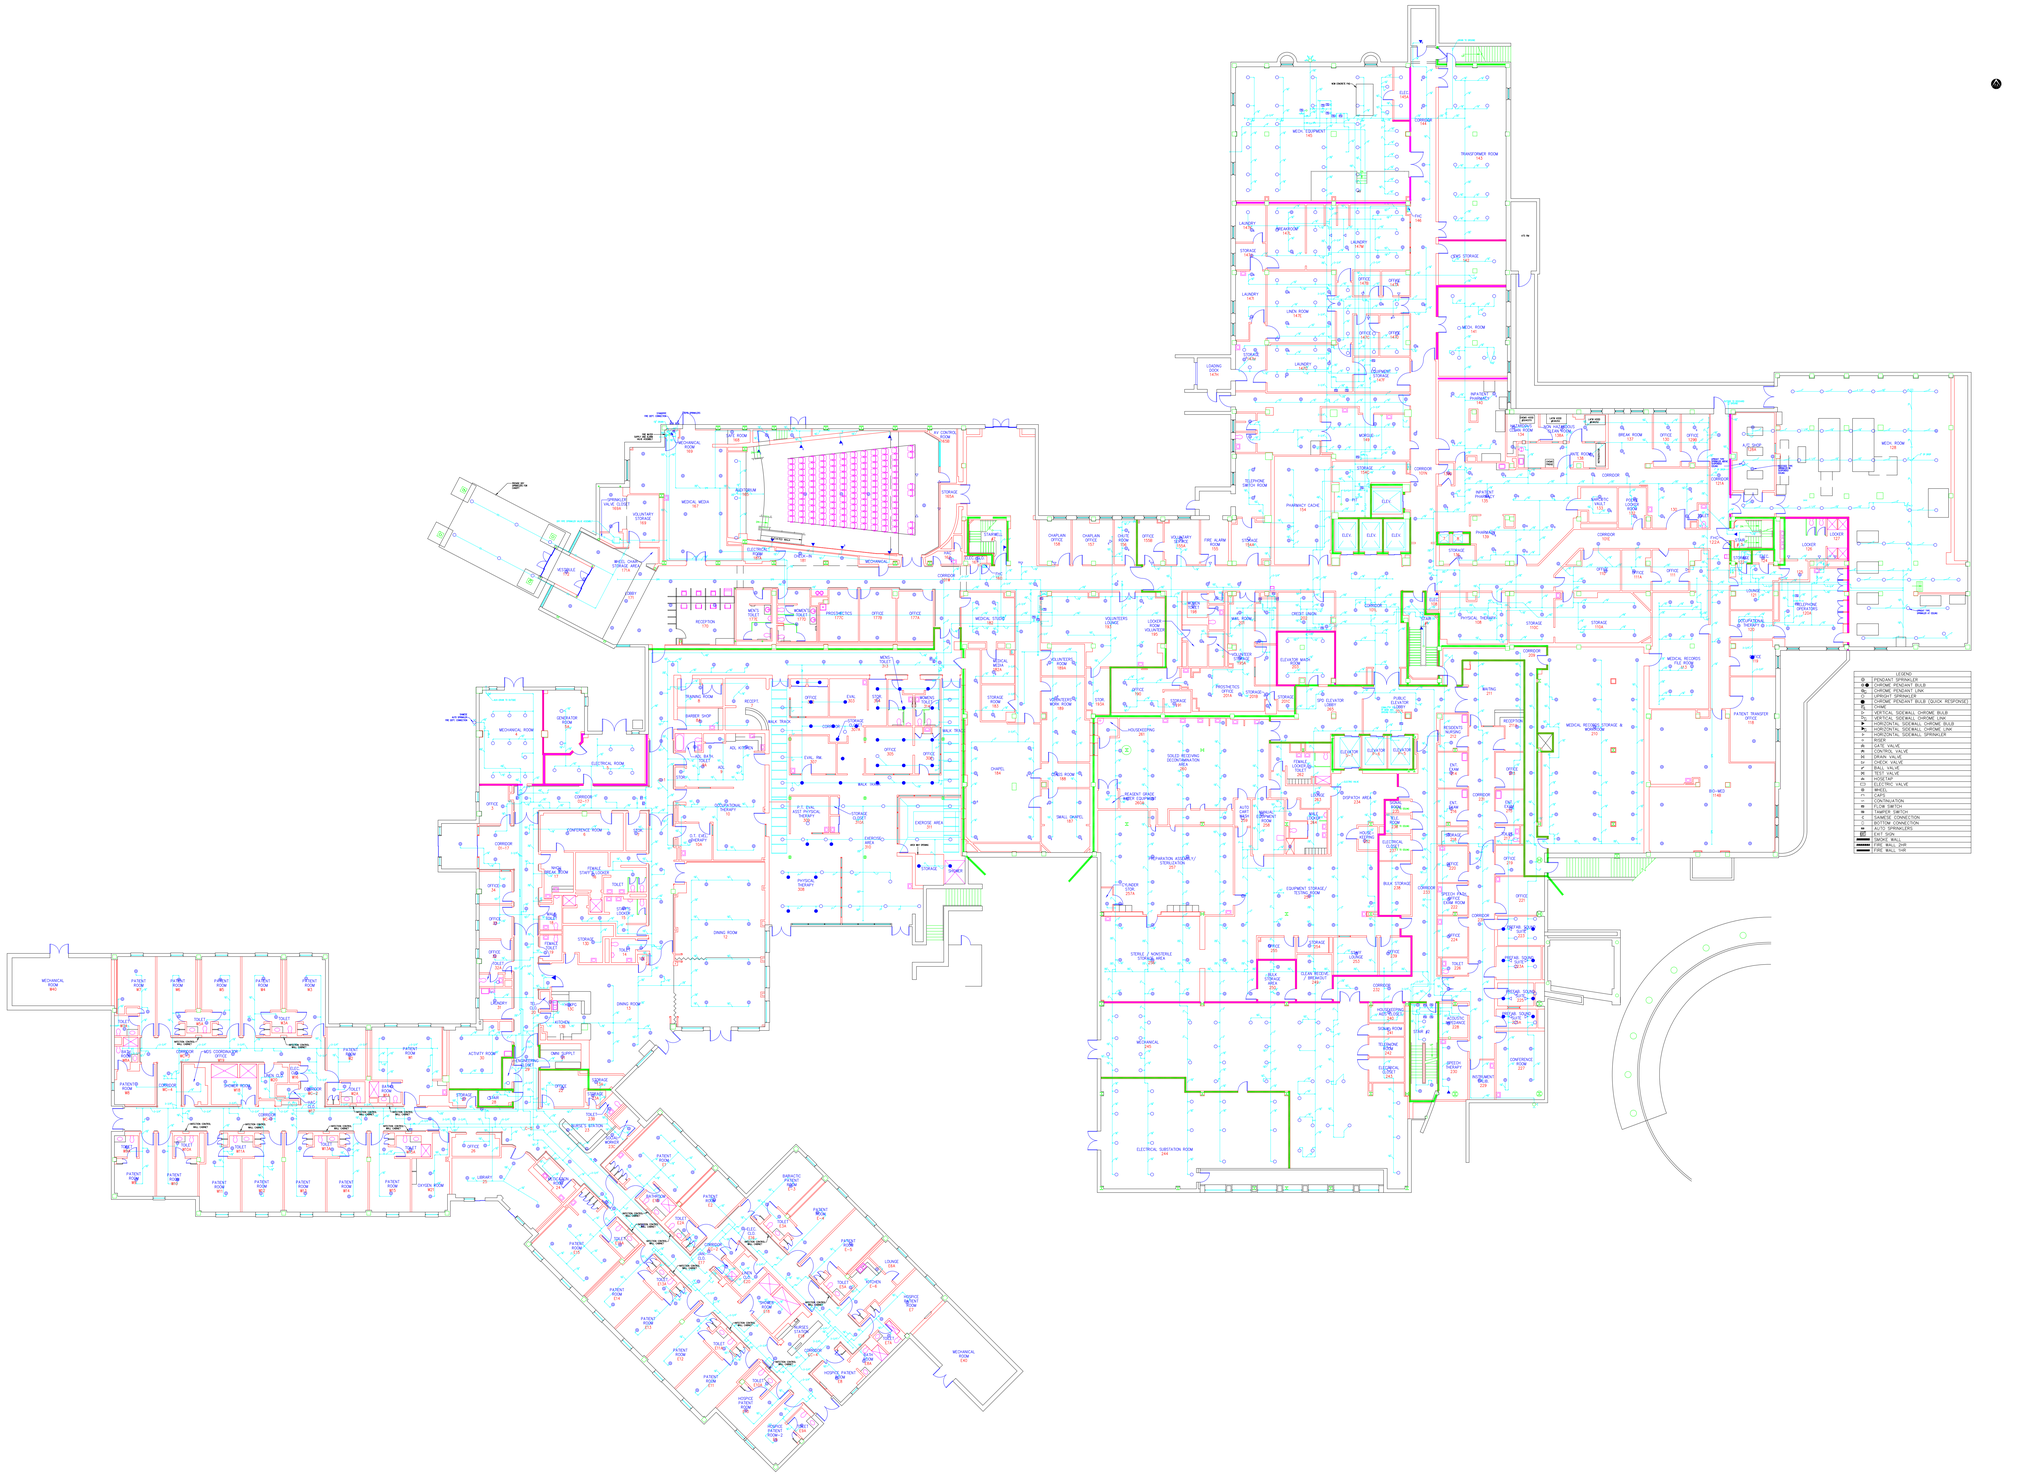

Revisions	Date

Professional Seal

Indus Systems, Inc.
2352, Main Street, Concord MA 01742
Tel: 978-461-0555
www.indus-systems.com

Drawing Title	GROUND FLOOR PLAN SPRINKLER PIPING
Project Title	AS-BUILT Drawings
Date	08-24-2017
Project No.	
Approved:	
Building Number	01
Checked	
Drawn	
Drawing No.	
Approved:	
Location	VAMC WILMINGTON DELAWARE

VAMC, WILMINGTON

VA Department of Veterans Affairs

VA FORM 08-6231, OCT 1978